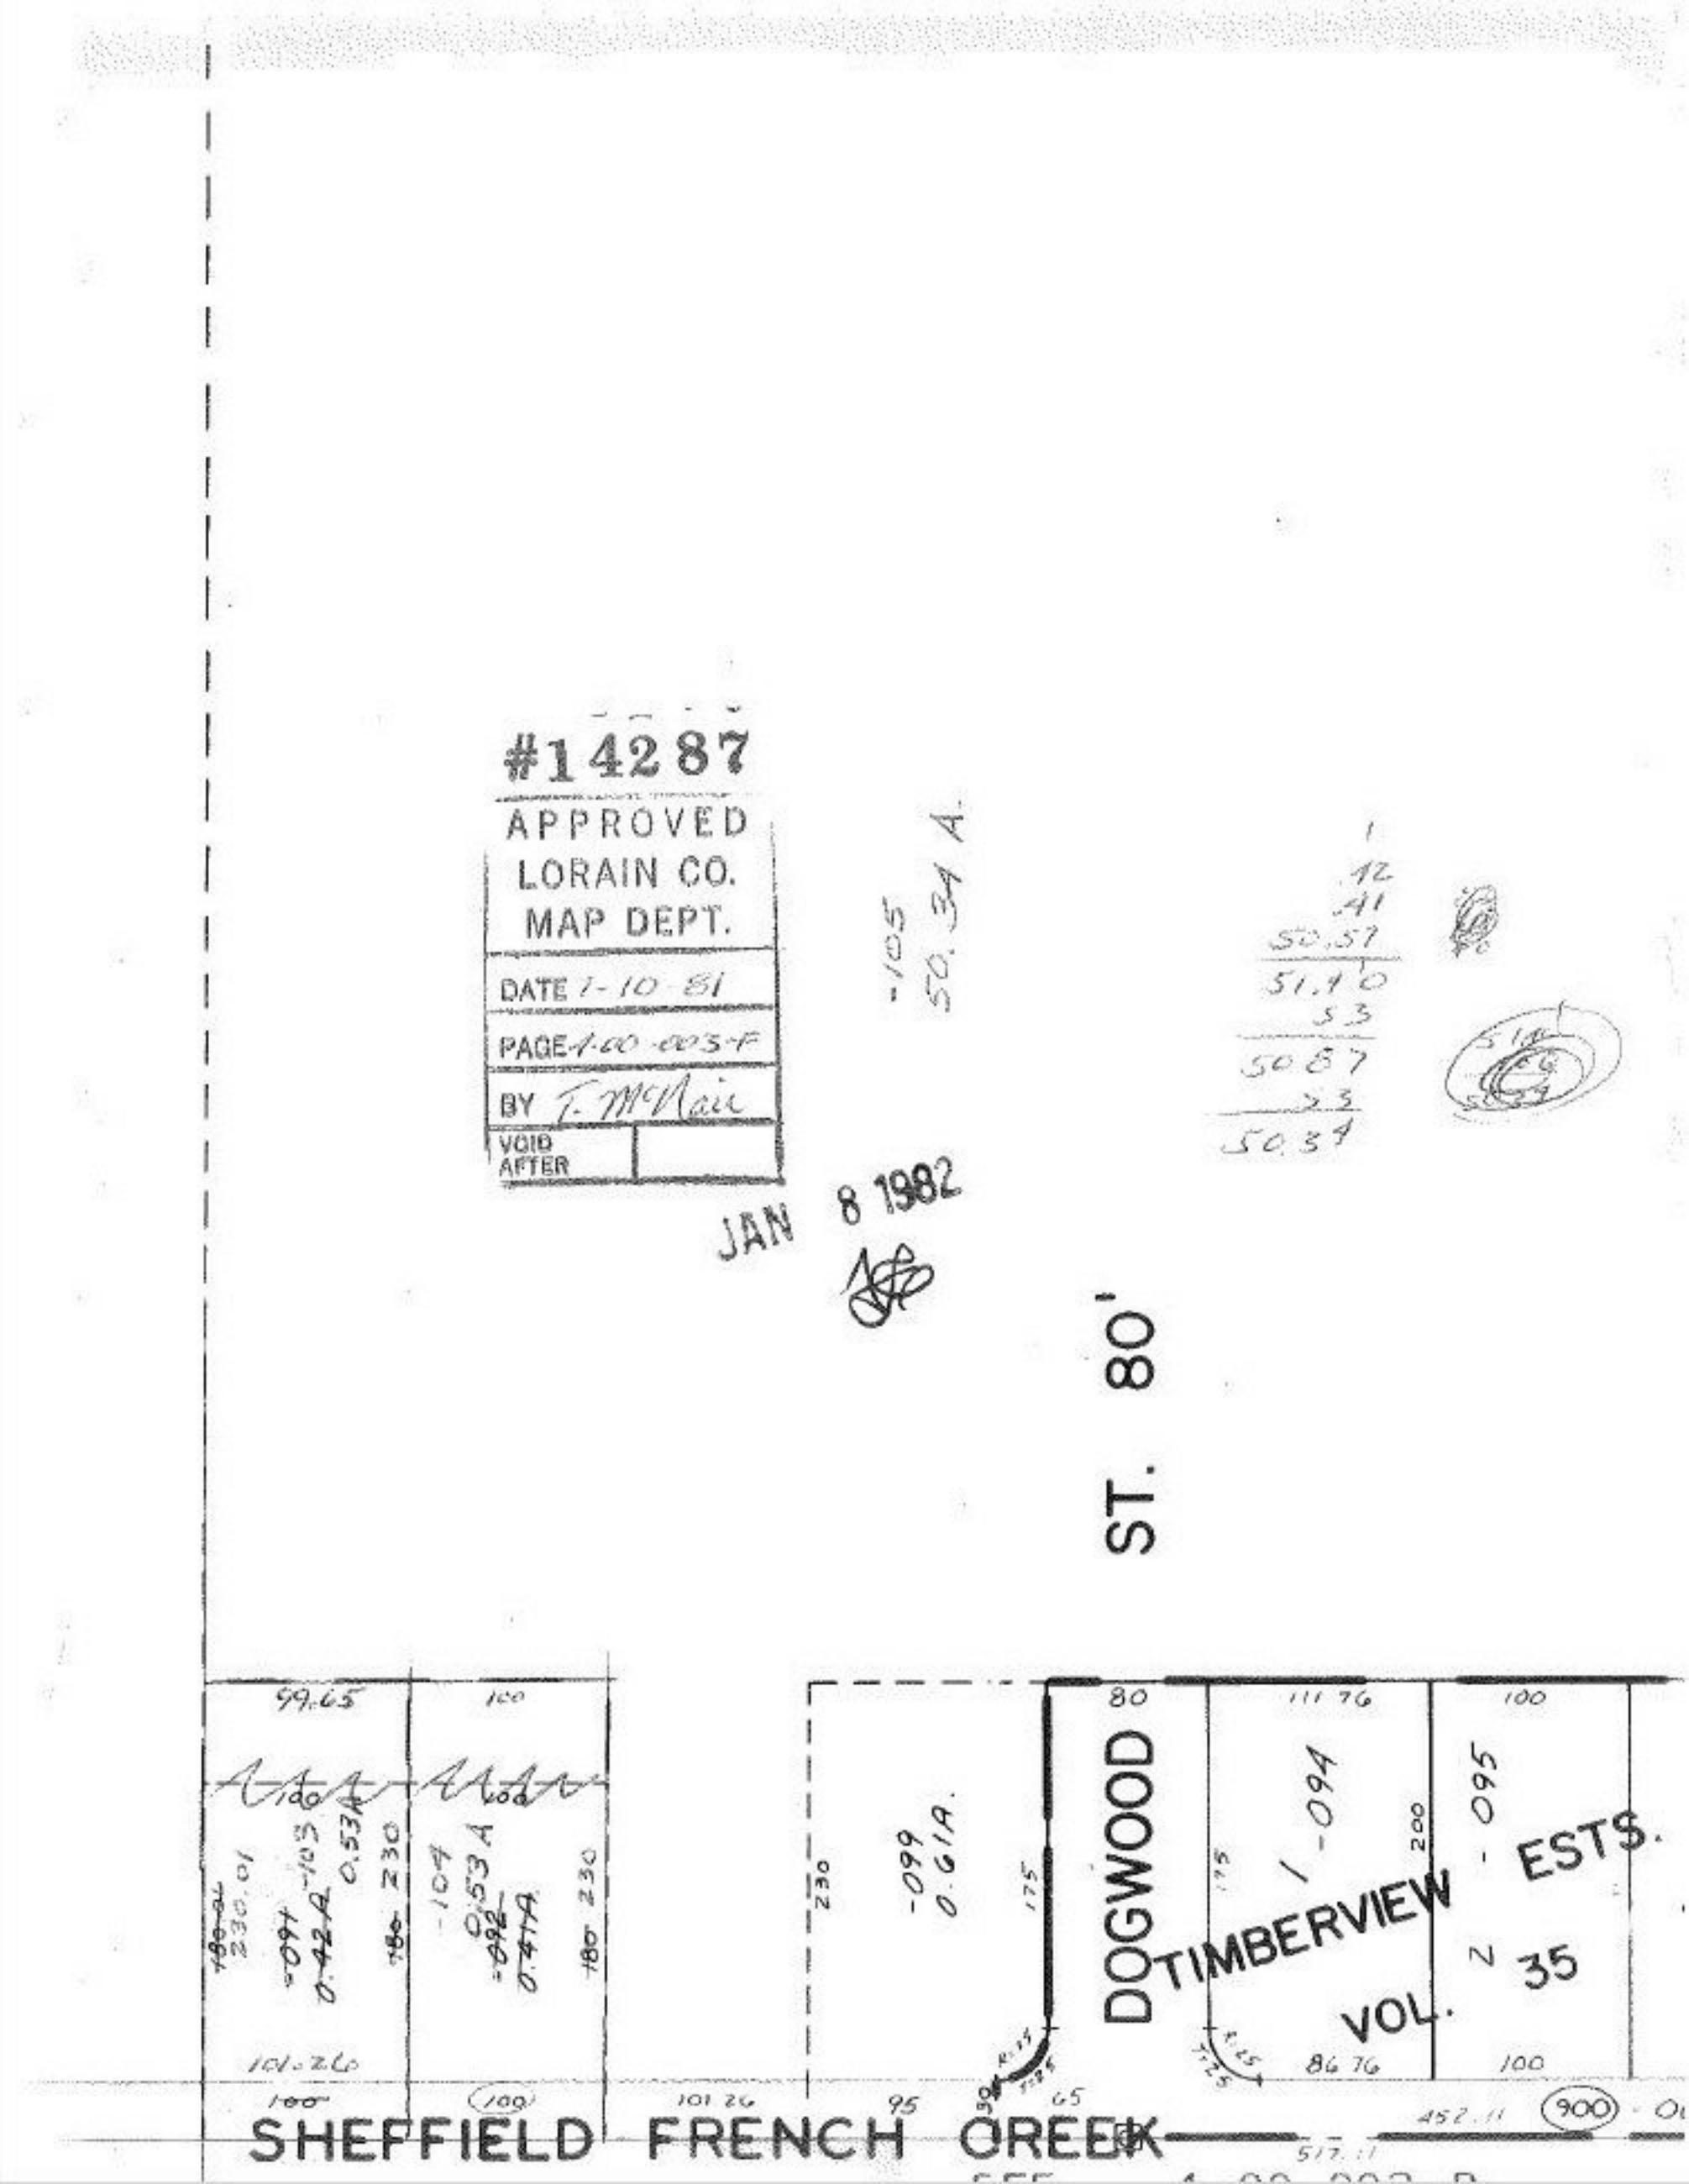
#14287
APPROVED
LORAIN CO.
MAP DEPT.
DATE 1-10-81
PAGE 1-00-003-F
BY T. McNair
VOID AFTER
JAN 8 1982
-105
50.34 A.
1
.42
.41
50.57
51.40
.53
50.87
.53
50.34
ST. 80'
DOGWOOD
TIMBERVIEW ESTS.
VOL. 35
SHEFFIELD FRENCH CREEK
99.65
100
230.01
-091
0.42A
-103
0.53A
230
-104
0.53 A
-092
0.41A
230
-099
0.61A.
80
111.76
100
1-094
-095
200
86.76
100
101.26
100
101.26
95
65
452.11
900
517.11