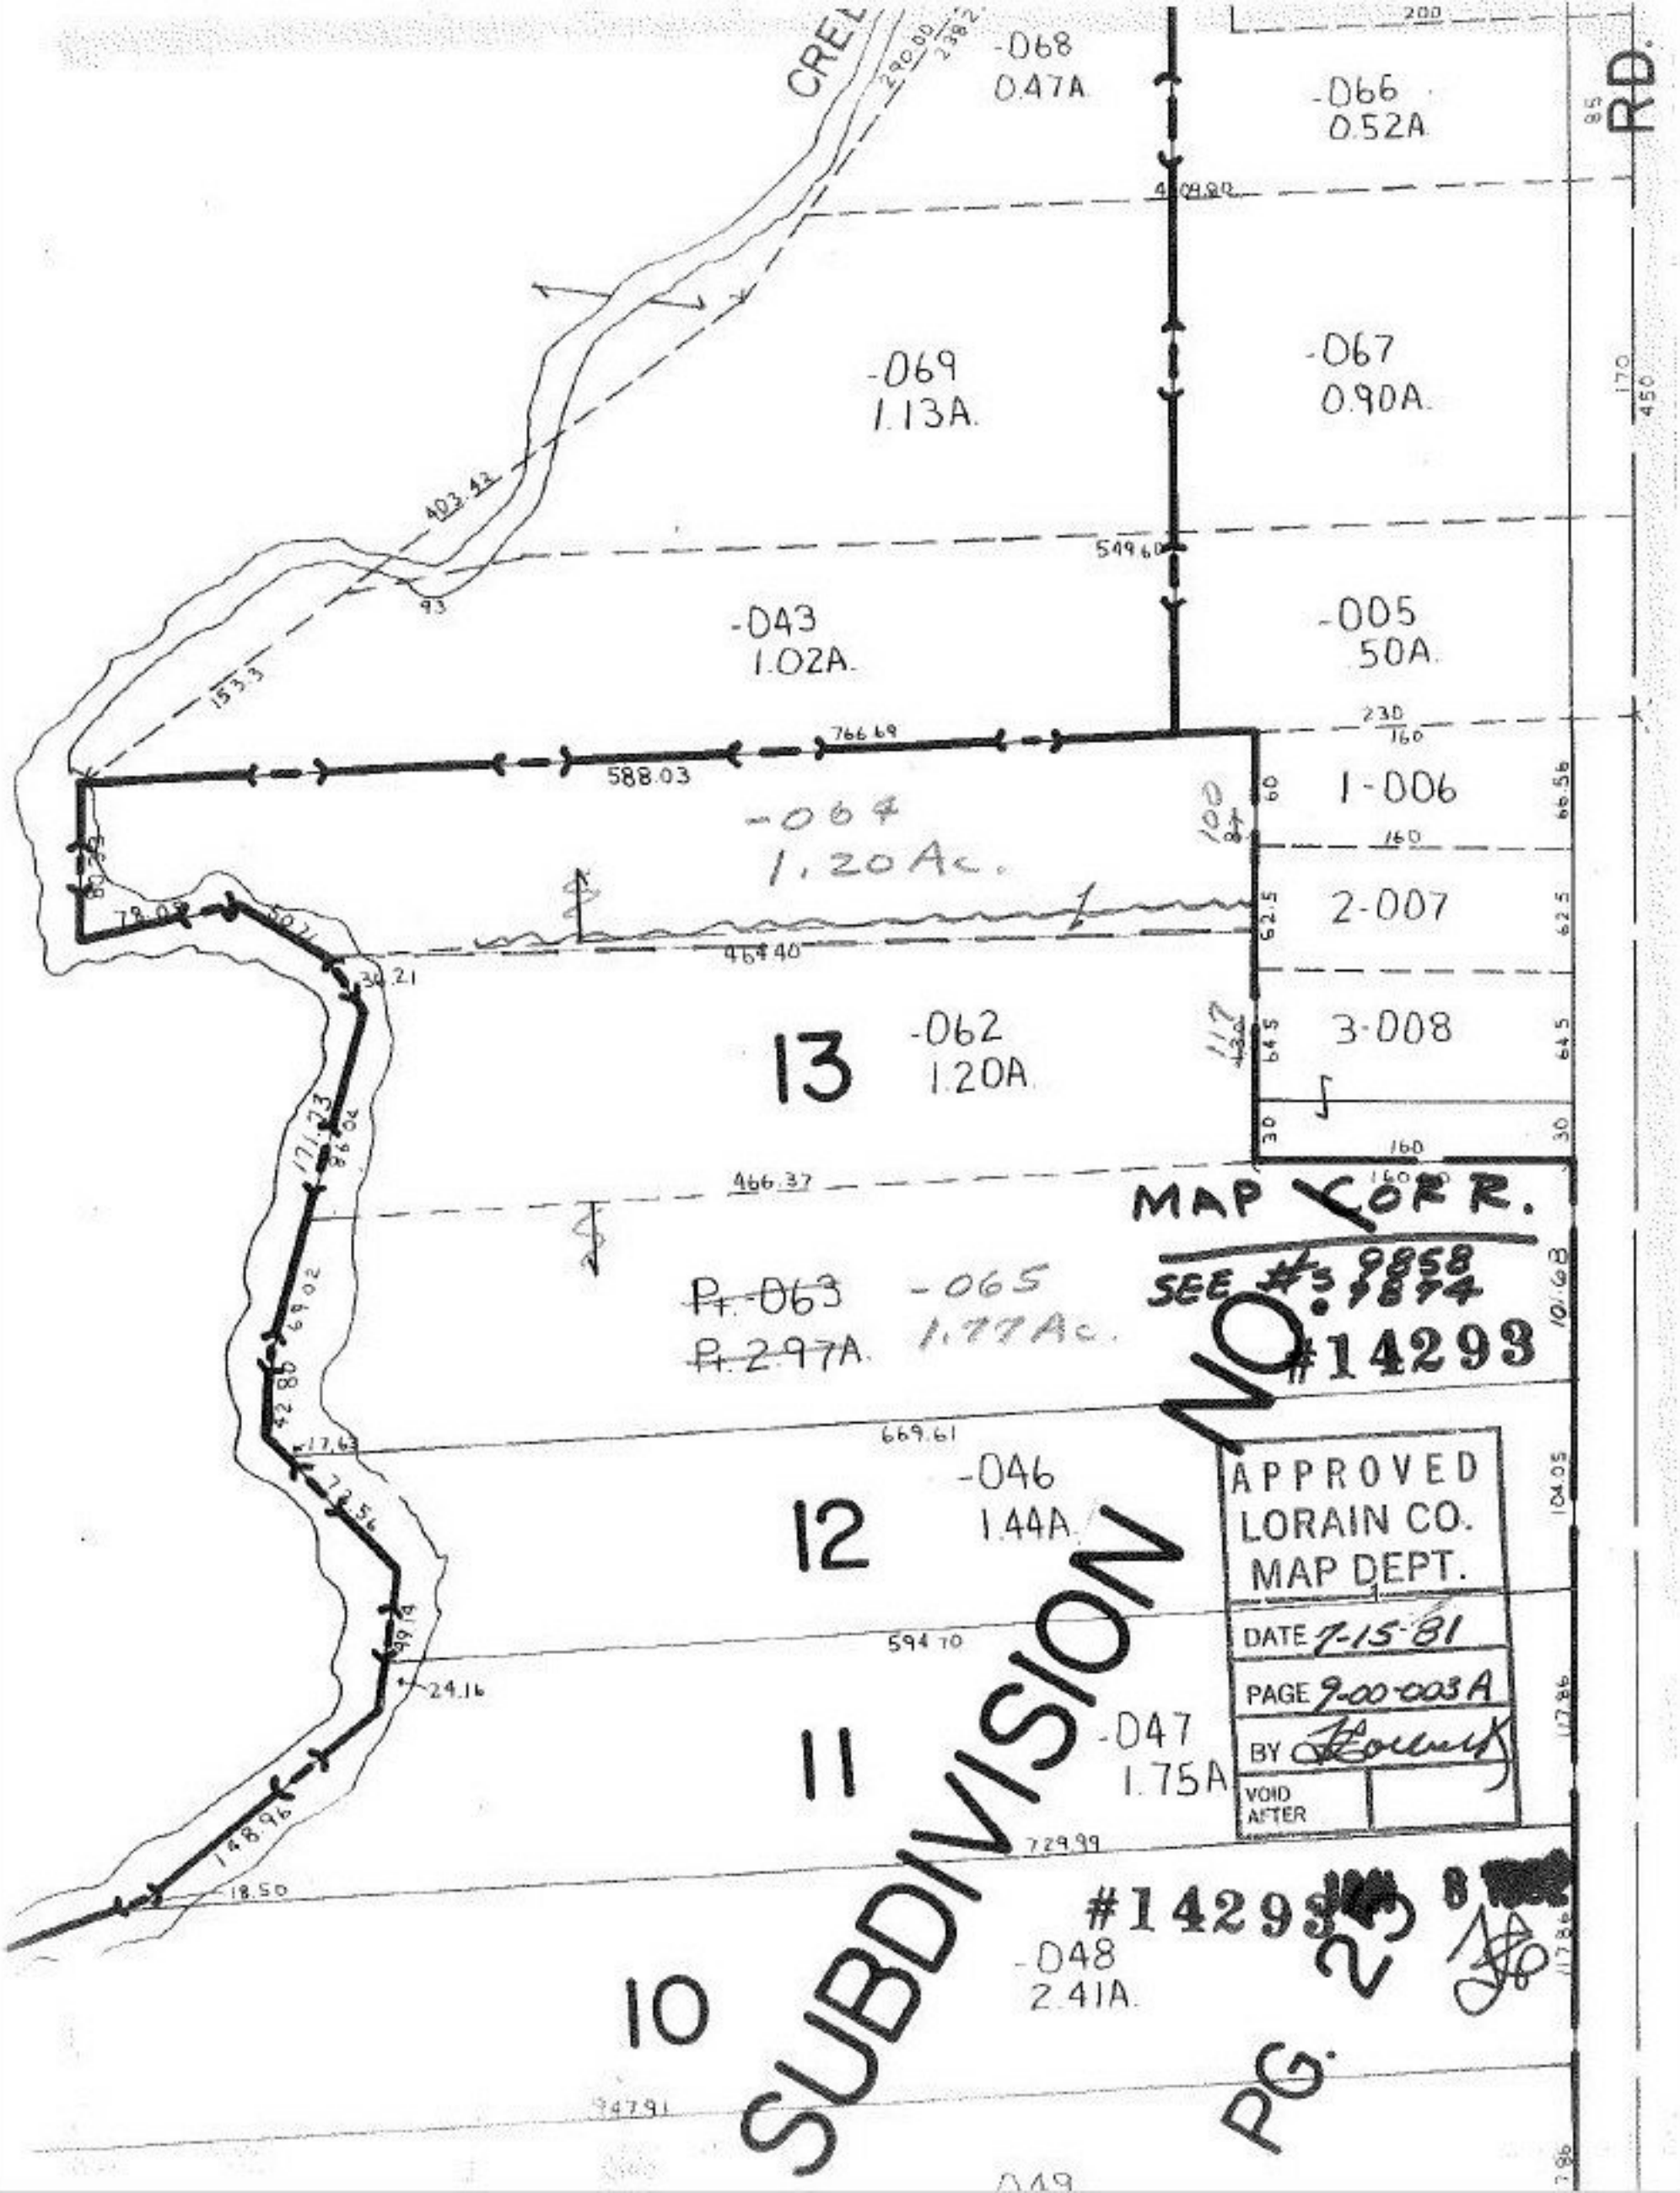

CREE
-068
0.47A
-066
0.52A
RD.
-069
1.13A.
-067
0.90A.
-043
1.02A.
-005
50A.
-064
1.20Ac.
1-006
2-007
3-008
13
-062
1.20A
MAP COR R.
SEE #s 9858 9874
#14293
Pt. -063
Pt. 2.97A.
-065
1.77Ac.
12
-046
1.44A.
APPROVED
LORAIN CO.
MAP DEPT.
DATE 7-15-81
PAGE 9-00-003A
BY
VOID AFTER
11
-047
1.75A
#14293
10
-048
2.41A.
SUBDIVISION NO. 1
PG. 23