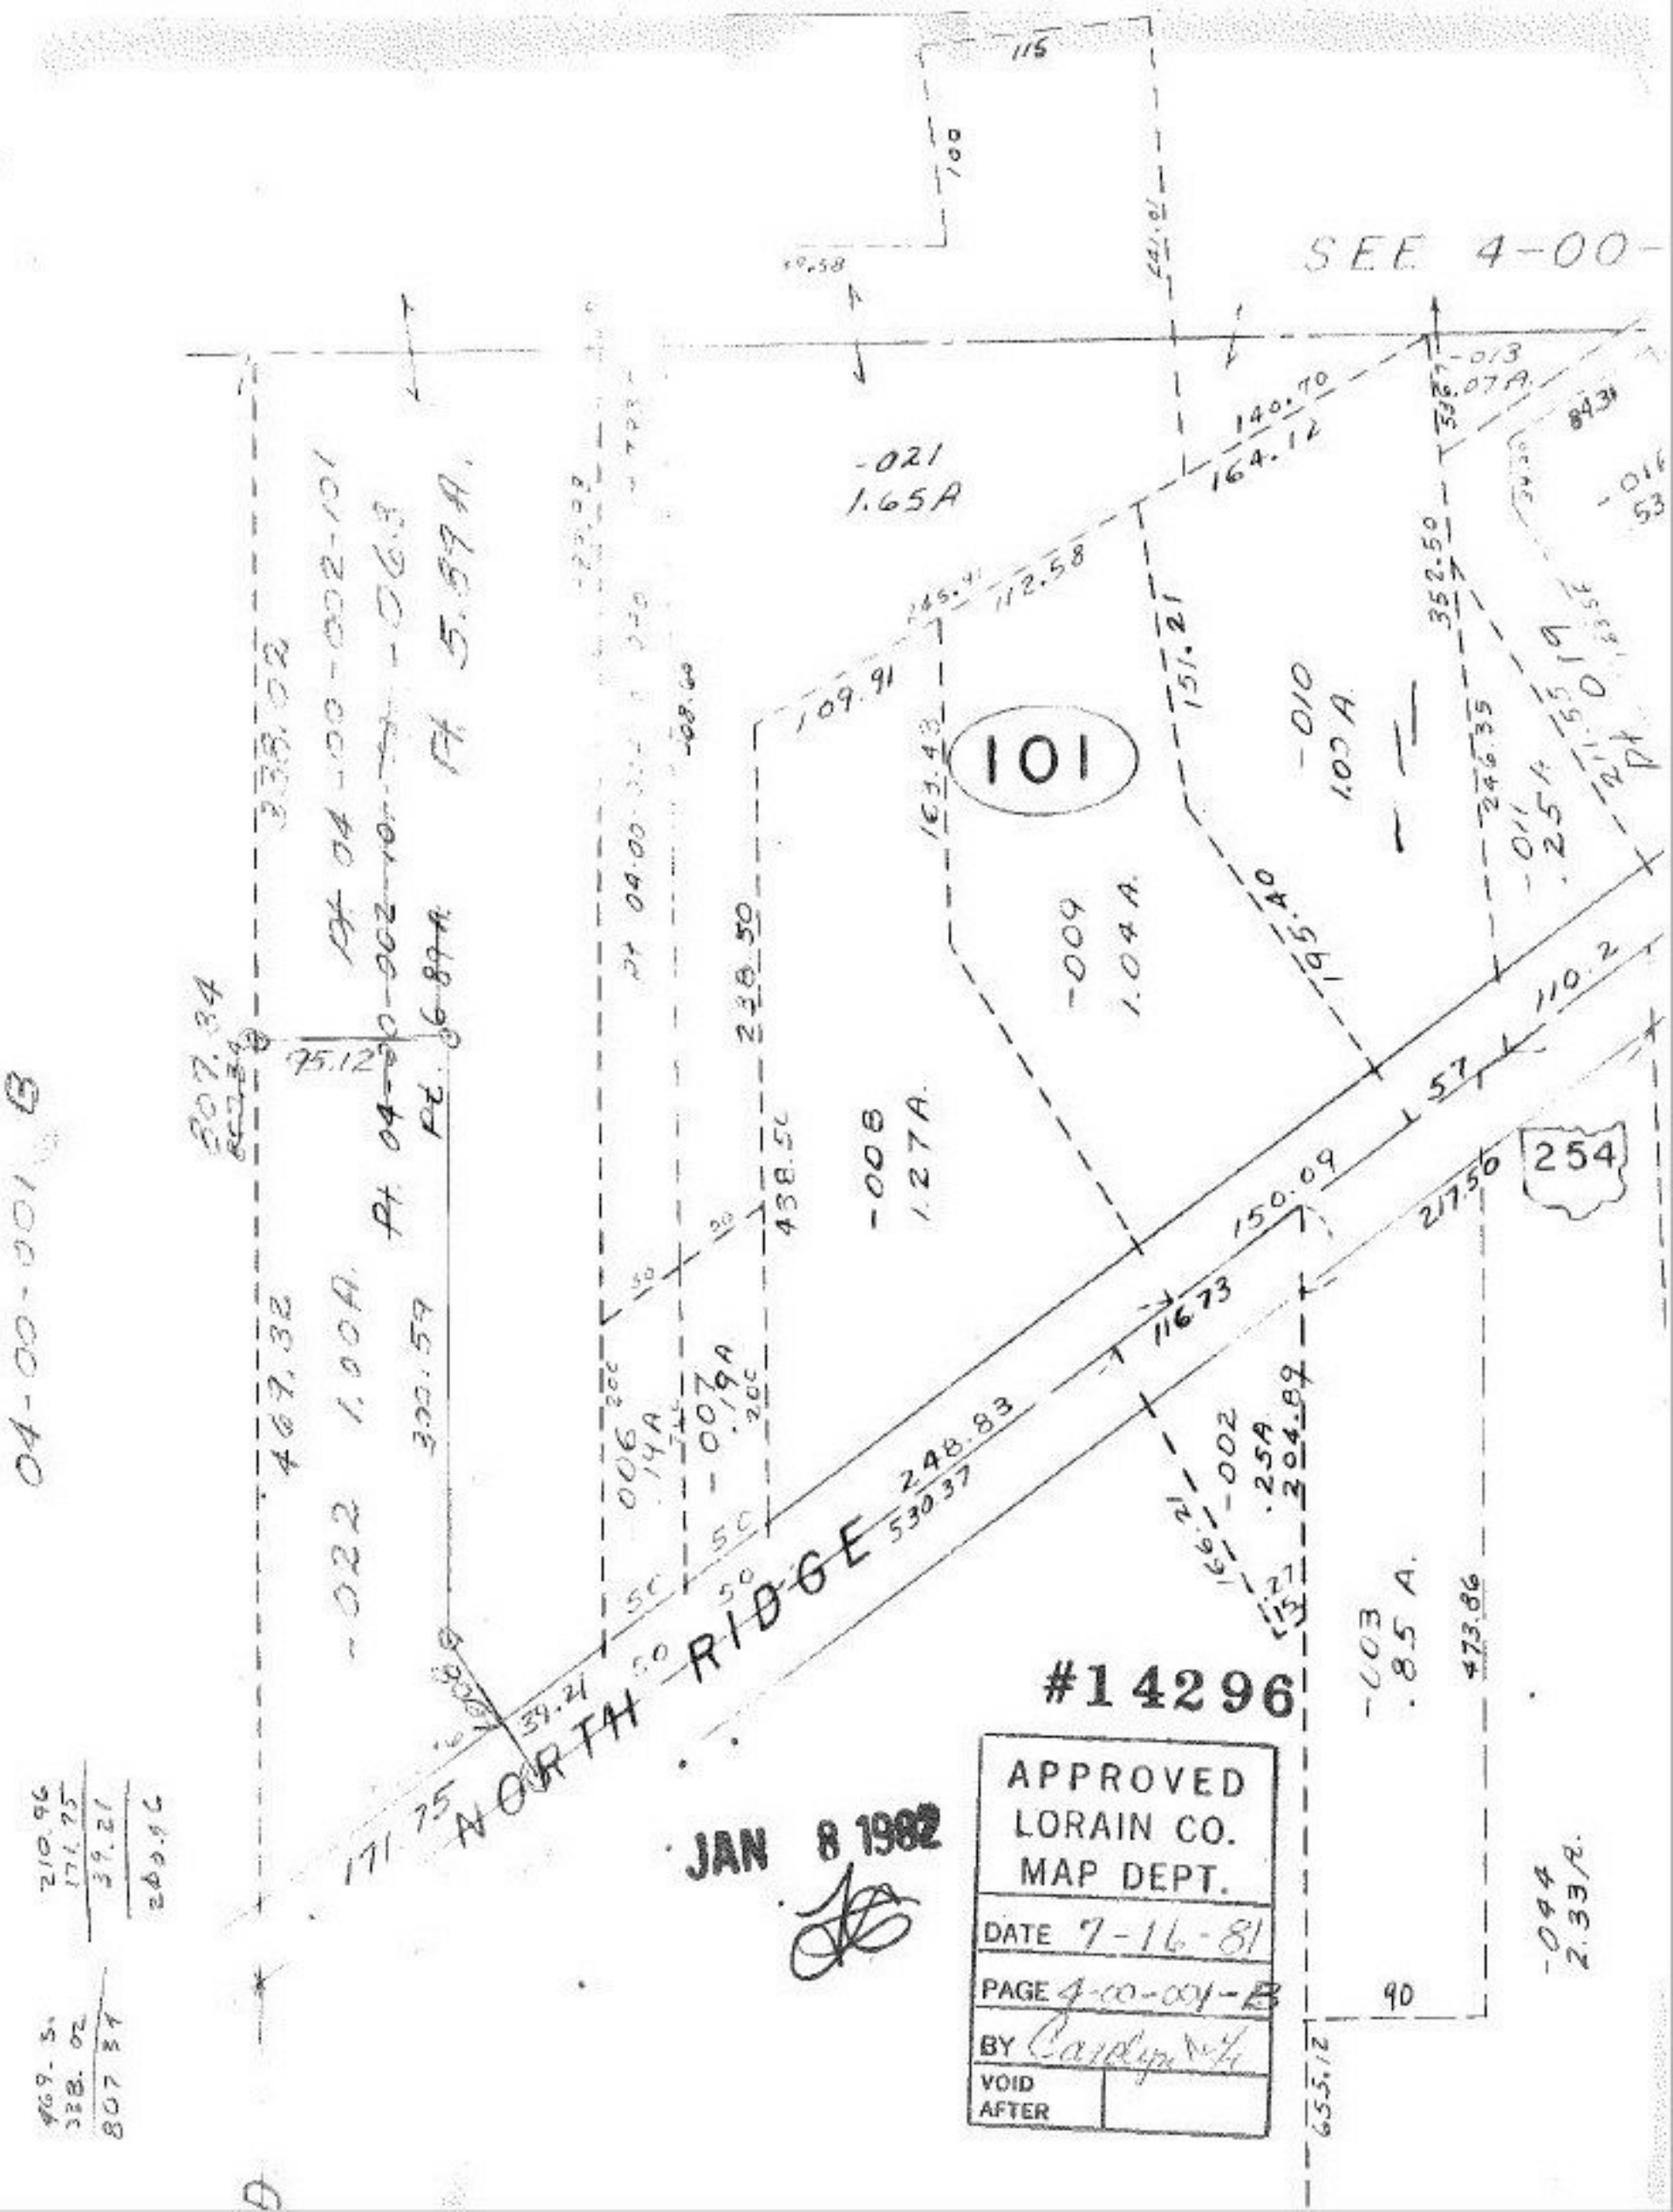
SEE 4-00-
101
254
NORTH RIDGE
-021
1.65A
-010
1.00 A
-009
1.04 A
-008
1.27A
-022
1.00A
-002
.25A
-003
.85 A.
-044
2.33A.
04-00-001 B
#14296
JAN 8 1982
APPROVED
LORAIN CO.
MAP DEPT.
DATE 7-16-81
PAGE 4-00-001-B
BY
VOID
AFTER