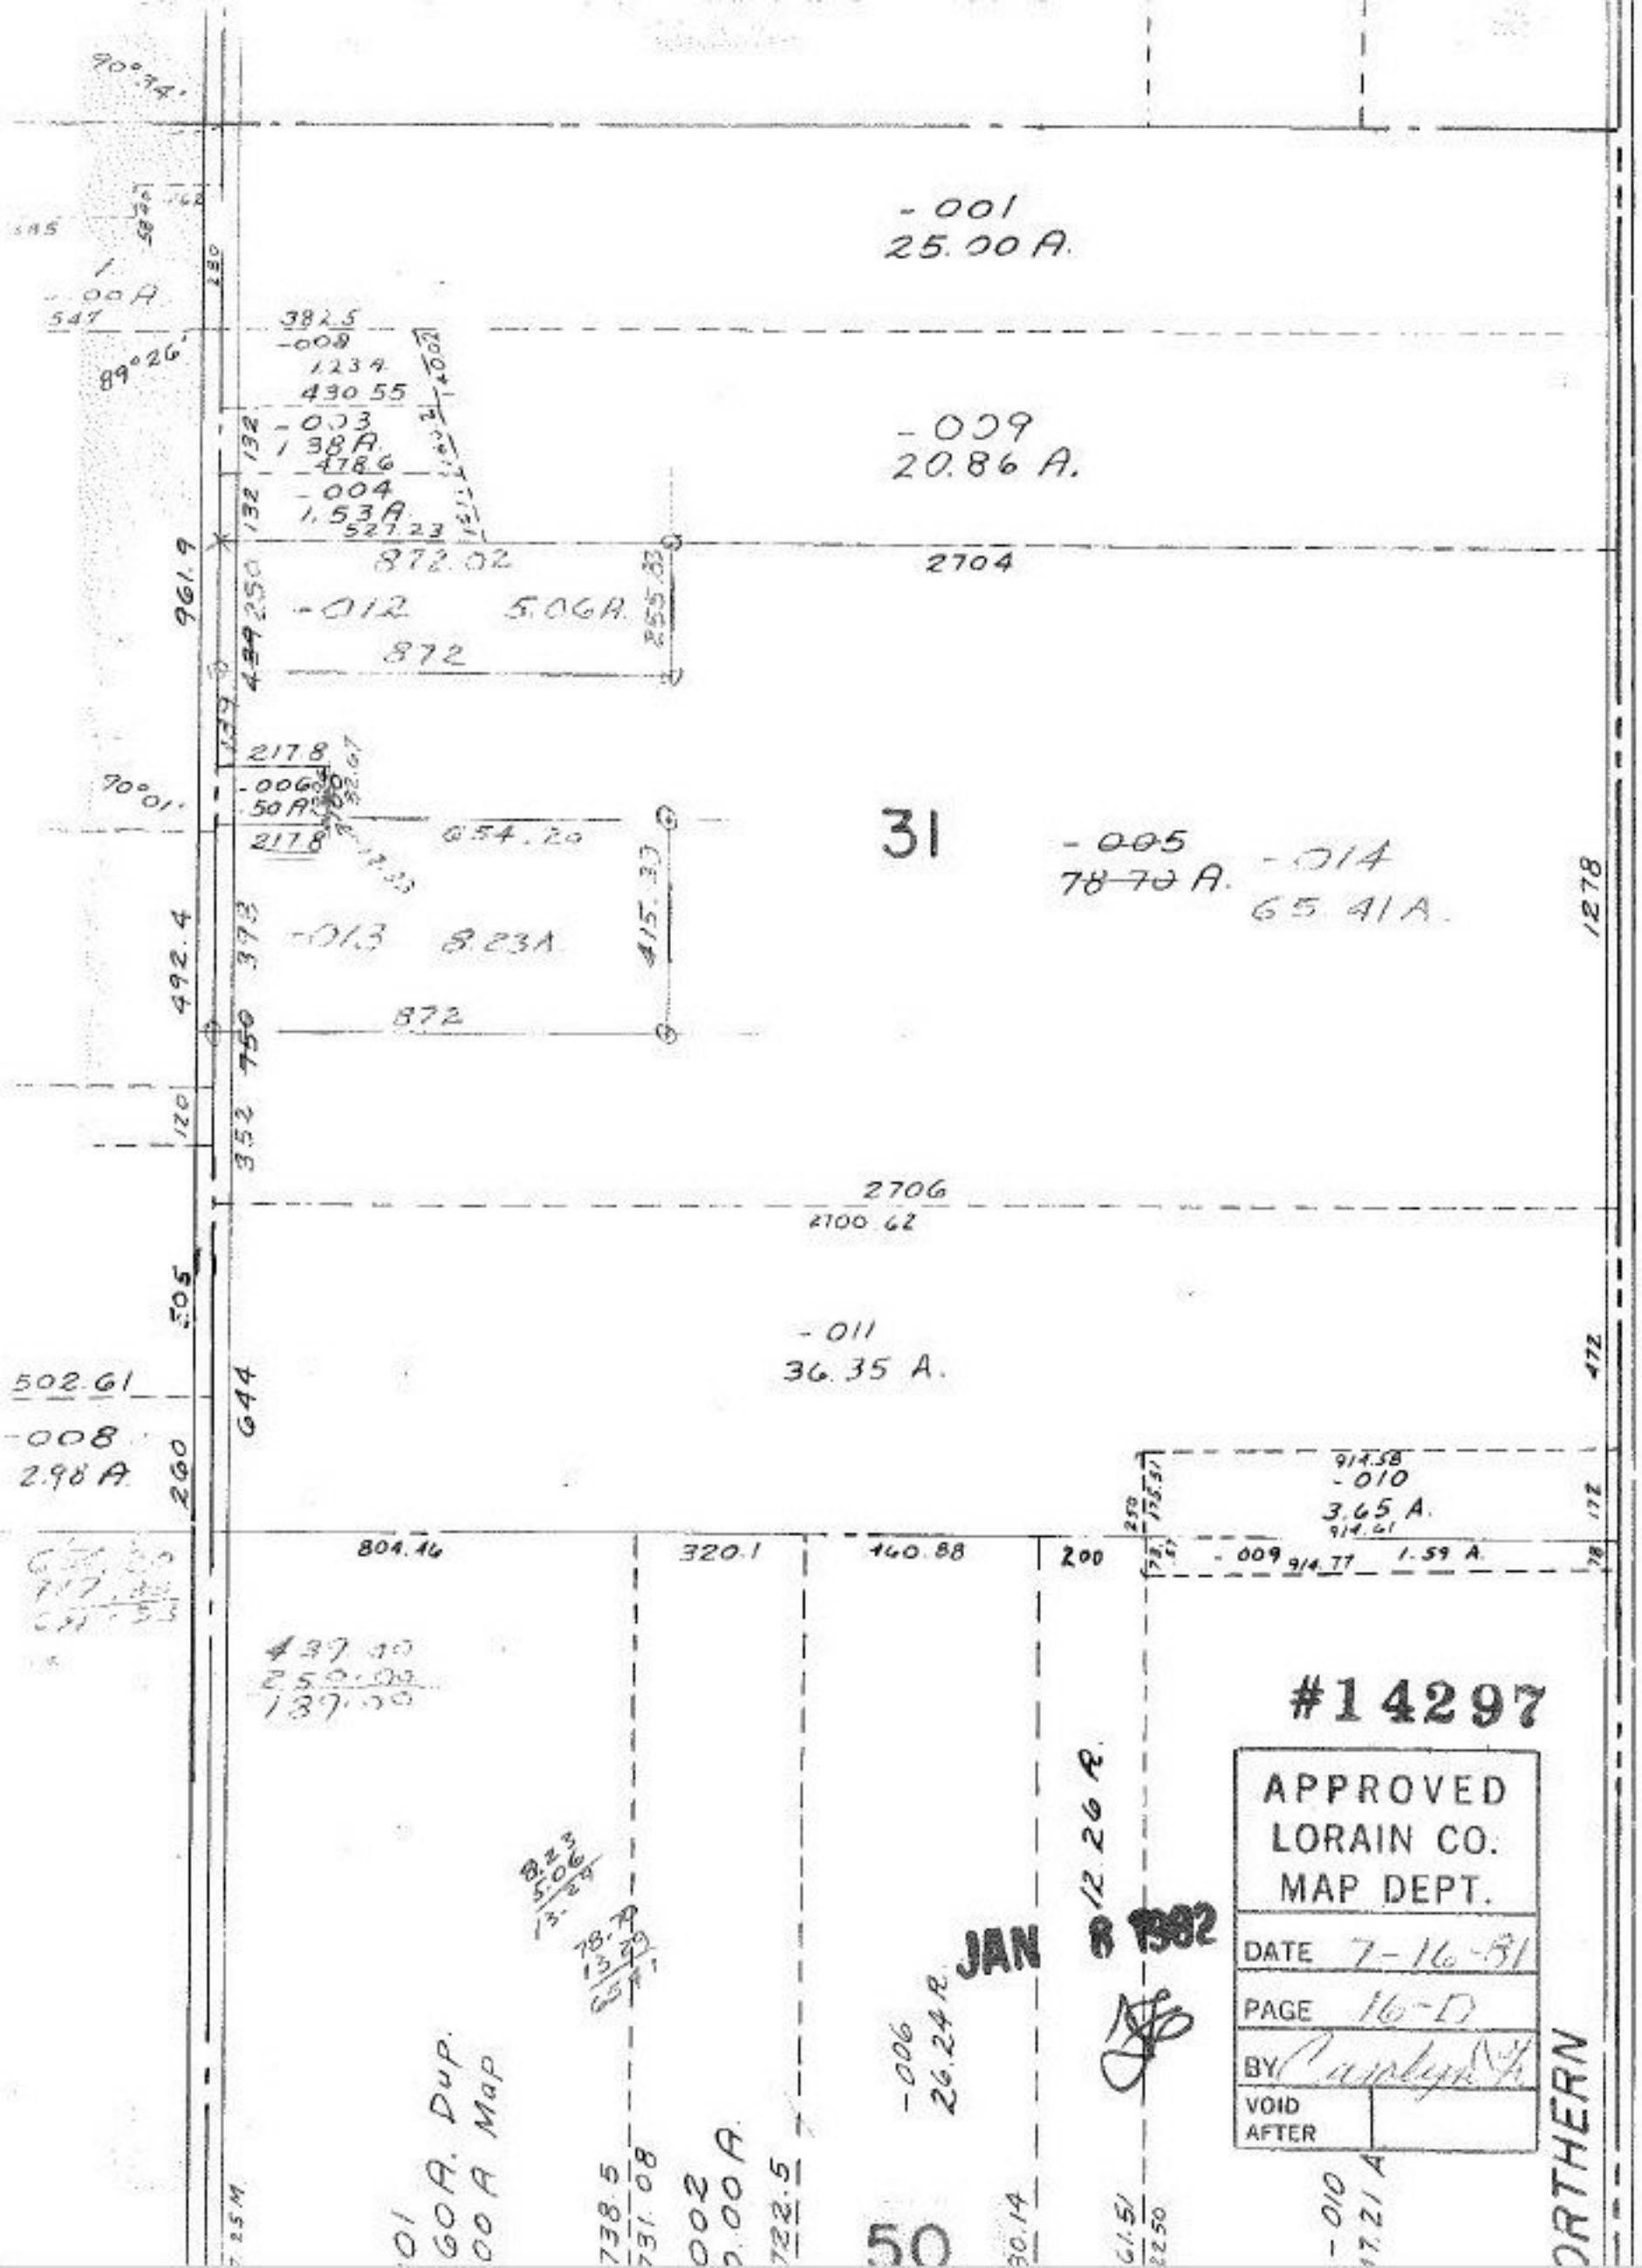

-001
25.00 A.
-009
20.86 A.
2704
-012
5.06 A.
872
31
-005
78.70 A.
-014
65.41 A.
-013
8.23 A.
872
2706
2700.62
-011
36.35 A.
-010
3.65 A.
804.46
320.1
460.88
200
-006
26.24 A.
12.26 A.
50
#14297
APPROVED
LORAIN CO.
MAP DEPT.
DATE 7-16-81
PAGE 16-D
BY
VOID
AFTER
JAN 8 1982
ORTHERN