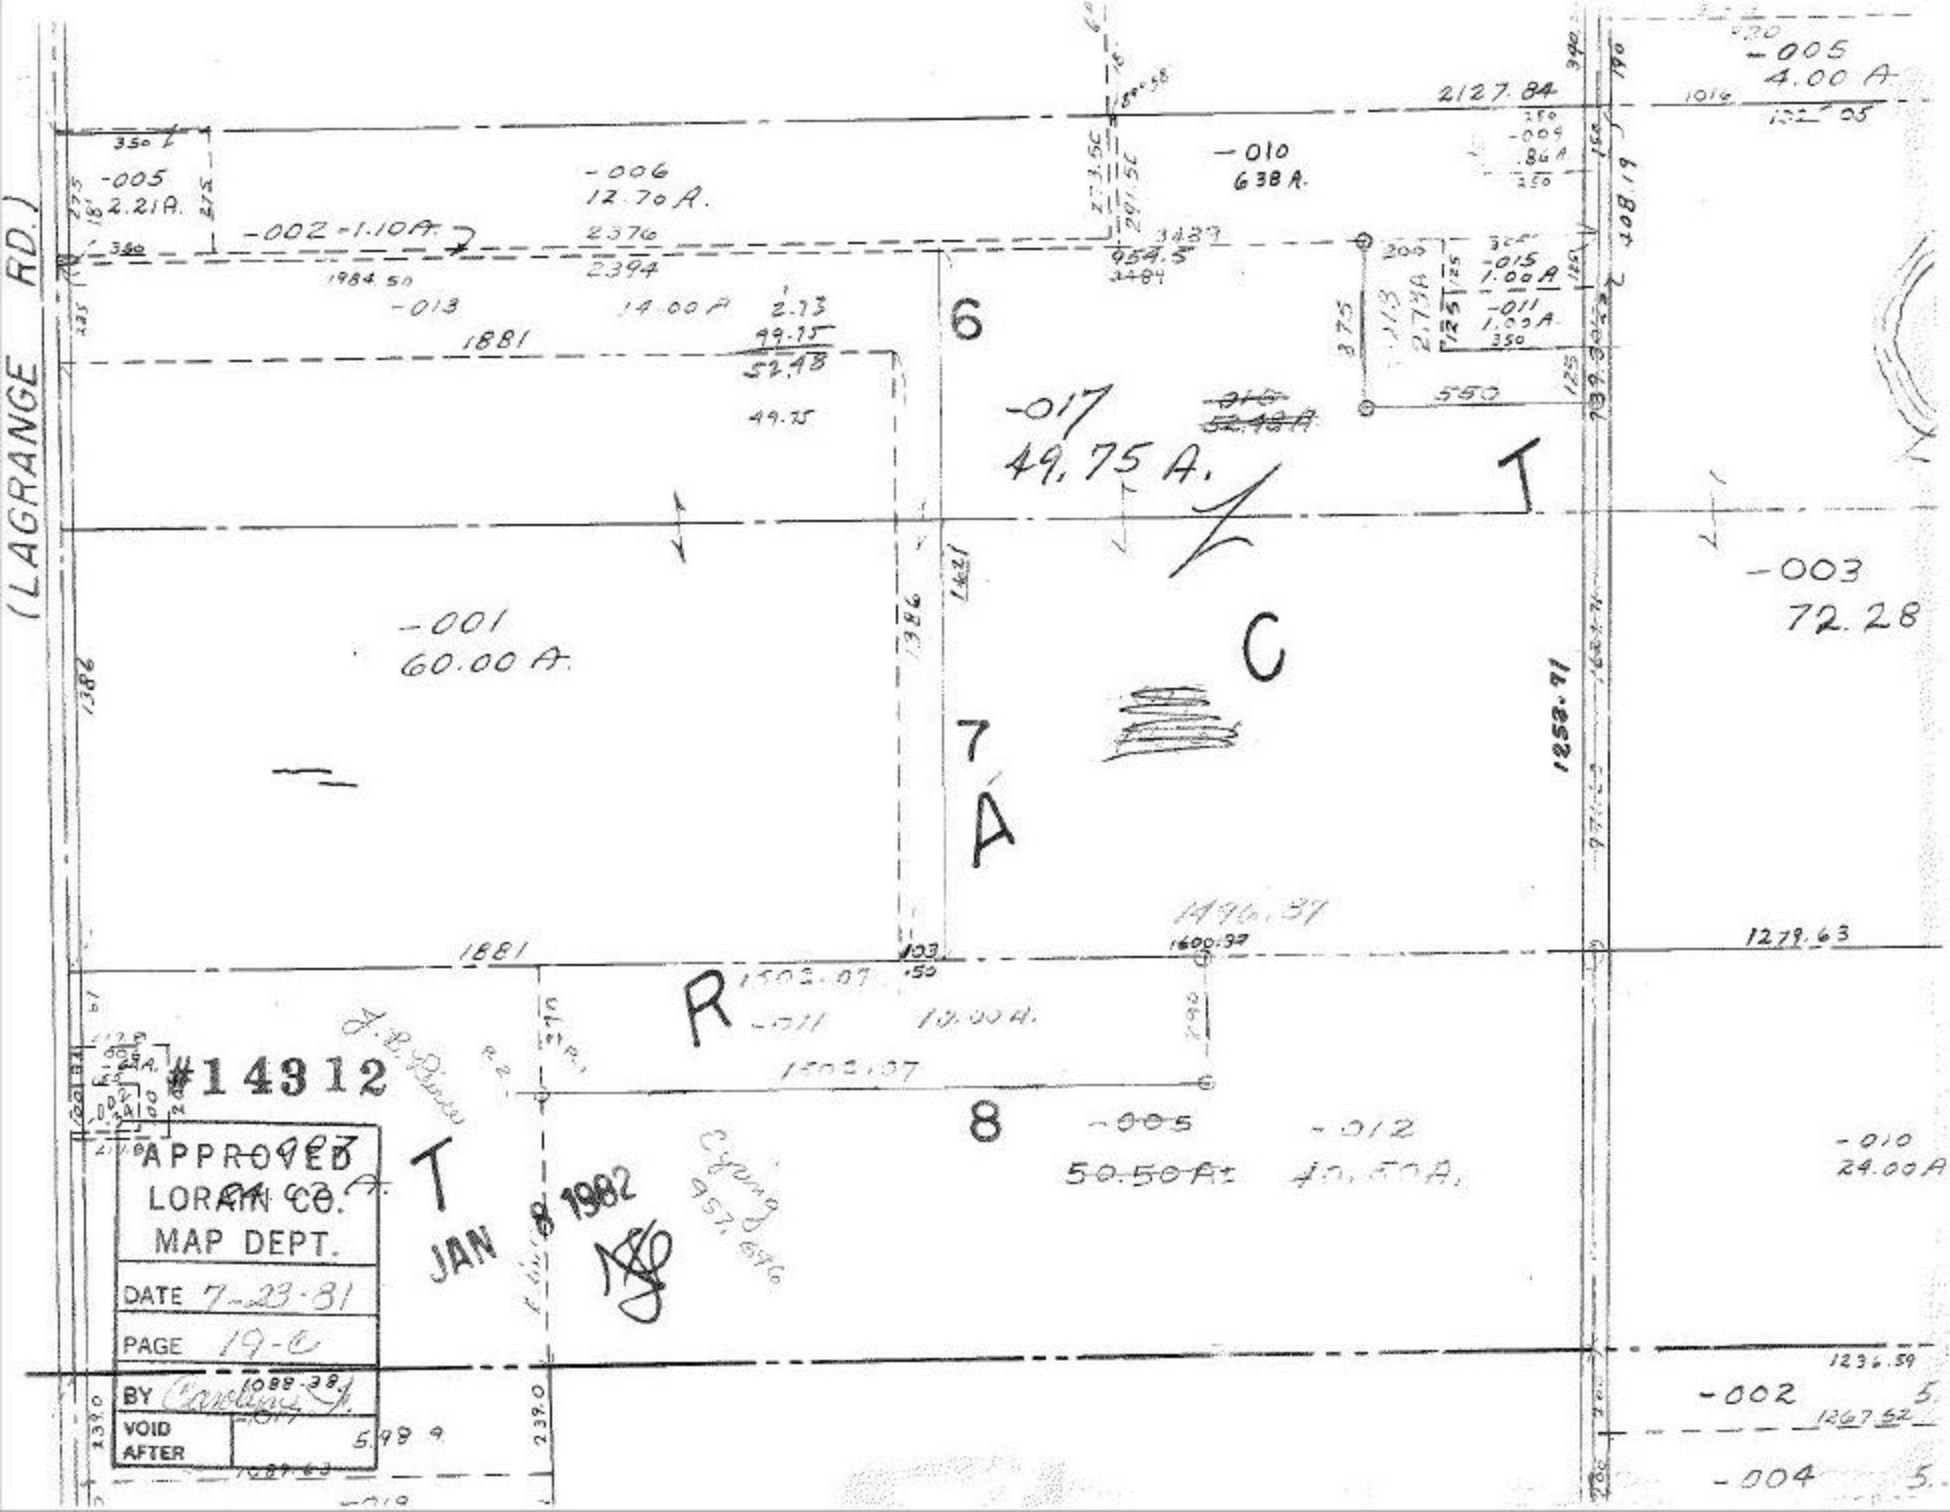
(LAGRANGE RD.)
-005
2.21A.
-006
12.70A.
-002 - 1.10A.
-013
14.00A
-010
638A.
-005
4.00A
-009
.84A
-015
1.00A
-011
1.00A
-017
49.75A.
-001
60.00A.
-003
72.28
-010
24.00A
-012
10.00A.
-005
50.50A±
-002
-004
2127.84
1881
1258.91
1279.63
1600.37
1502.37
1236.59
1267.52
#14312
APPROVED
LORAIN CO.
MAP DEPT.
DATE 7-23-81
PAGE 19-C
BY
VOID AFTER
JAN 8 1982
6
7
8
T
R
C
A