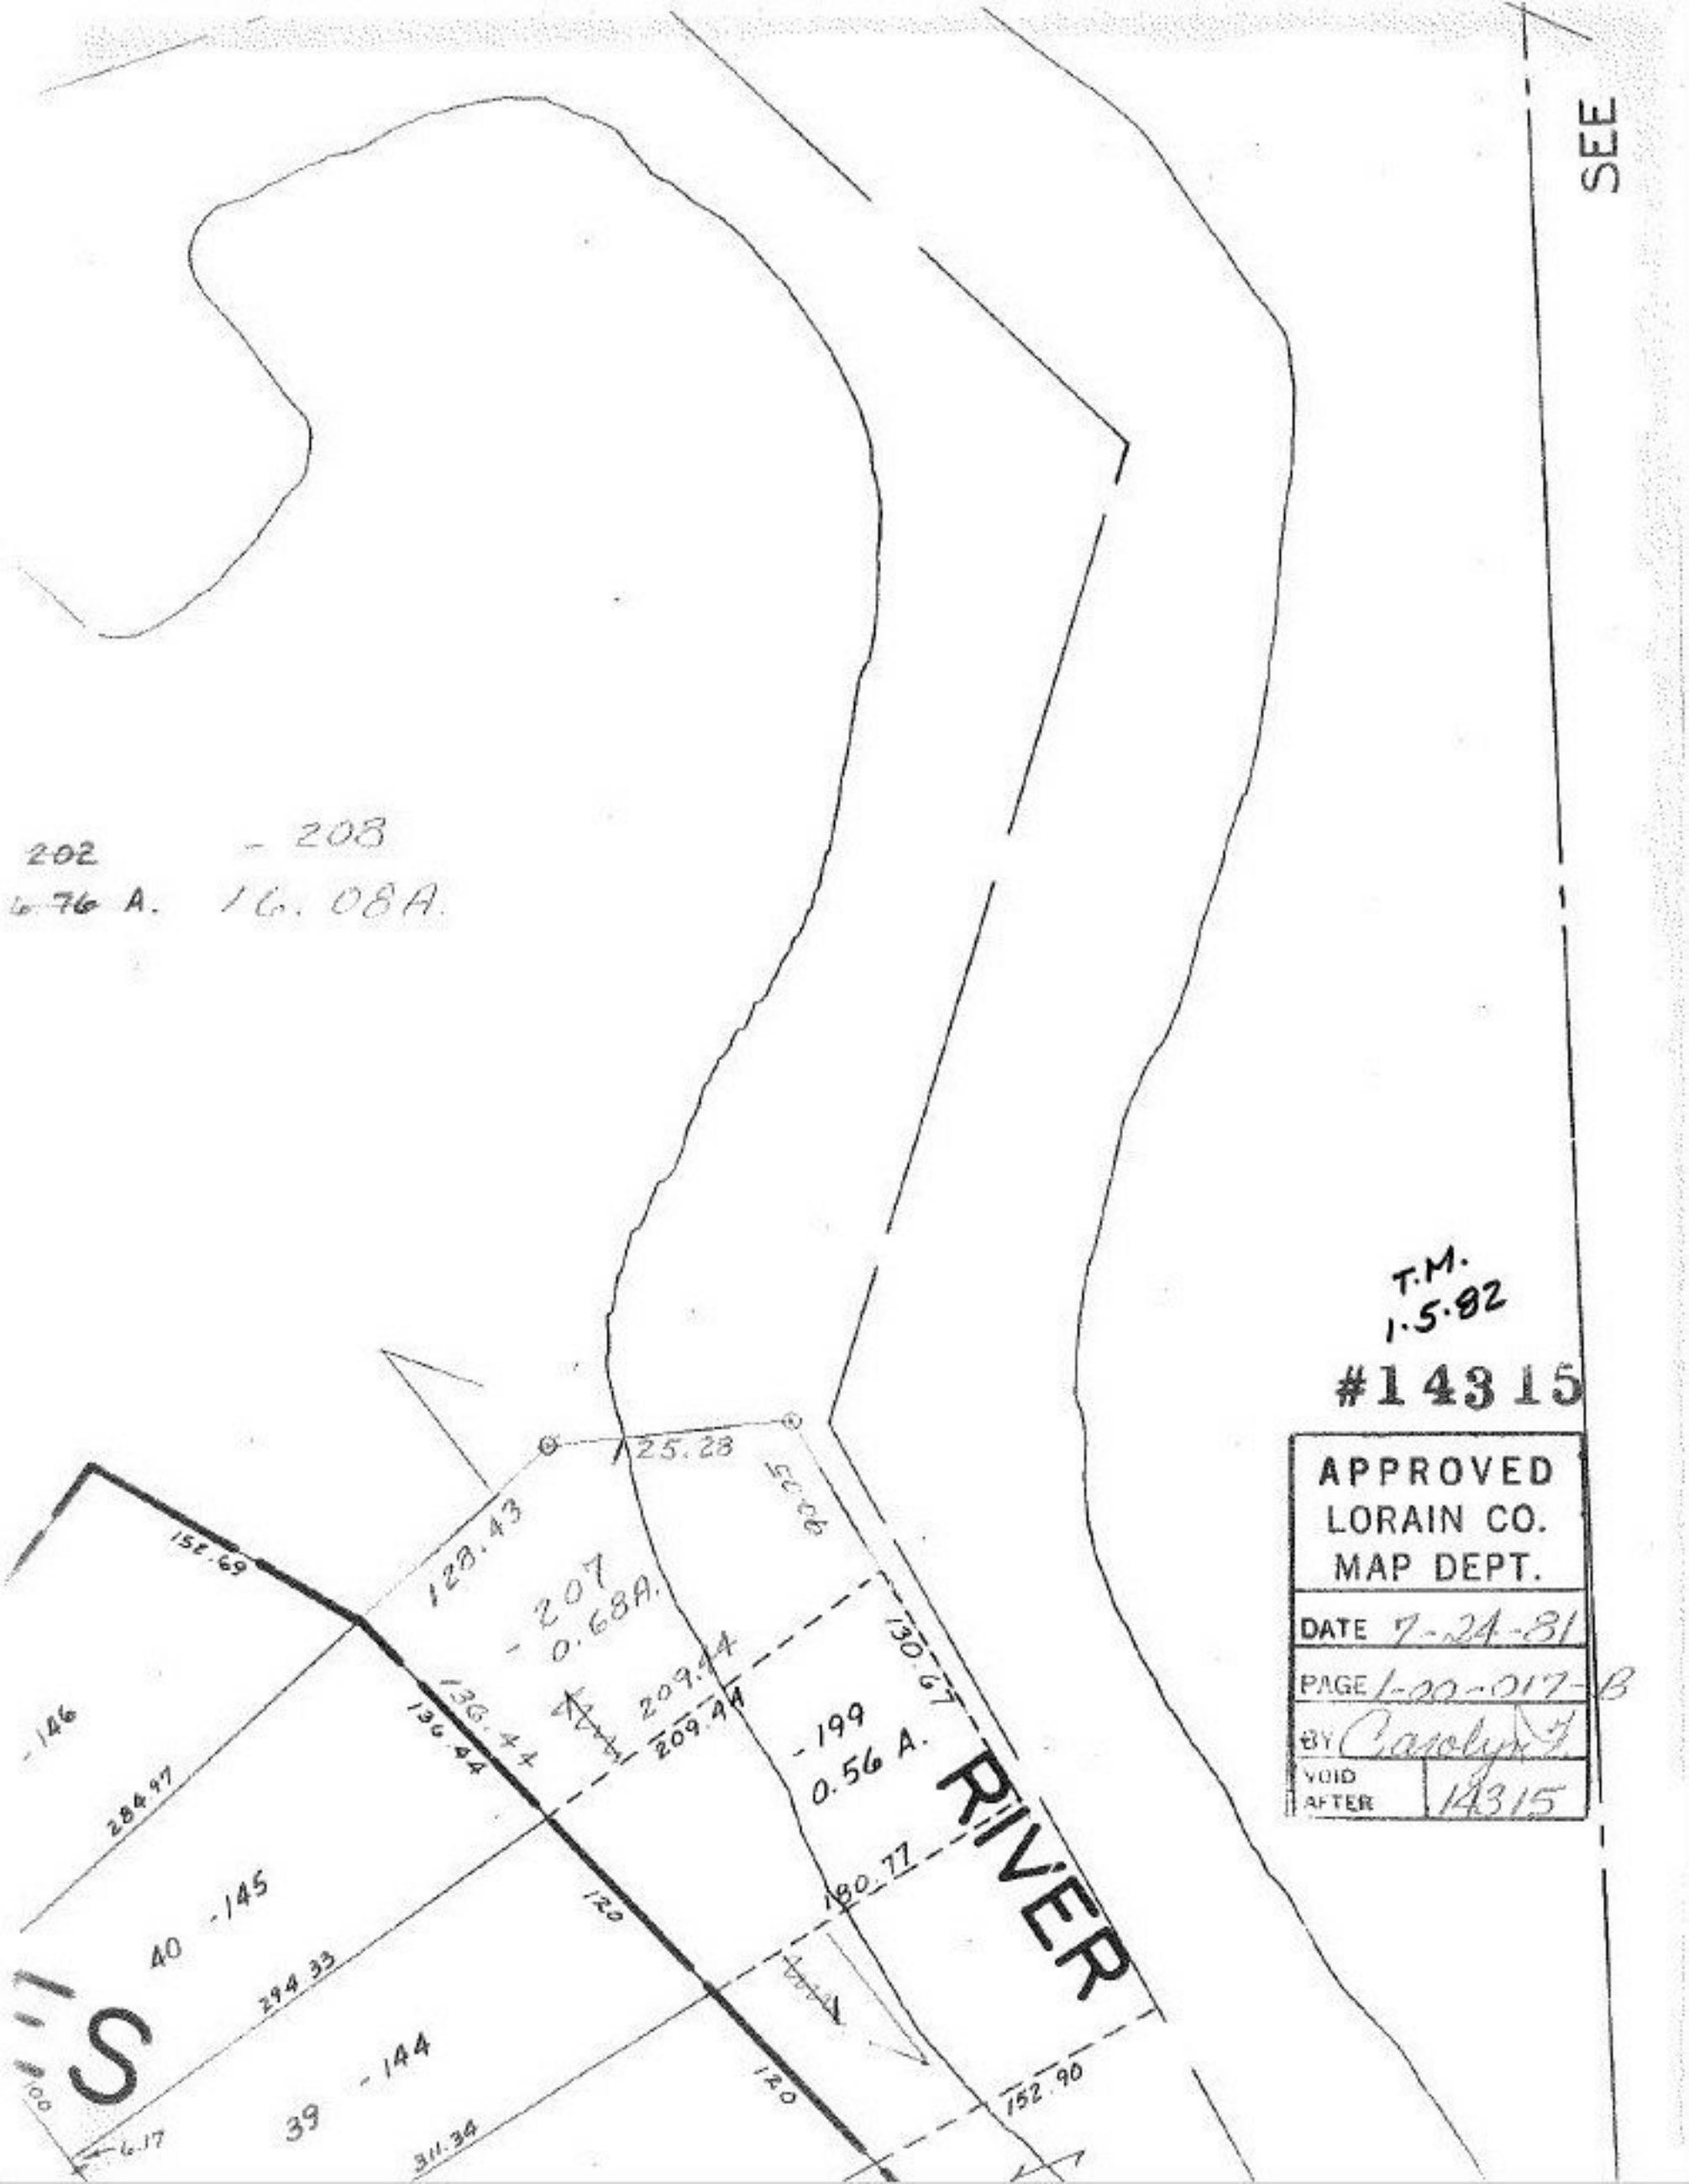
SEE
202
- 208
6.76 A.
16.08A.
T.M.
1.5.82
#14315
APPROVED
LORAIN CO.
MAP DEPT.
DATE 7-24-81
PAGE 1-00-017-B
BY Carolyn F.
VOID AFTER 14315
125.28
128.43
152.69
- 207
0.68A.
136.44
136.44
209.44
209.44
130.67
- 199
0.56 A.
RIVER
180.77
- 146
284.97
40 - 145
294.33
120
39 - 144
311.34
120
152.90
6.17
S