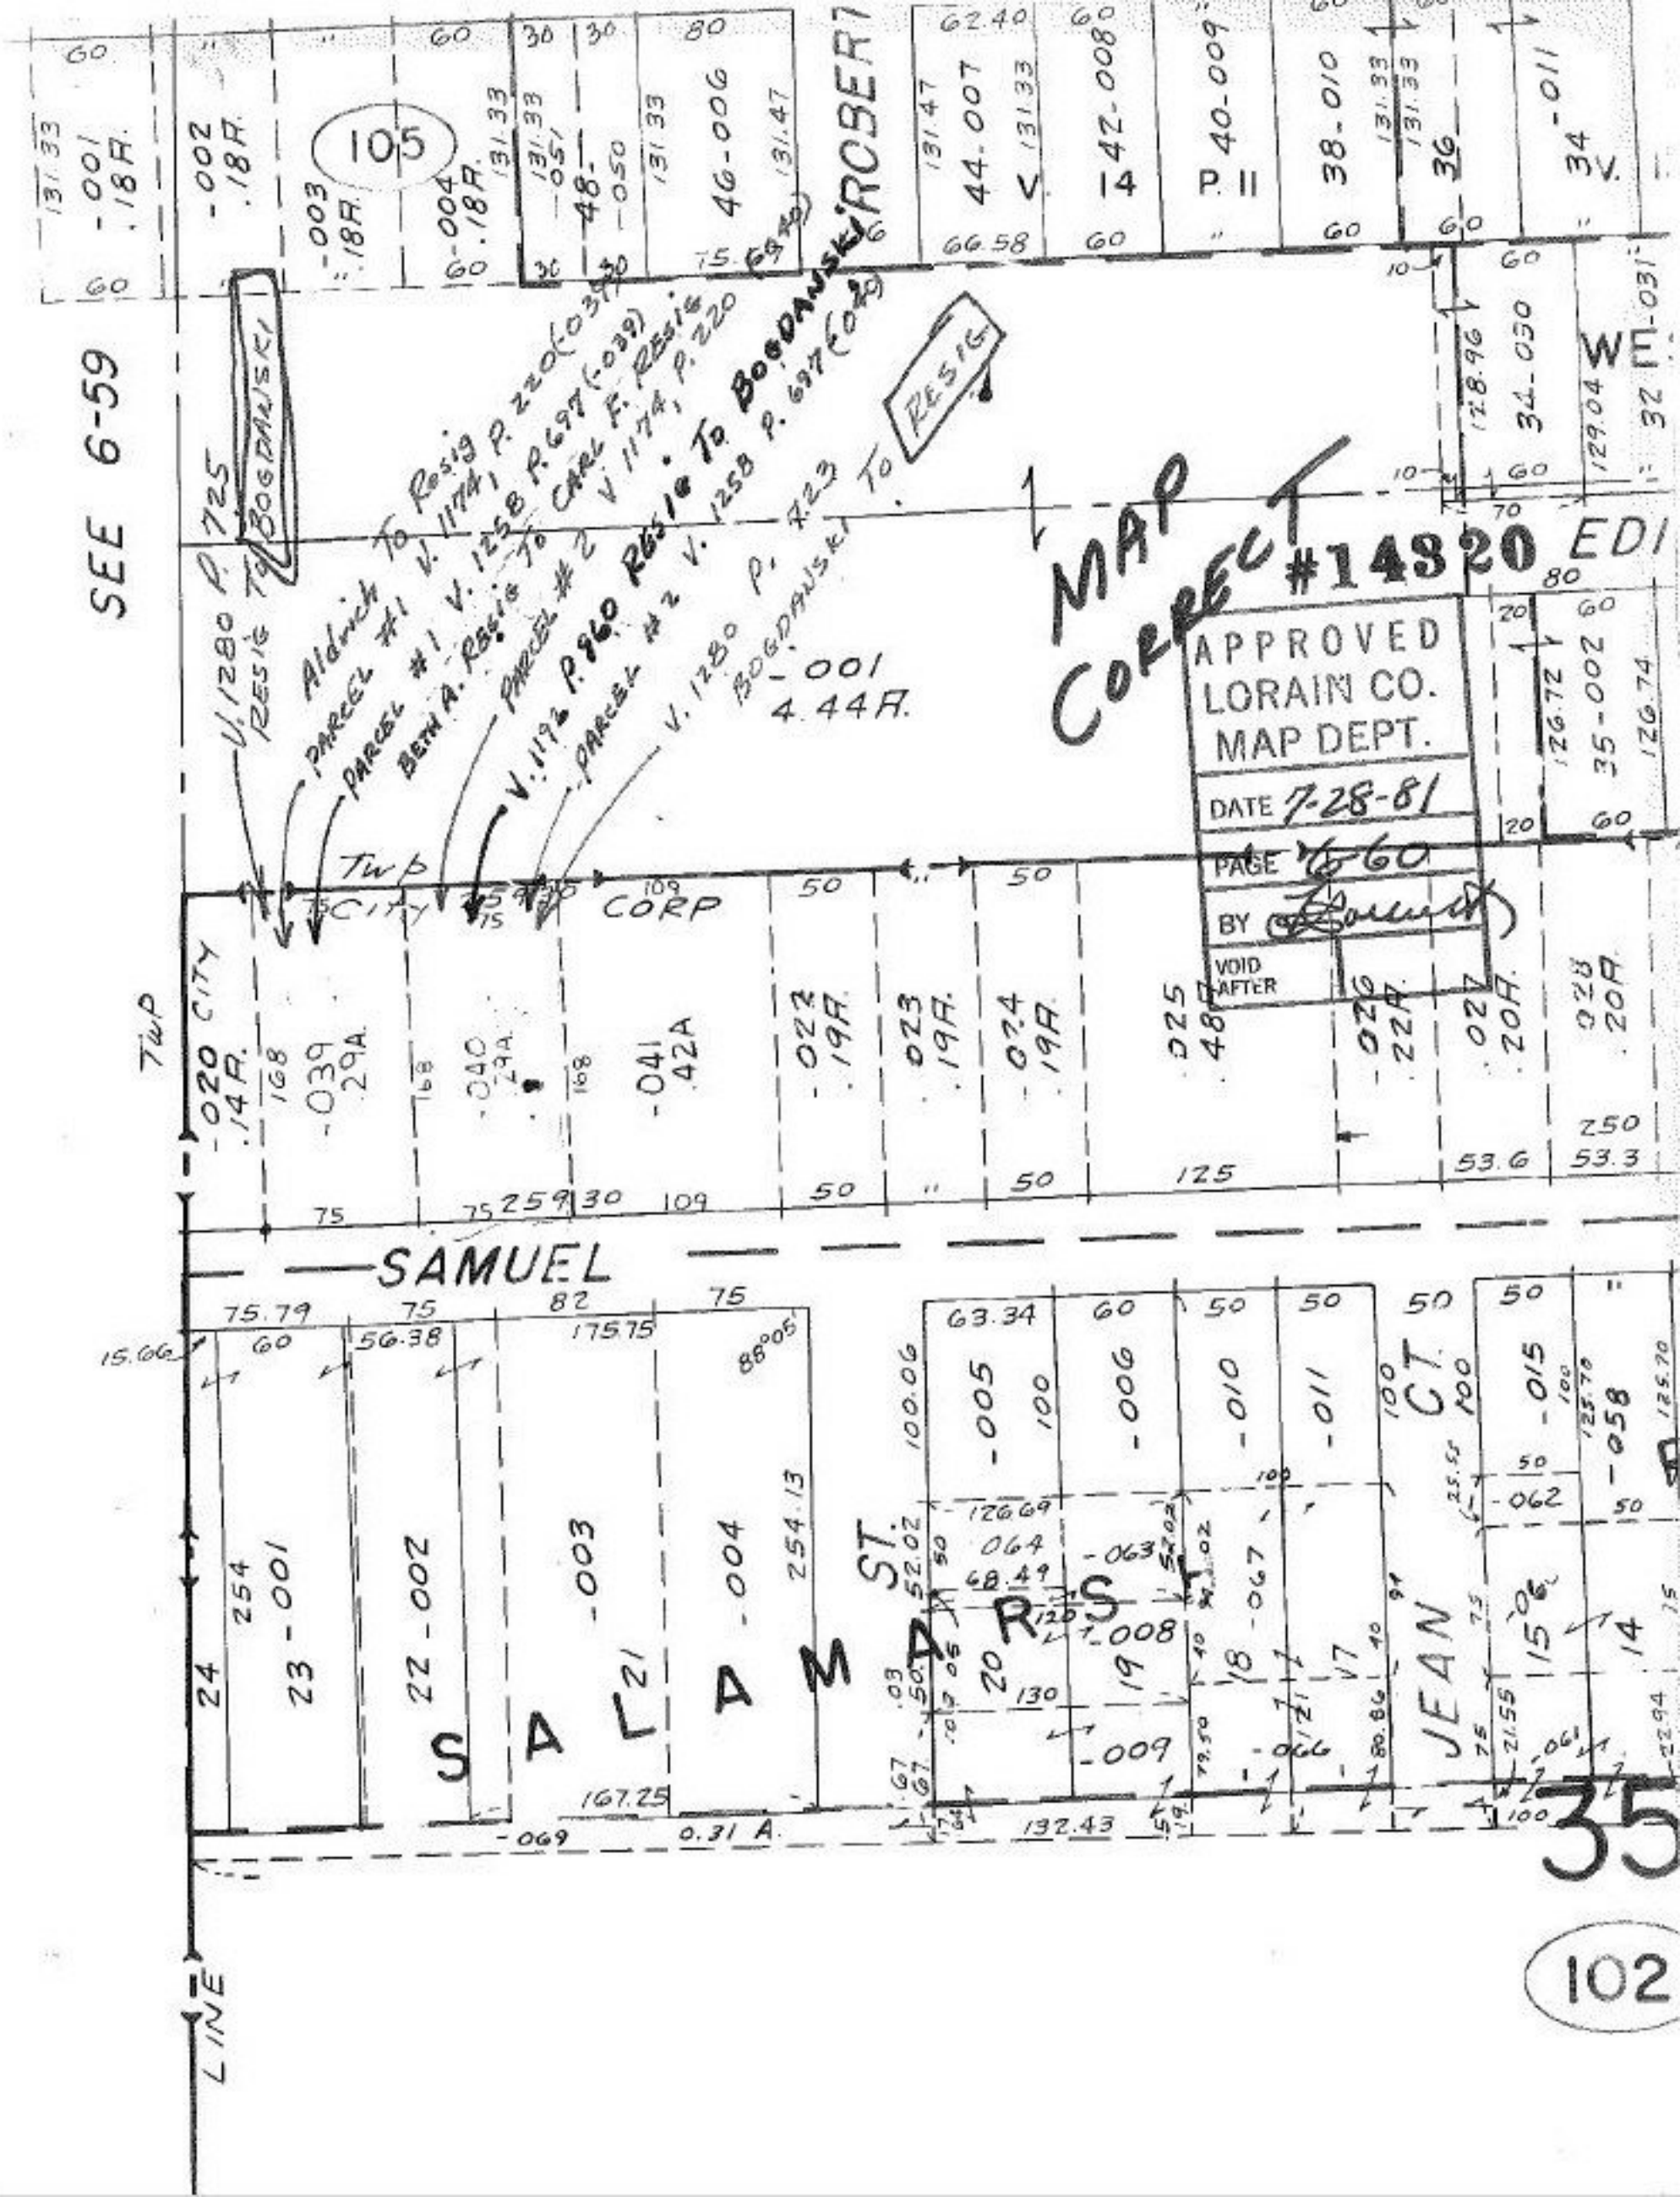

SEE 6-59
105
ROBERT
V. 14
P. 11
MAP CORRECT
#14320
APPROVED
LORAIN CO.
MAP DEPT.
DATE 7-28-81
PAGE 6-60
BY
VOID AFTER
Aldrich To Resig P. 220 (-039)
PARCEL #1 V. 1174, P. 697 (-039)
PARCEL #1 V. 1258 P. 697 (-039)
BETH A. RESIG To CARL F. RESIG
PARCEL #2 V. 1174, P. 220
V. 1192 P. 960 RESIG To BOGDANSKI
PARCEL #2 V. 1258 P. 697 (-040)
V. 1280 P. 723 BOGDANSKI To RESIG
V. 1280 P. 725 RESIG To BOGDANSKI
-001 4.44A.
Twp
CITY
CORP
SAMUEL
SALAMARSH ST.
JEAN CT.
LINE
35
102