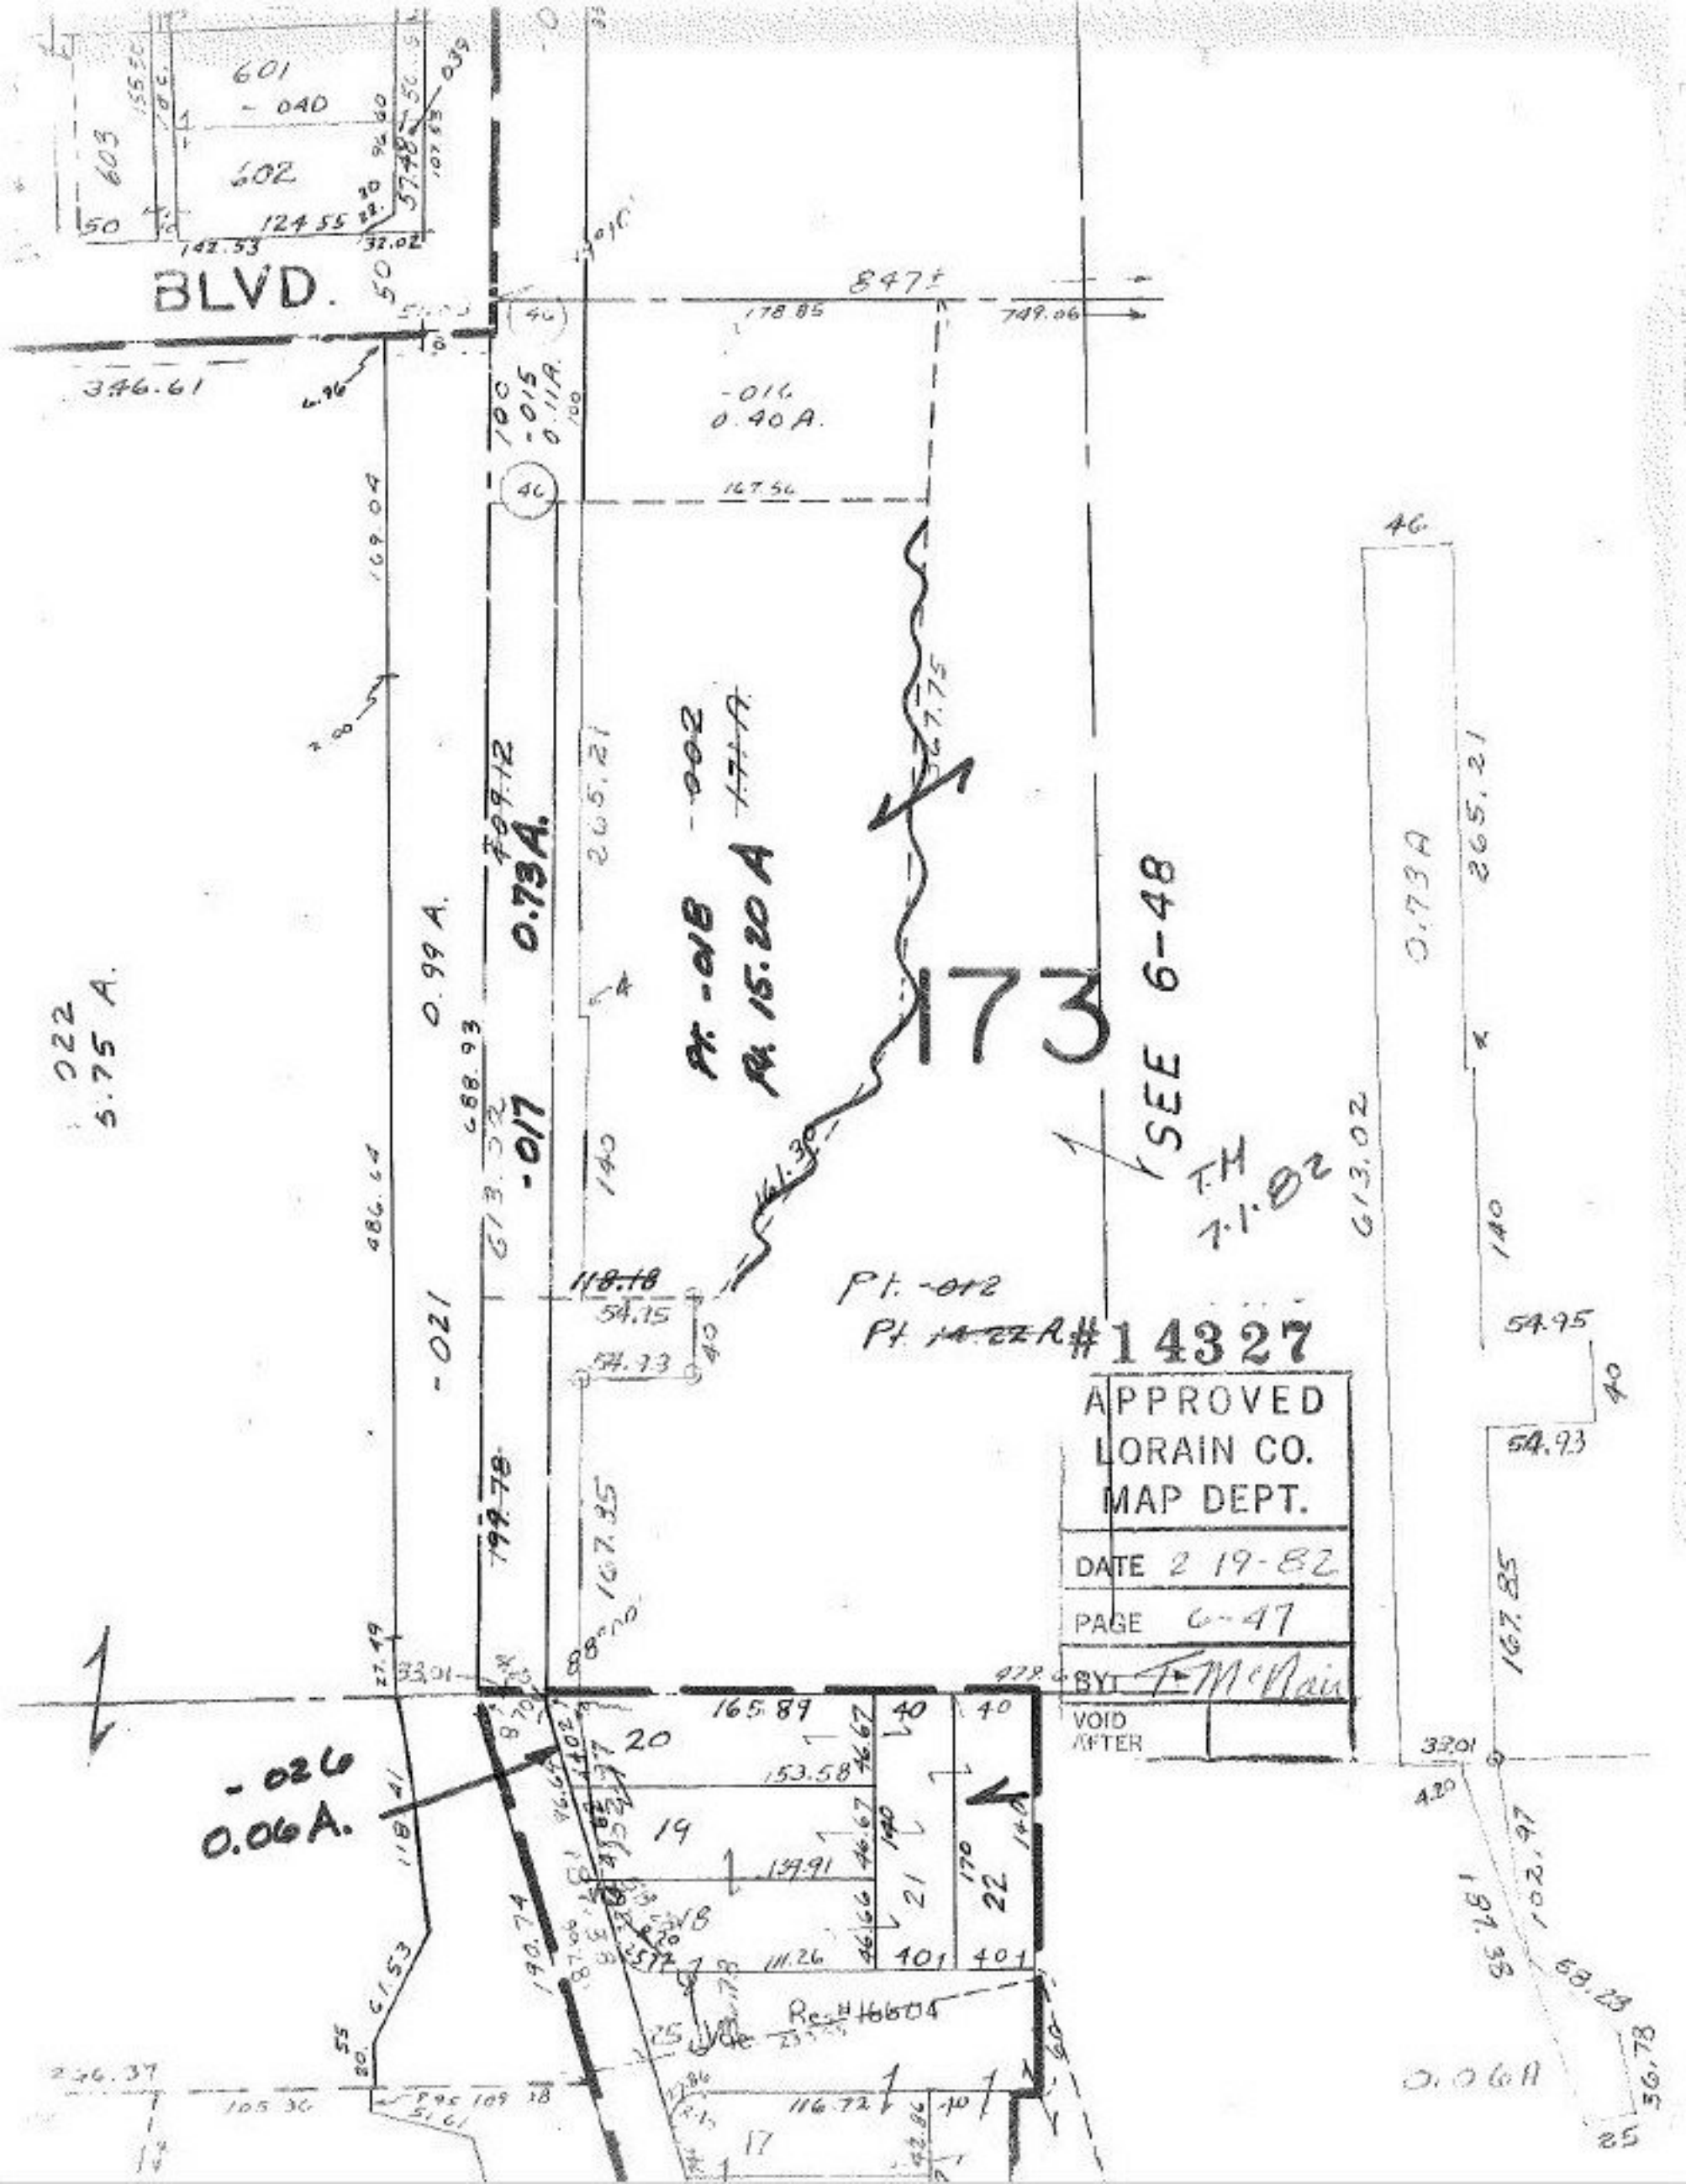

BLVD.
601
-040
602
603
847±
178.85
749.06
346.61
-016
0.40 A.
167.56
169.04
0.73A.
265.21
Pt. -018
Pt. 15.20 A
173
SEE 6-48
T.H
7.1.82
0.99 A.
-017
-021
Pt. -012
Pt. 14.22 A
#14327
APPROVED
LORAIN CO.
MAP DEPT.
DATE 2-19-82
PAGE 6-47
BY T. McNair
VOID
AFTER
-026
0.06A.
165.89
153.58
139.91
111.26
116.72
Res. #16604
0.73A
265.21
613.02
167.85
0.06A