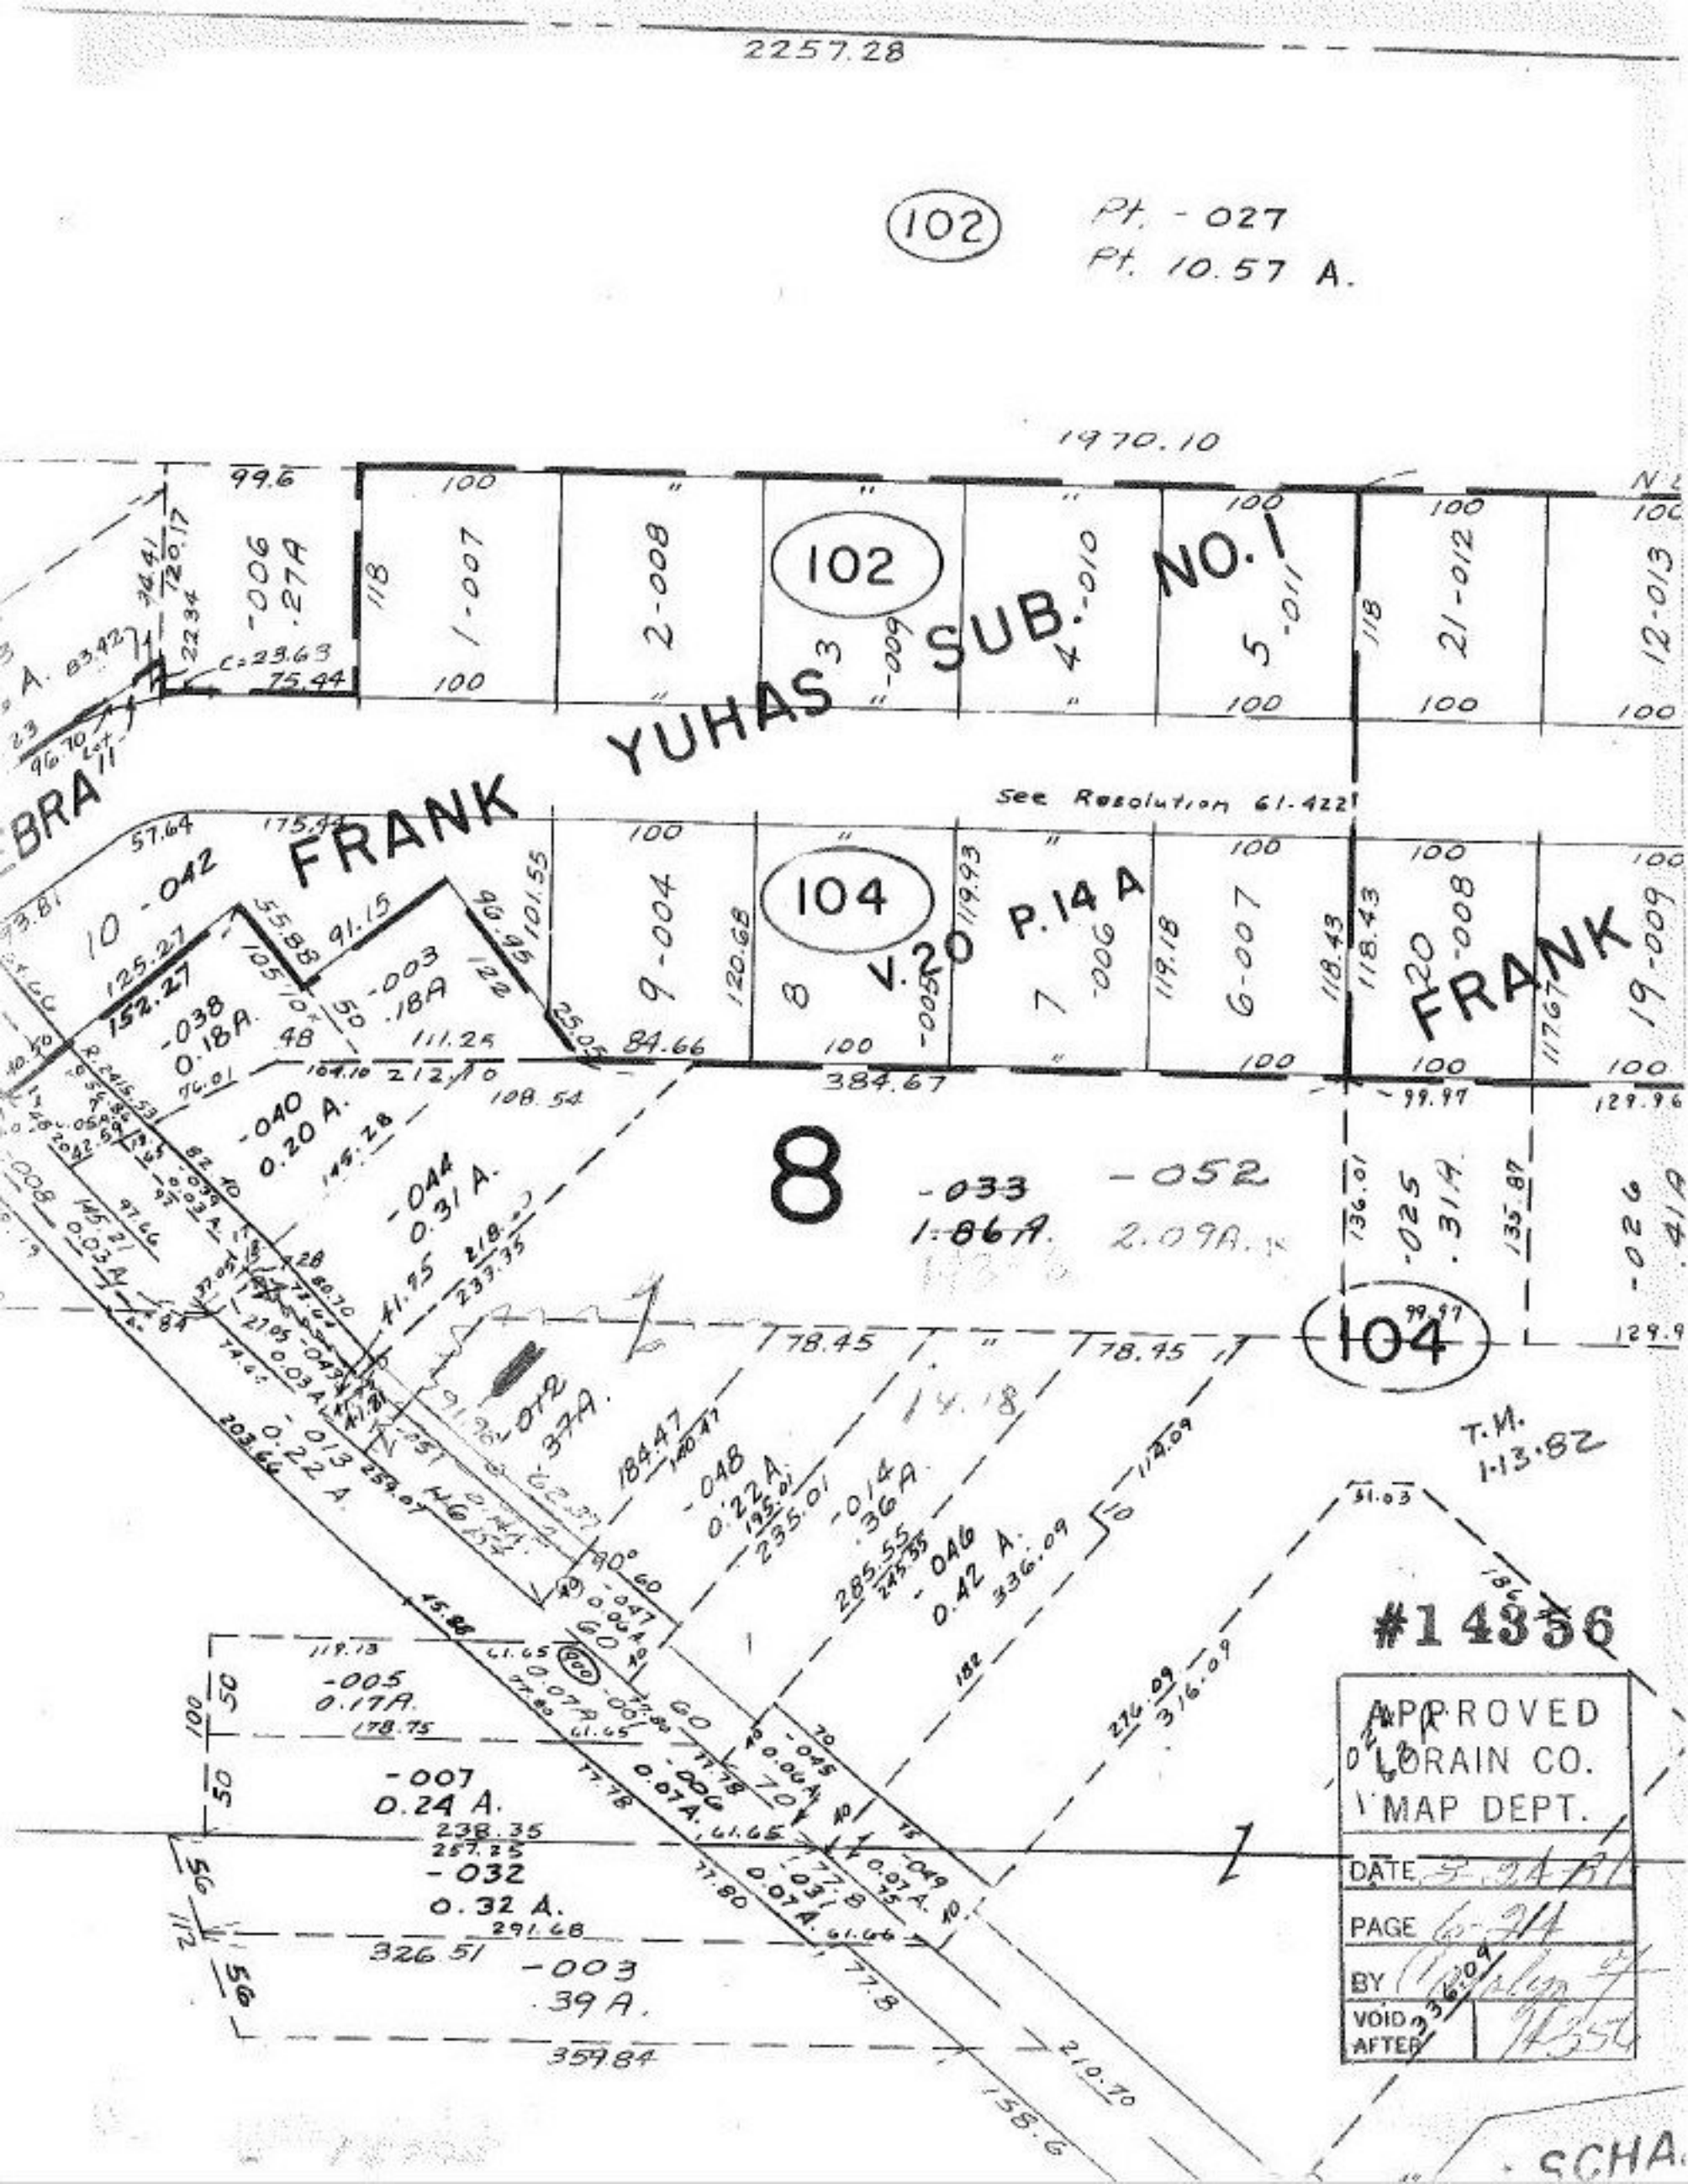

2257.28
102
Pt. -027
Pt. 10.57 A.
1970.10
102
FRANK YUHAS SUB. NO. 1
See Resolution 61-422
104
V.20 P.14 A
FRANK
8
-033
1.86A.
-052
2.09A.
104
T.M.
1-13-82
#14356
APPROVED
LORAIN CO.
MAP DEPT.
DATE
PAGE
BY
VOID AFTER
-005
0.17A.
-007
0.24 A.
-032
0.32 A.
-003
.39 A.
-040
0.20 A.
-044
0.31 A.
-038
0.18A.
-003
.18A
-006
.27A
-012
.37A.
-048
0.22A.
-014
.36A
-046
0.42 A.
-025
.31A
-026
.41A
-013
0.22 A.
-047
0.06A
-006
0.07A.
-031
0.07A.
-049
0.07A.
-045
0.06A
