COMBINATION & SPLIT. Pt. - 065 Pt. 941A.
4 PARCELS WERE FIRST COMBINED TO MAKE -029 WHICH WAS THEN SPLIT INTO -030 & -031.
ALL PARCELS ARE FRONTAGE & DEPTH.

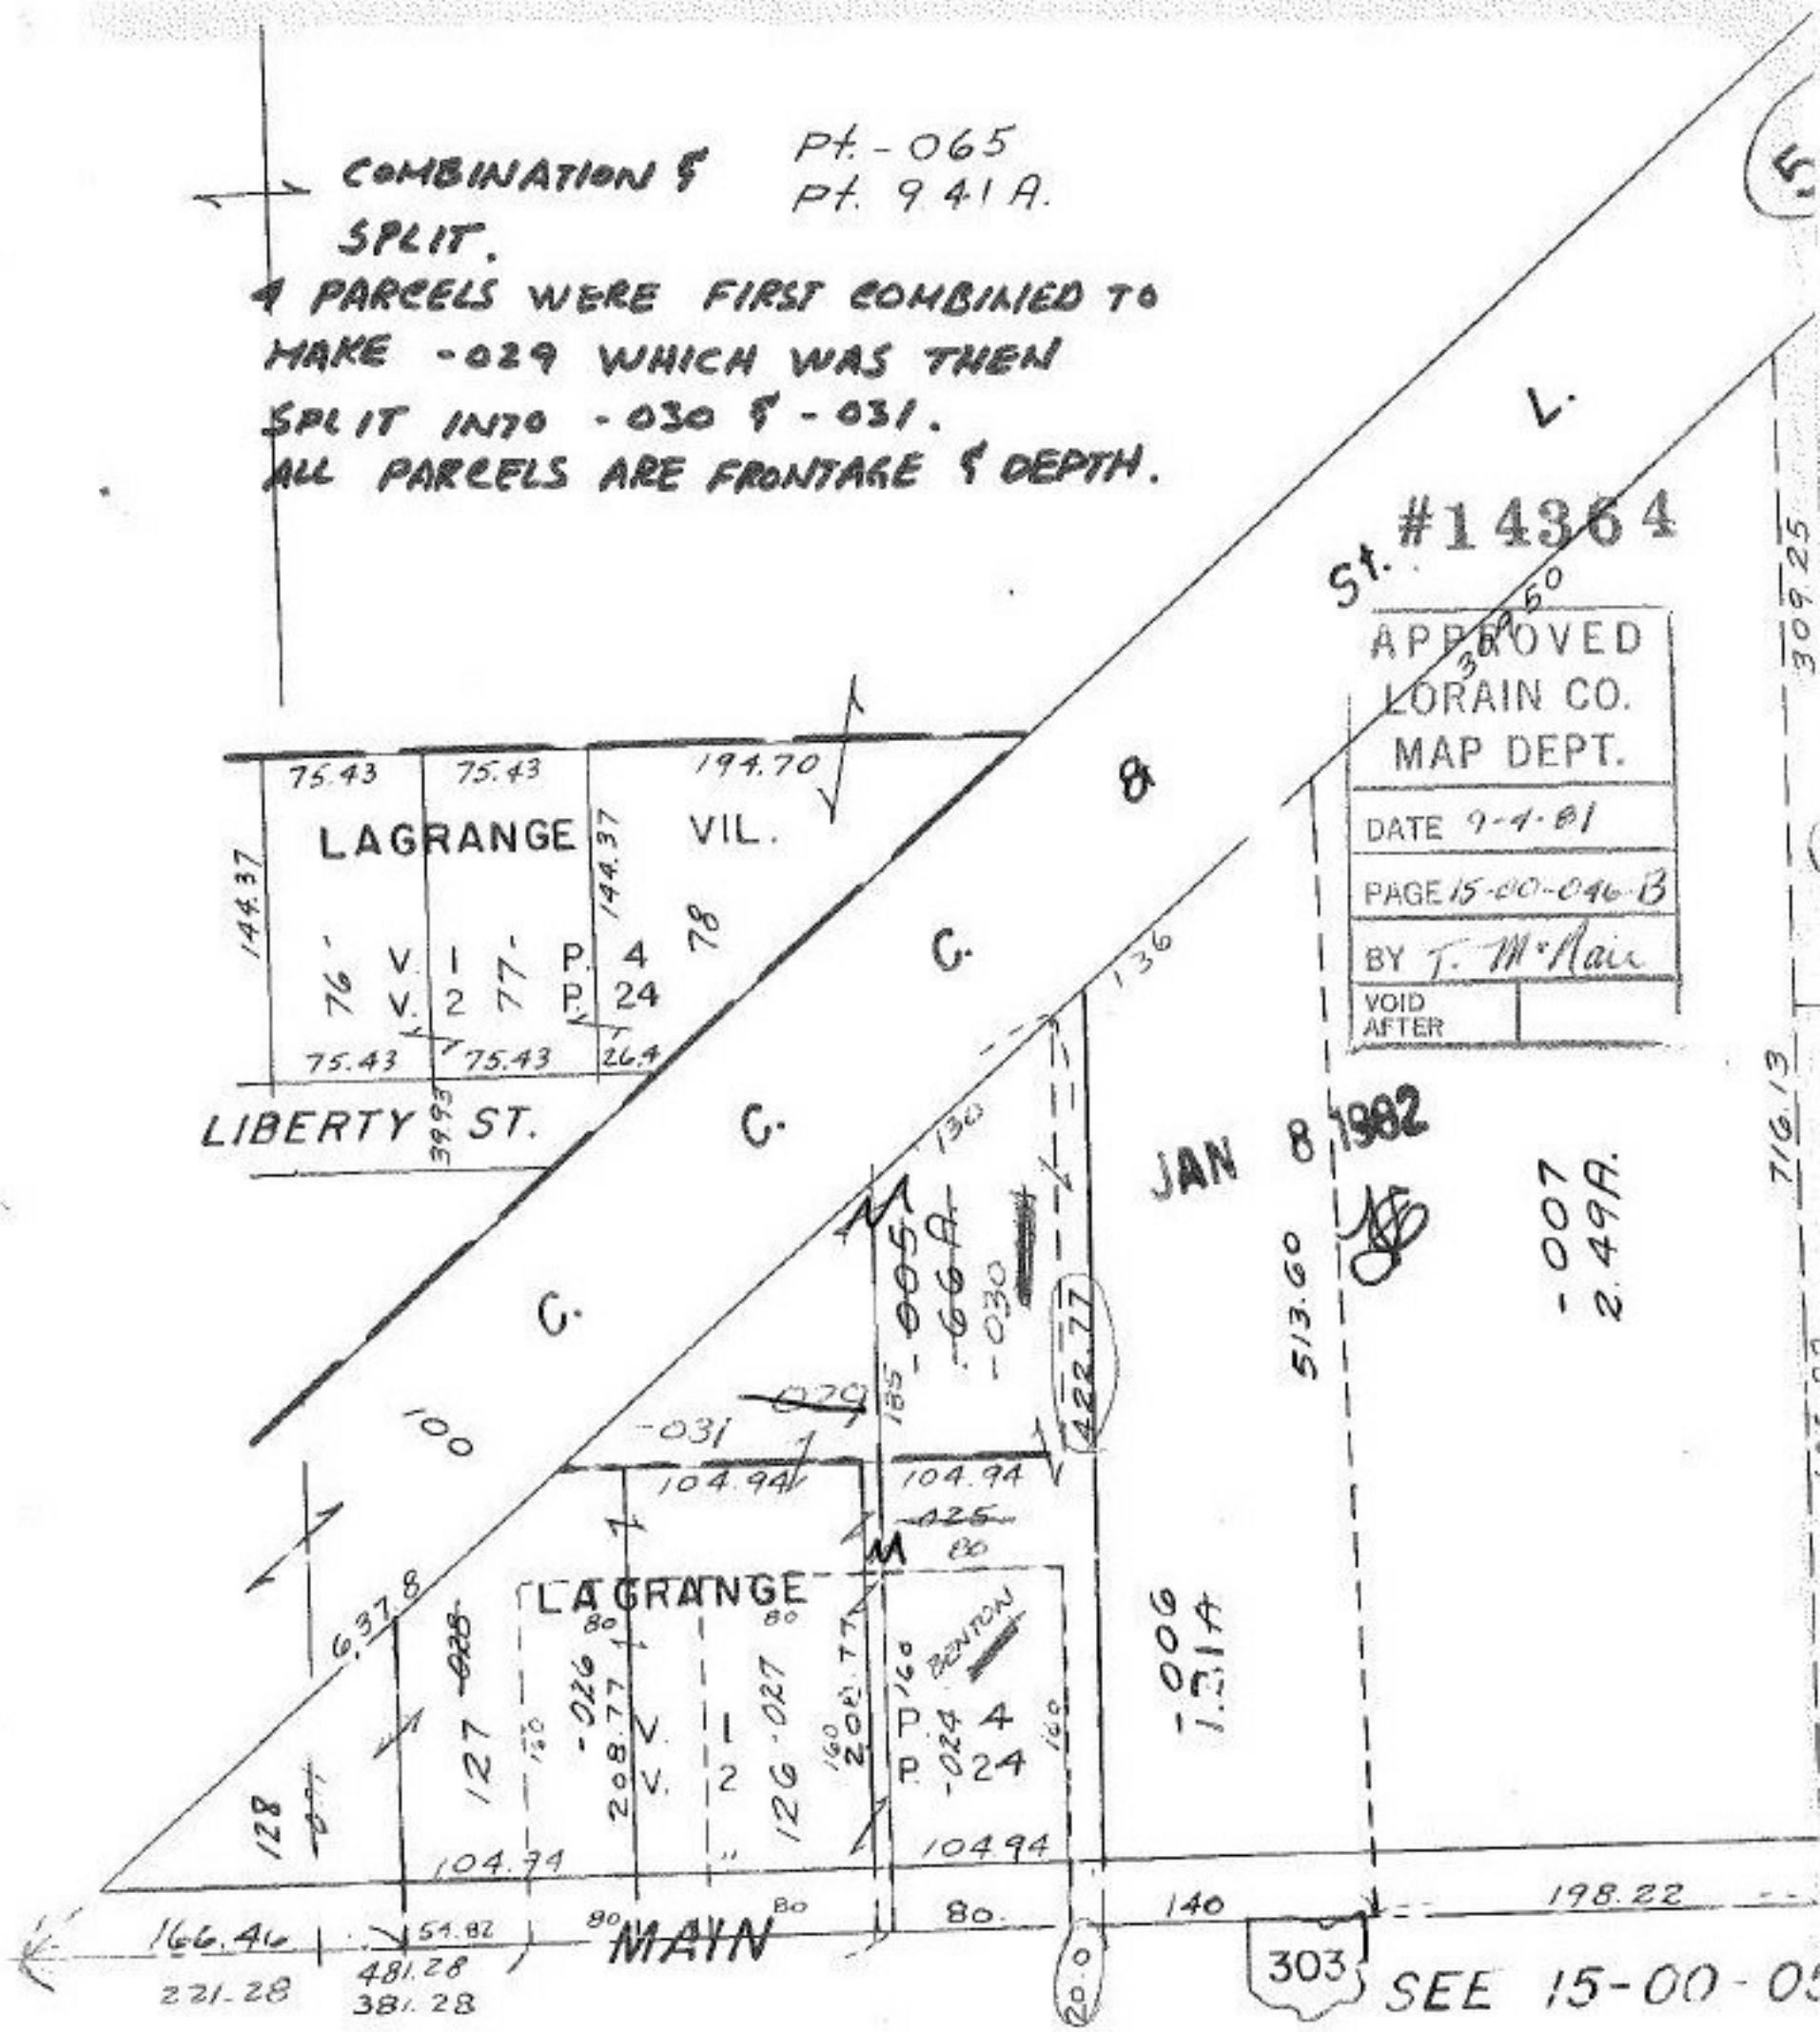

LAGRANGE TWP.

SCALE: 1" = 100'