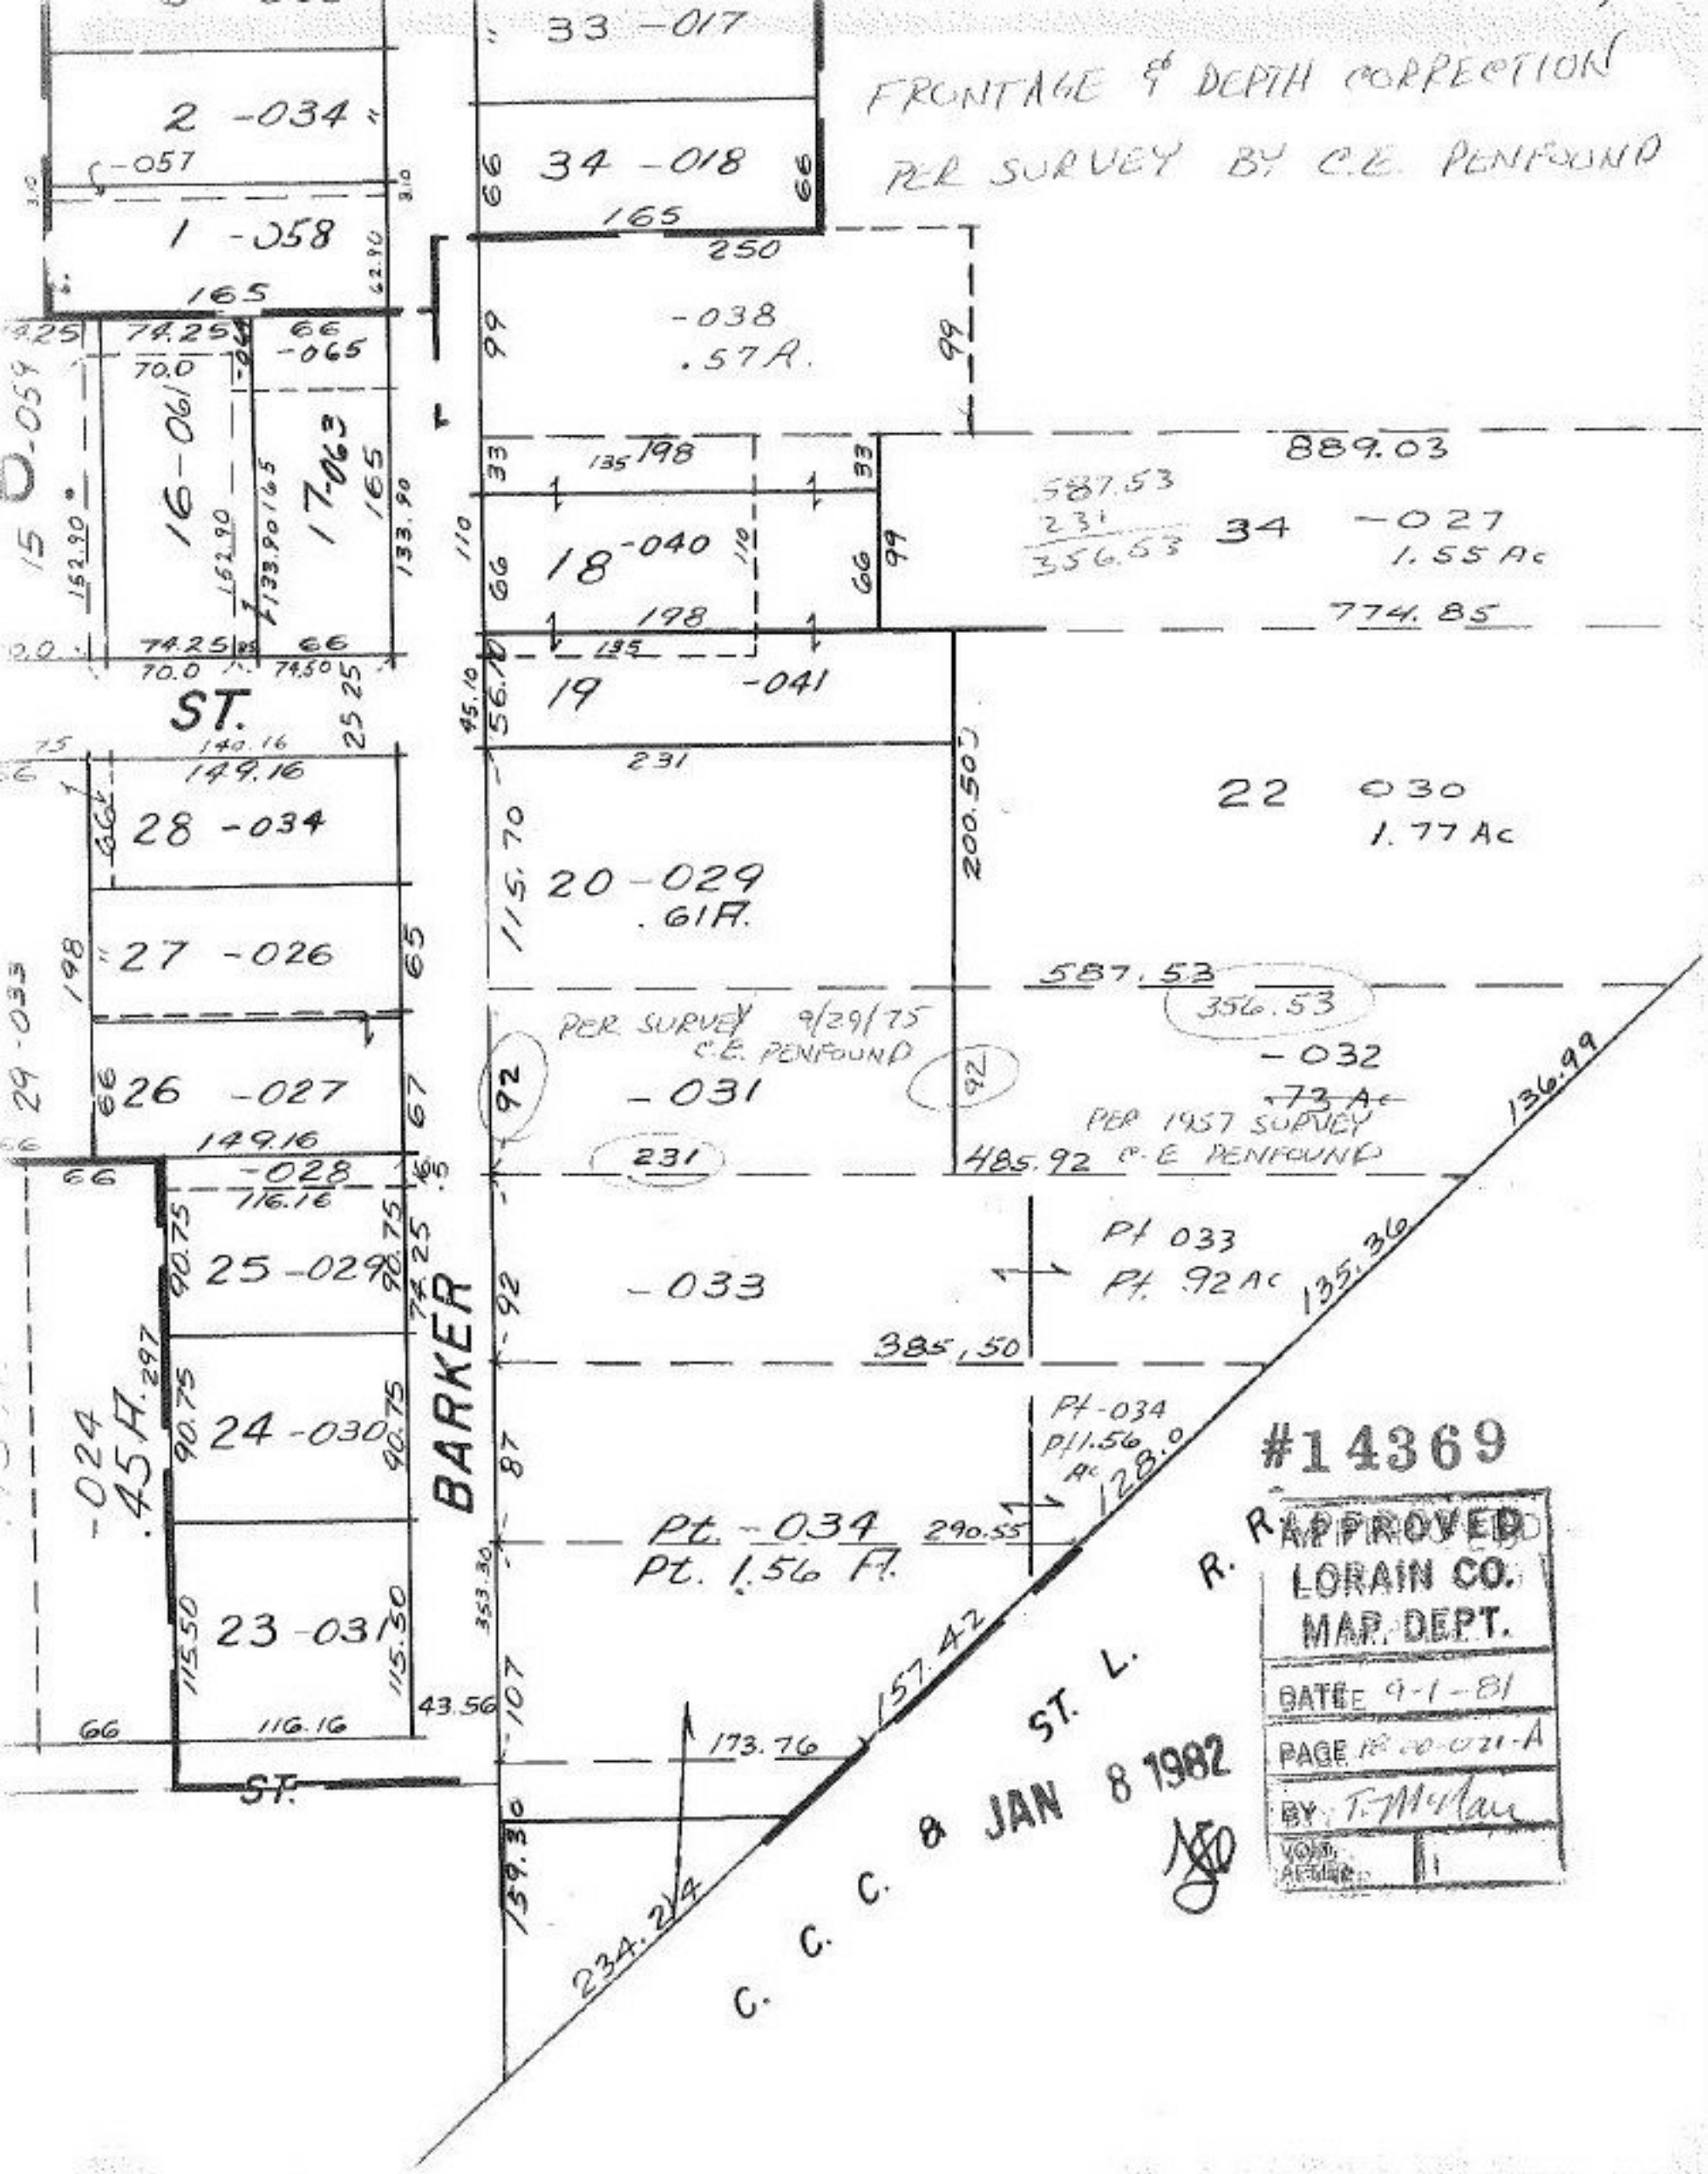
FRONTAGE & DEPTH CORRECTION
PER SURVEY BY C.E. PENFOUND
33 -017
2 -034
-057
34 -018
1 -058
165
250
-038
.57A.
16-061
17-063
-065
889.03
587.53
231
356.53
34 -027
1.55 Ac
18 -040
774.85
19 -041
ST.
28 -034
22 030
1.77 Ac
20 -029
.61A.
200.50
27 -026
587.53
356.53
PER SURVEY 9/29/75
C.E. PENFOUND
-032
26 -027
-031
.73 Ac
PER 1957 SURVEY
C.E. PENFOUND
485.92
-028
25 -029
-033
Pt 033
Pt. .92 Ac
135.36
136.99
BARKER
385.50
24 -030
Pt -034
Pt 1.56 Ac
128.0
-024
.45A.
Pt. -034
Pt. 1.56 A.
290.55
23 -031
157.42
ST. L. R. R.
173.76
ST.
C. C. C. & JAN 8 1982
234.214
#14369
APPROVED
LORAIN CO.
MAP DEPT.
DATE 9-1-81
PAGE 18-00-021-A
BY T. McMan
VOID AFTER