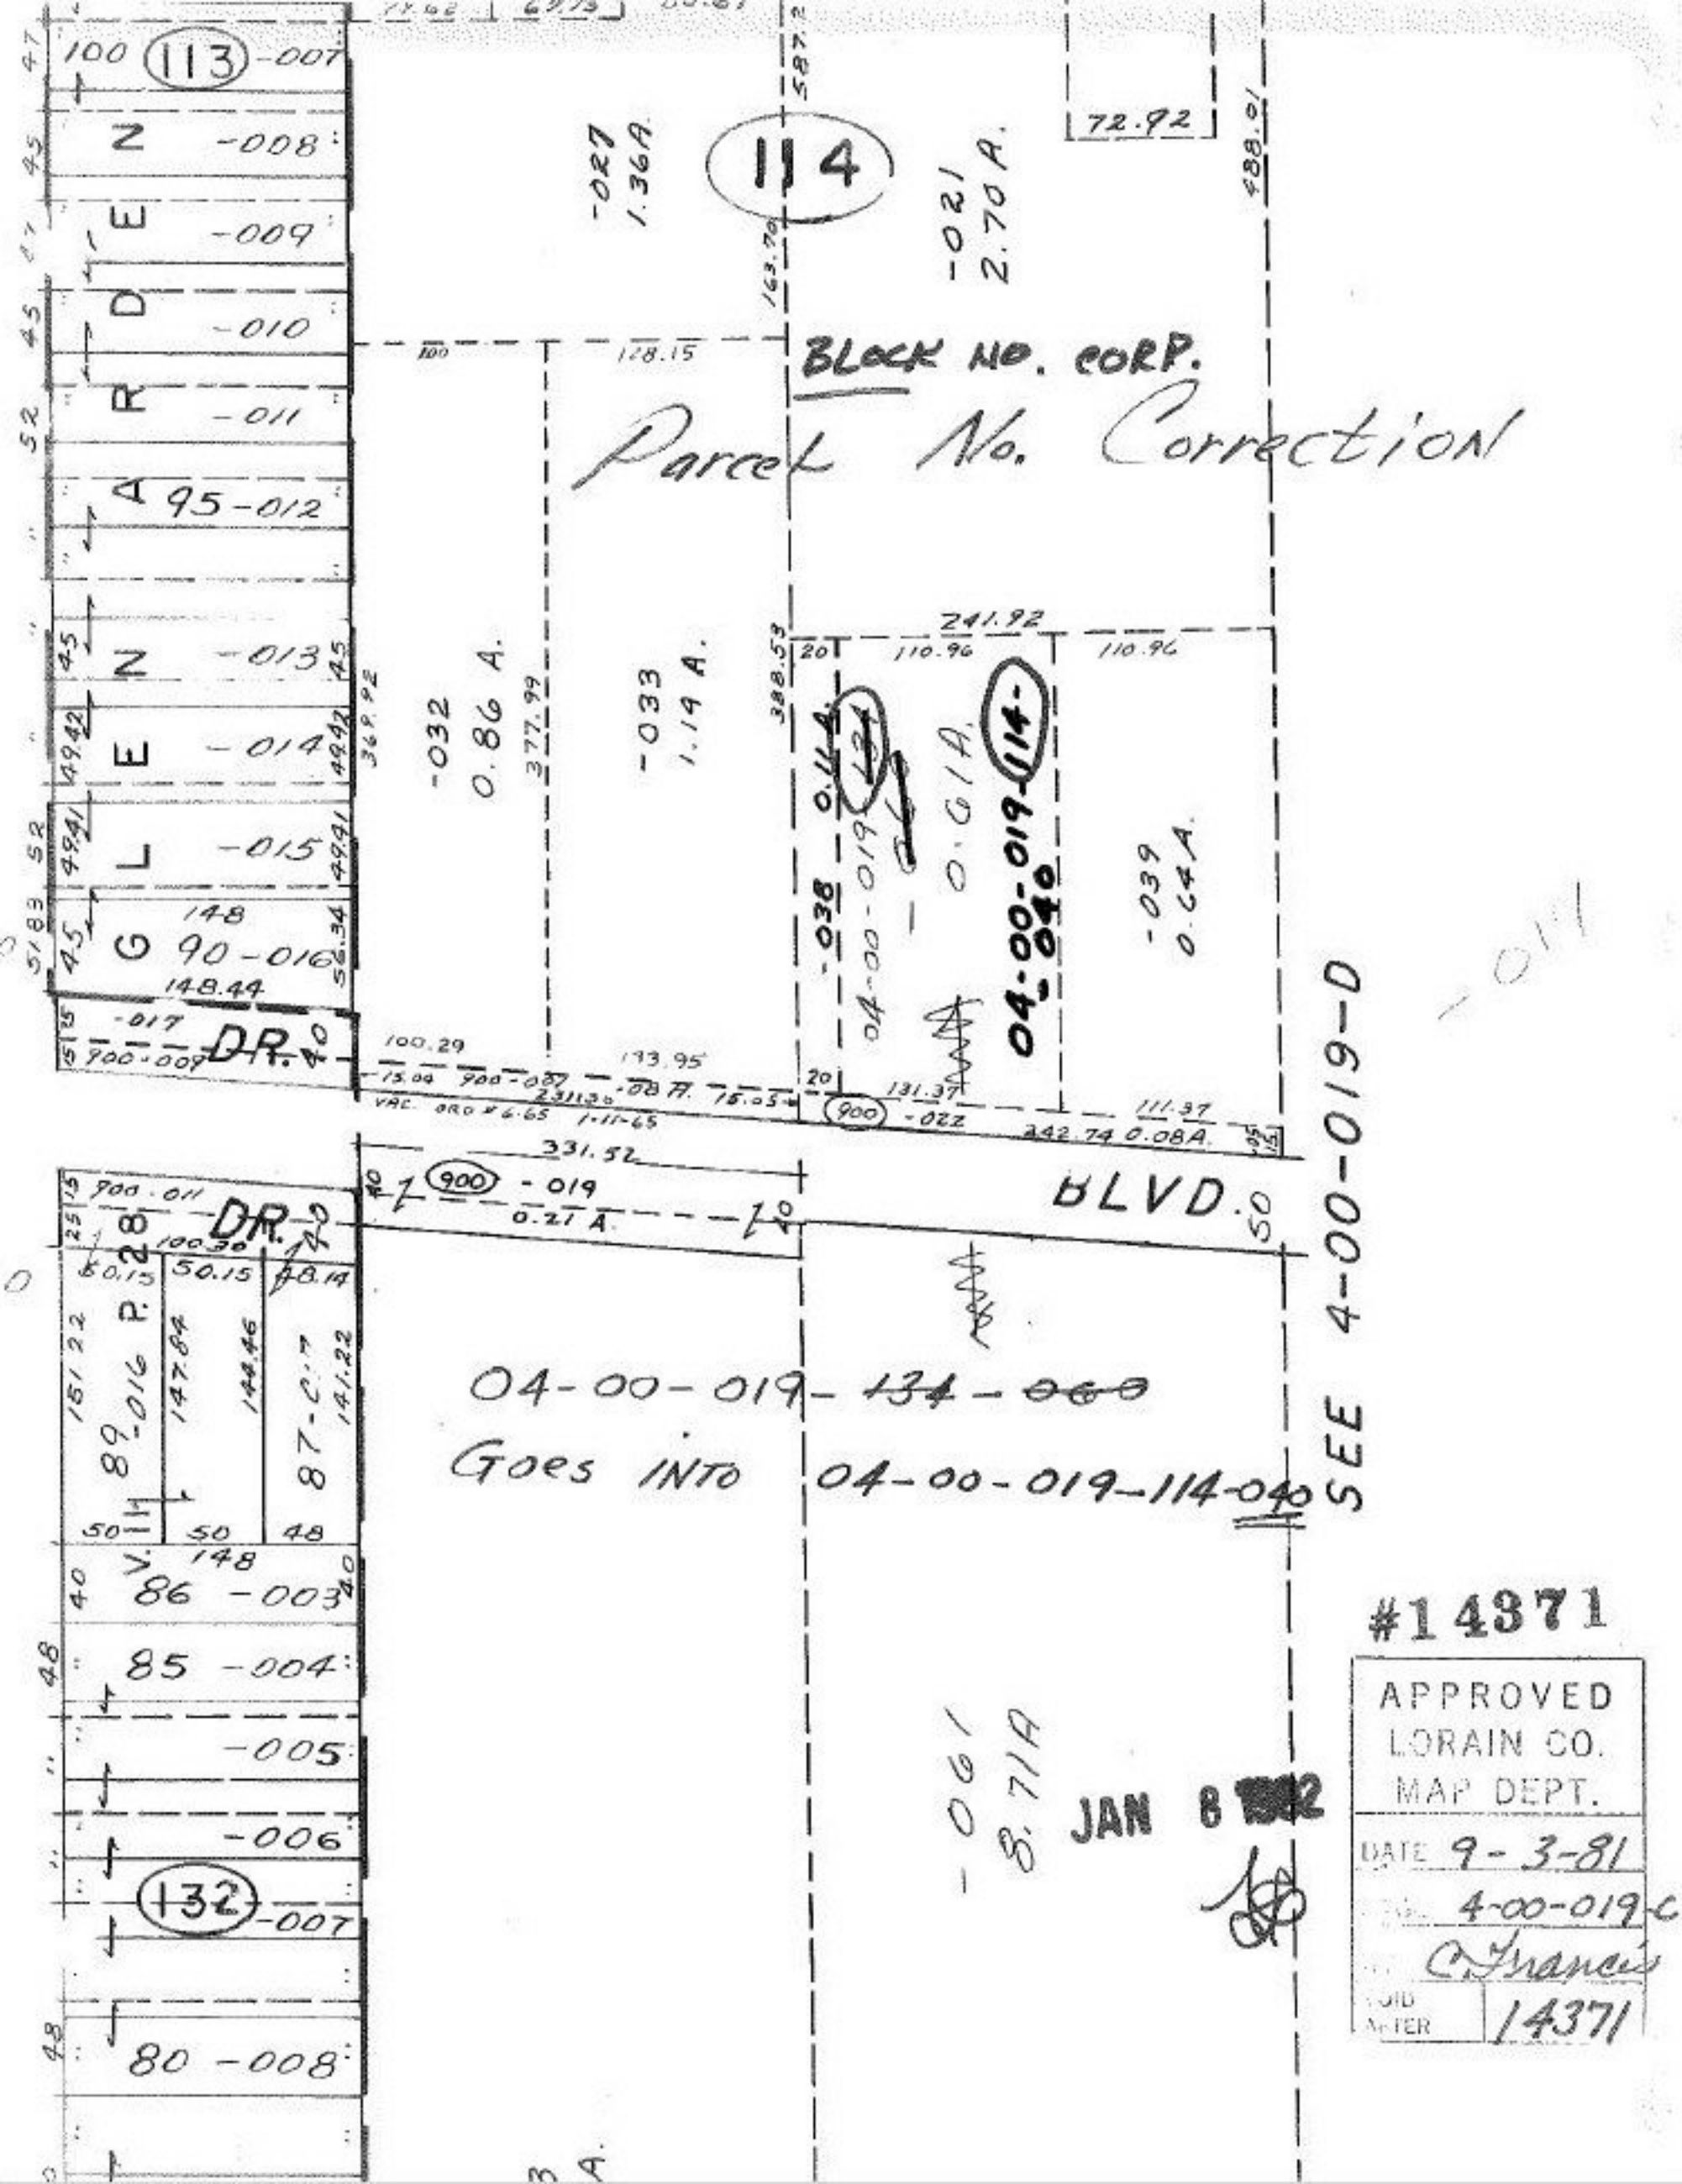

BLOCK NO. CORP.
Parcel No. Correction
114
113
-027 1.36A
-021 2.70 A.
72.92
488.01
-032 0.86 A.
-033 1.14 A.
241.92
110.96
-038 0.11 A.
04-00-019-134
0.61 A.
04-00-019-114-040
-039 0.64 A.
-017
DR.
900-009
900-007
900-022
900-019
0.21 A.
331.52
BLVD.
SEE 4-00-019-D
04-00-019-134-060
Goes INTO 04-00-019-114-040
-061 8.71A
132
-007
86 -003
85 -004
-005
-006
80 -008
#14371
APPROVED
LORAIN CO.
MAP DEPT.
DATE 9-3-81
4-00-019-C
C. Francis
VOID AFTER 14371
JAN 8