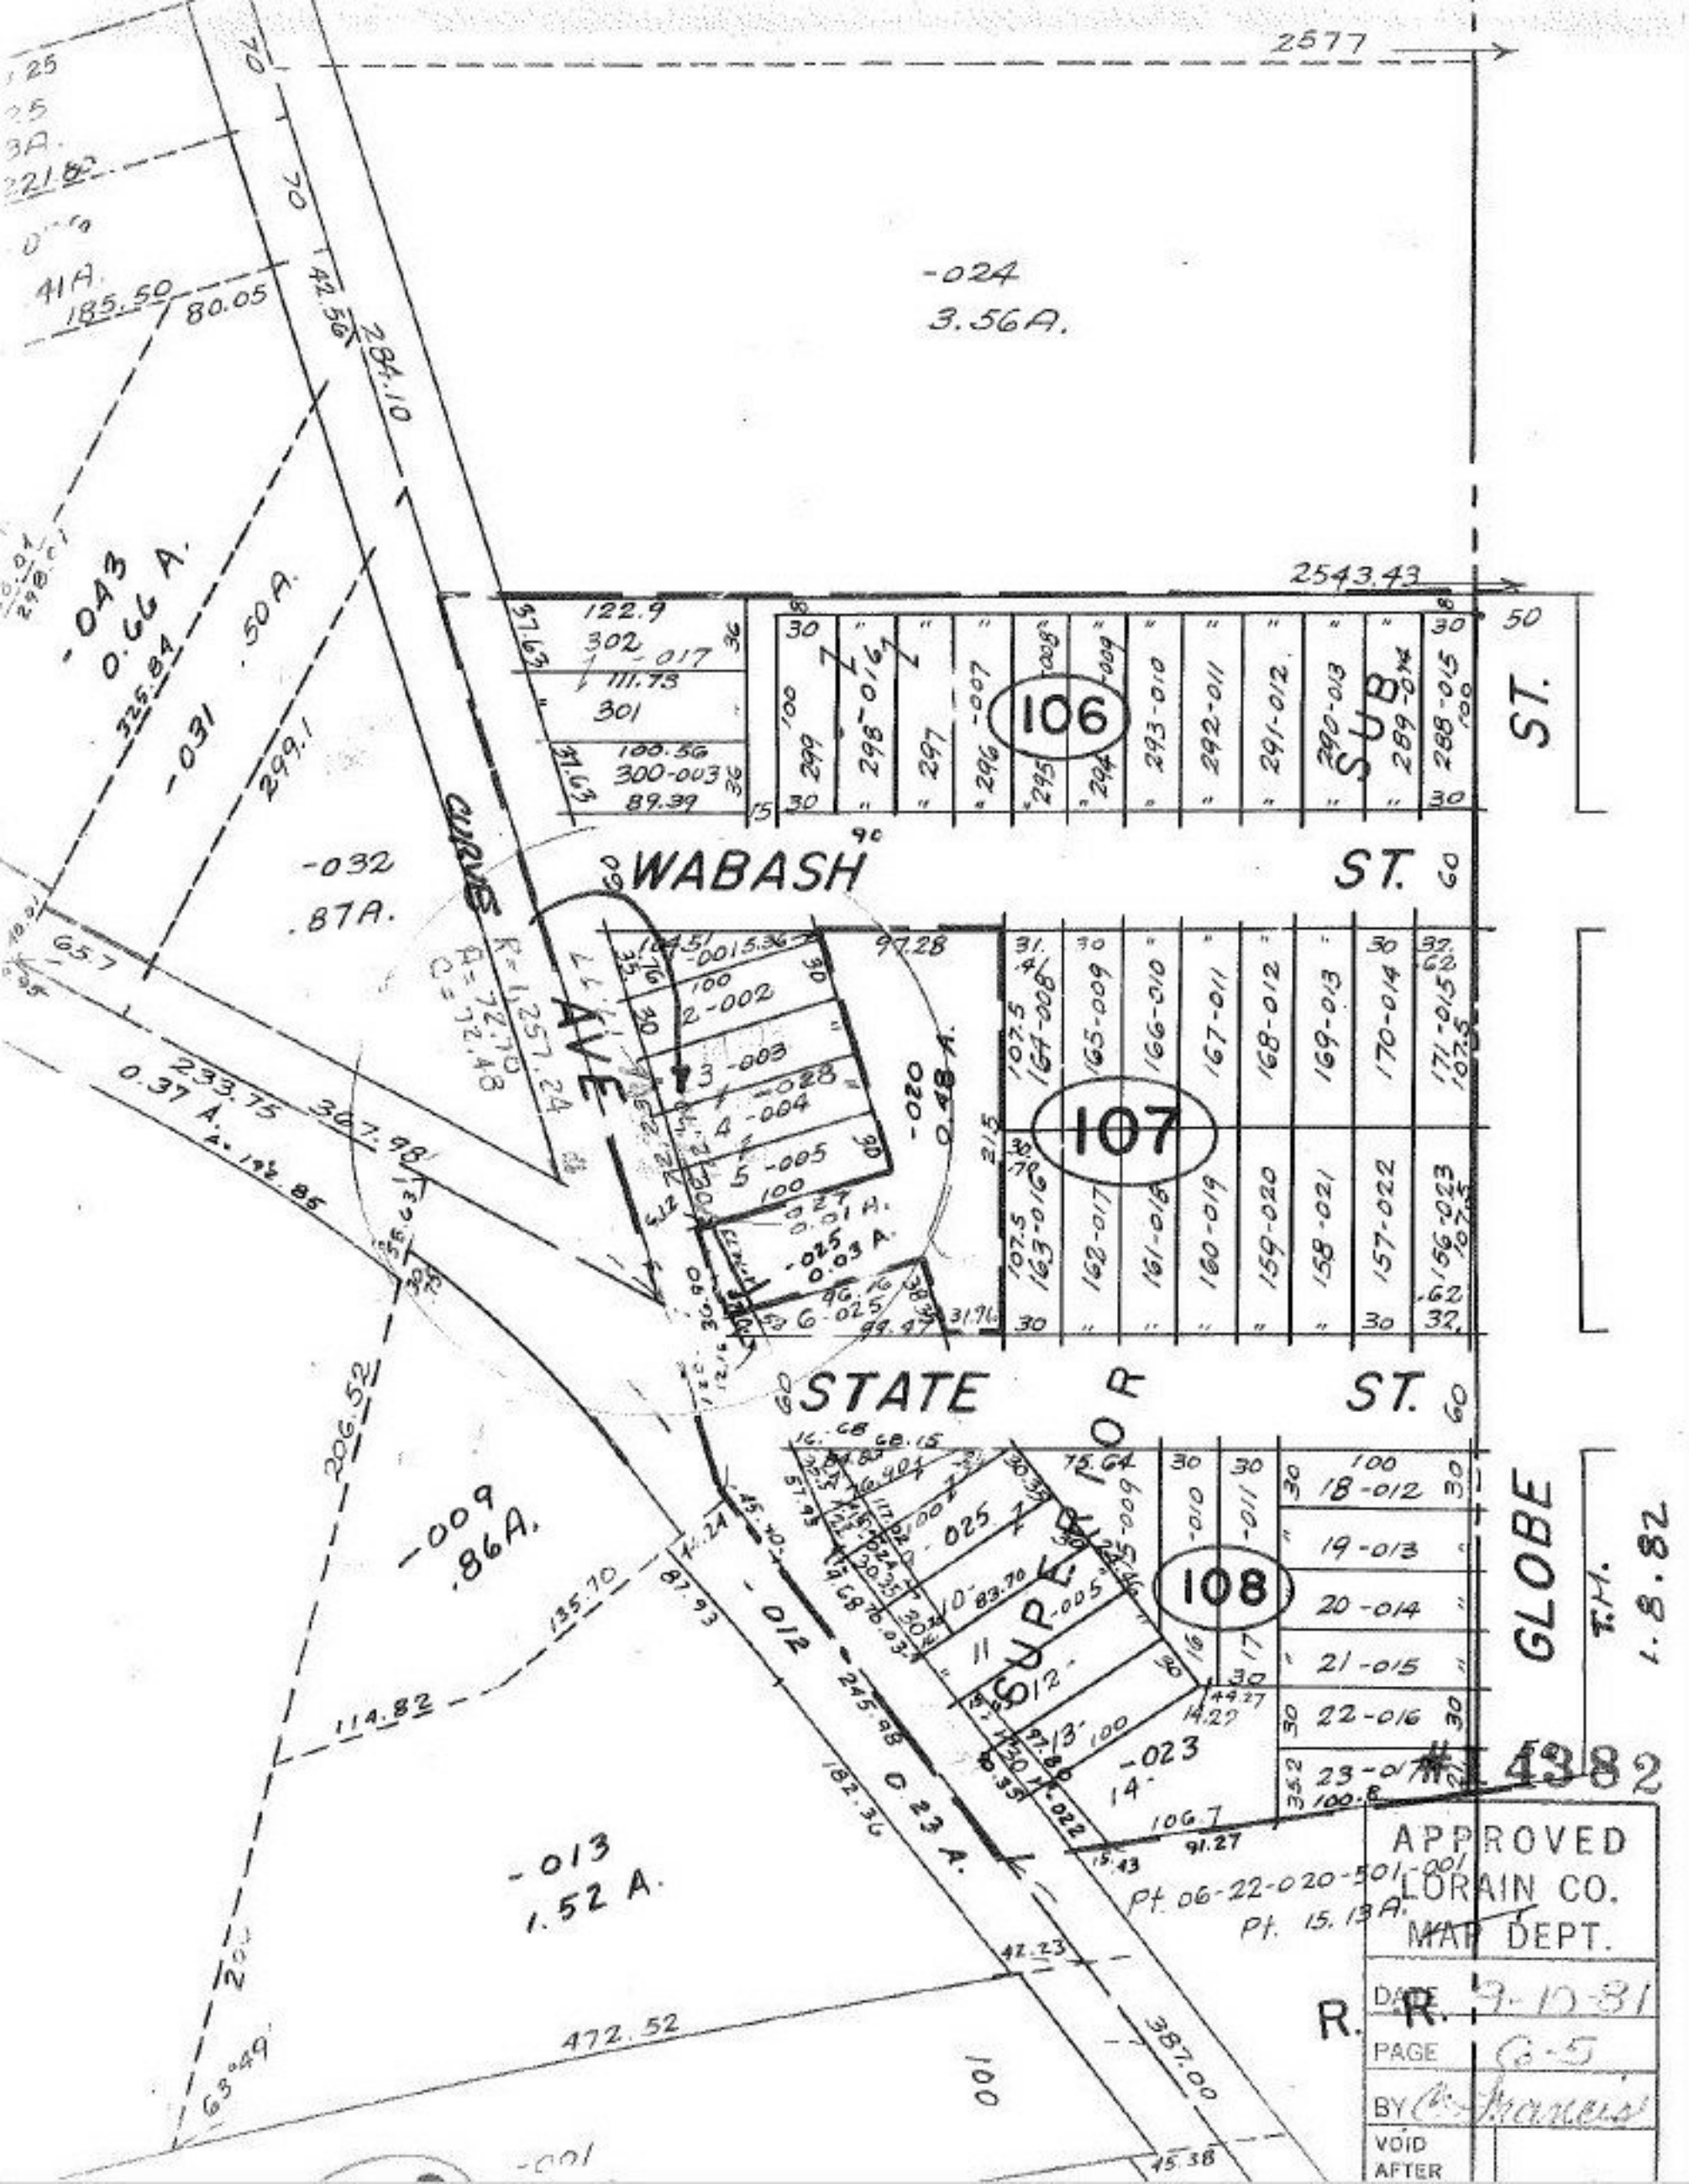

2577
-024
3.56A.
2543.43
WABASH ST.
STATE ST.
GLOBE ST.
SUPERIOR
SUB
106
107
108
CURVE
AVE
-043
0.66 A.
-031
.50A.
-032
.87A.
-009
.86A.
-013
1.52 A.
-020
0.48 A.
-025
0.03 A.
-012
0.23 A.
-023
Pt. 06-22-020-501-001
Pt. 15.13A.
R. R.
T.H.
1.8.82
#14382
APPROVED
LORAIN CO.
MAP DEPT.
DATE 9-10-81
PAGE 6-5
BY
VOID
AFTER