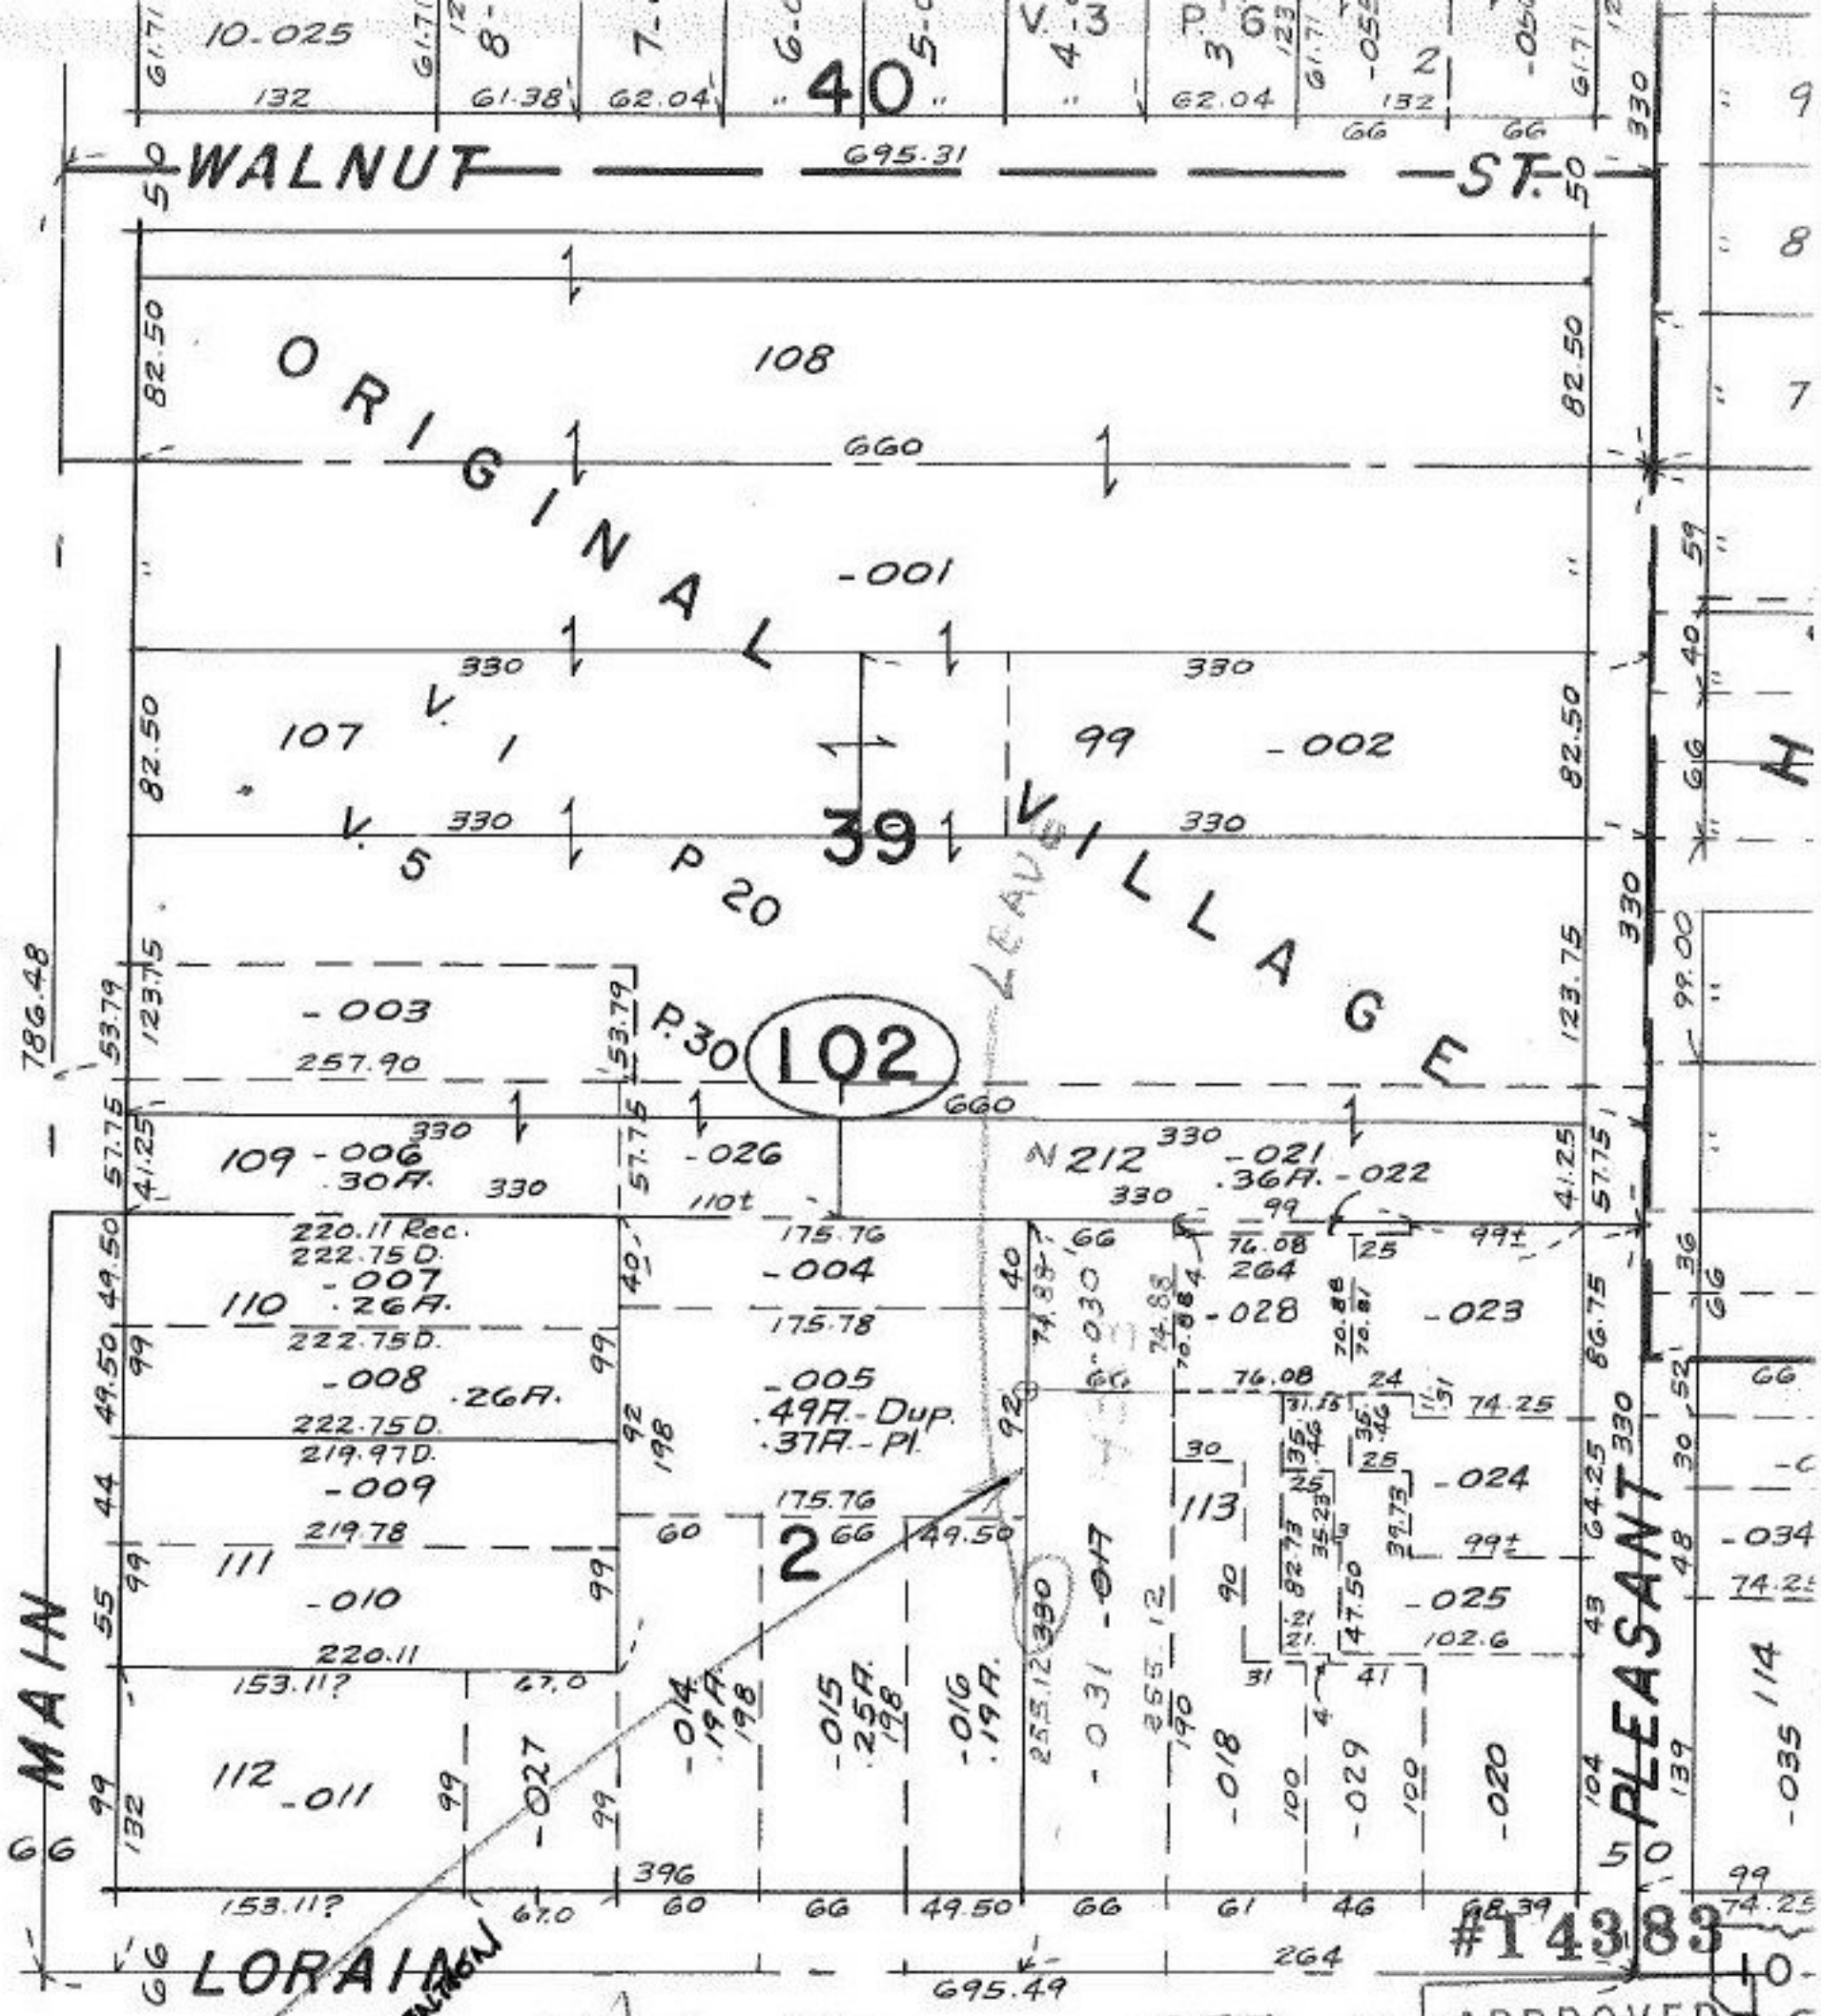
WALNUT ST.
ORIGINAL VILLAGE
MAIN
PLEASANT
LORAIN
LEAVE
#14383
SEE 9-00-086-A
THE OHIO BAPTIST CONVENTION
7/25 44
OBERLIN CITY
RUSSIA TWP
CO. L. 76
333/337
20 RODS X
4 RODS
TITLE GOES TO ℄
JAN 8
APPROVED
LORAIN CO.
MAP DEPT.
DATE 9-11-81
PAGE 9-00-076-A
BY
VOID AFTER