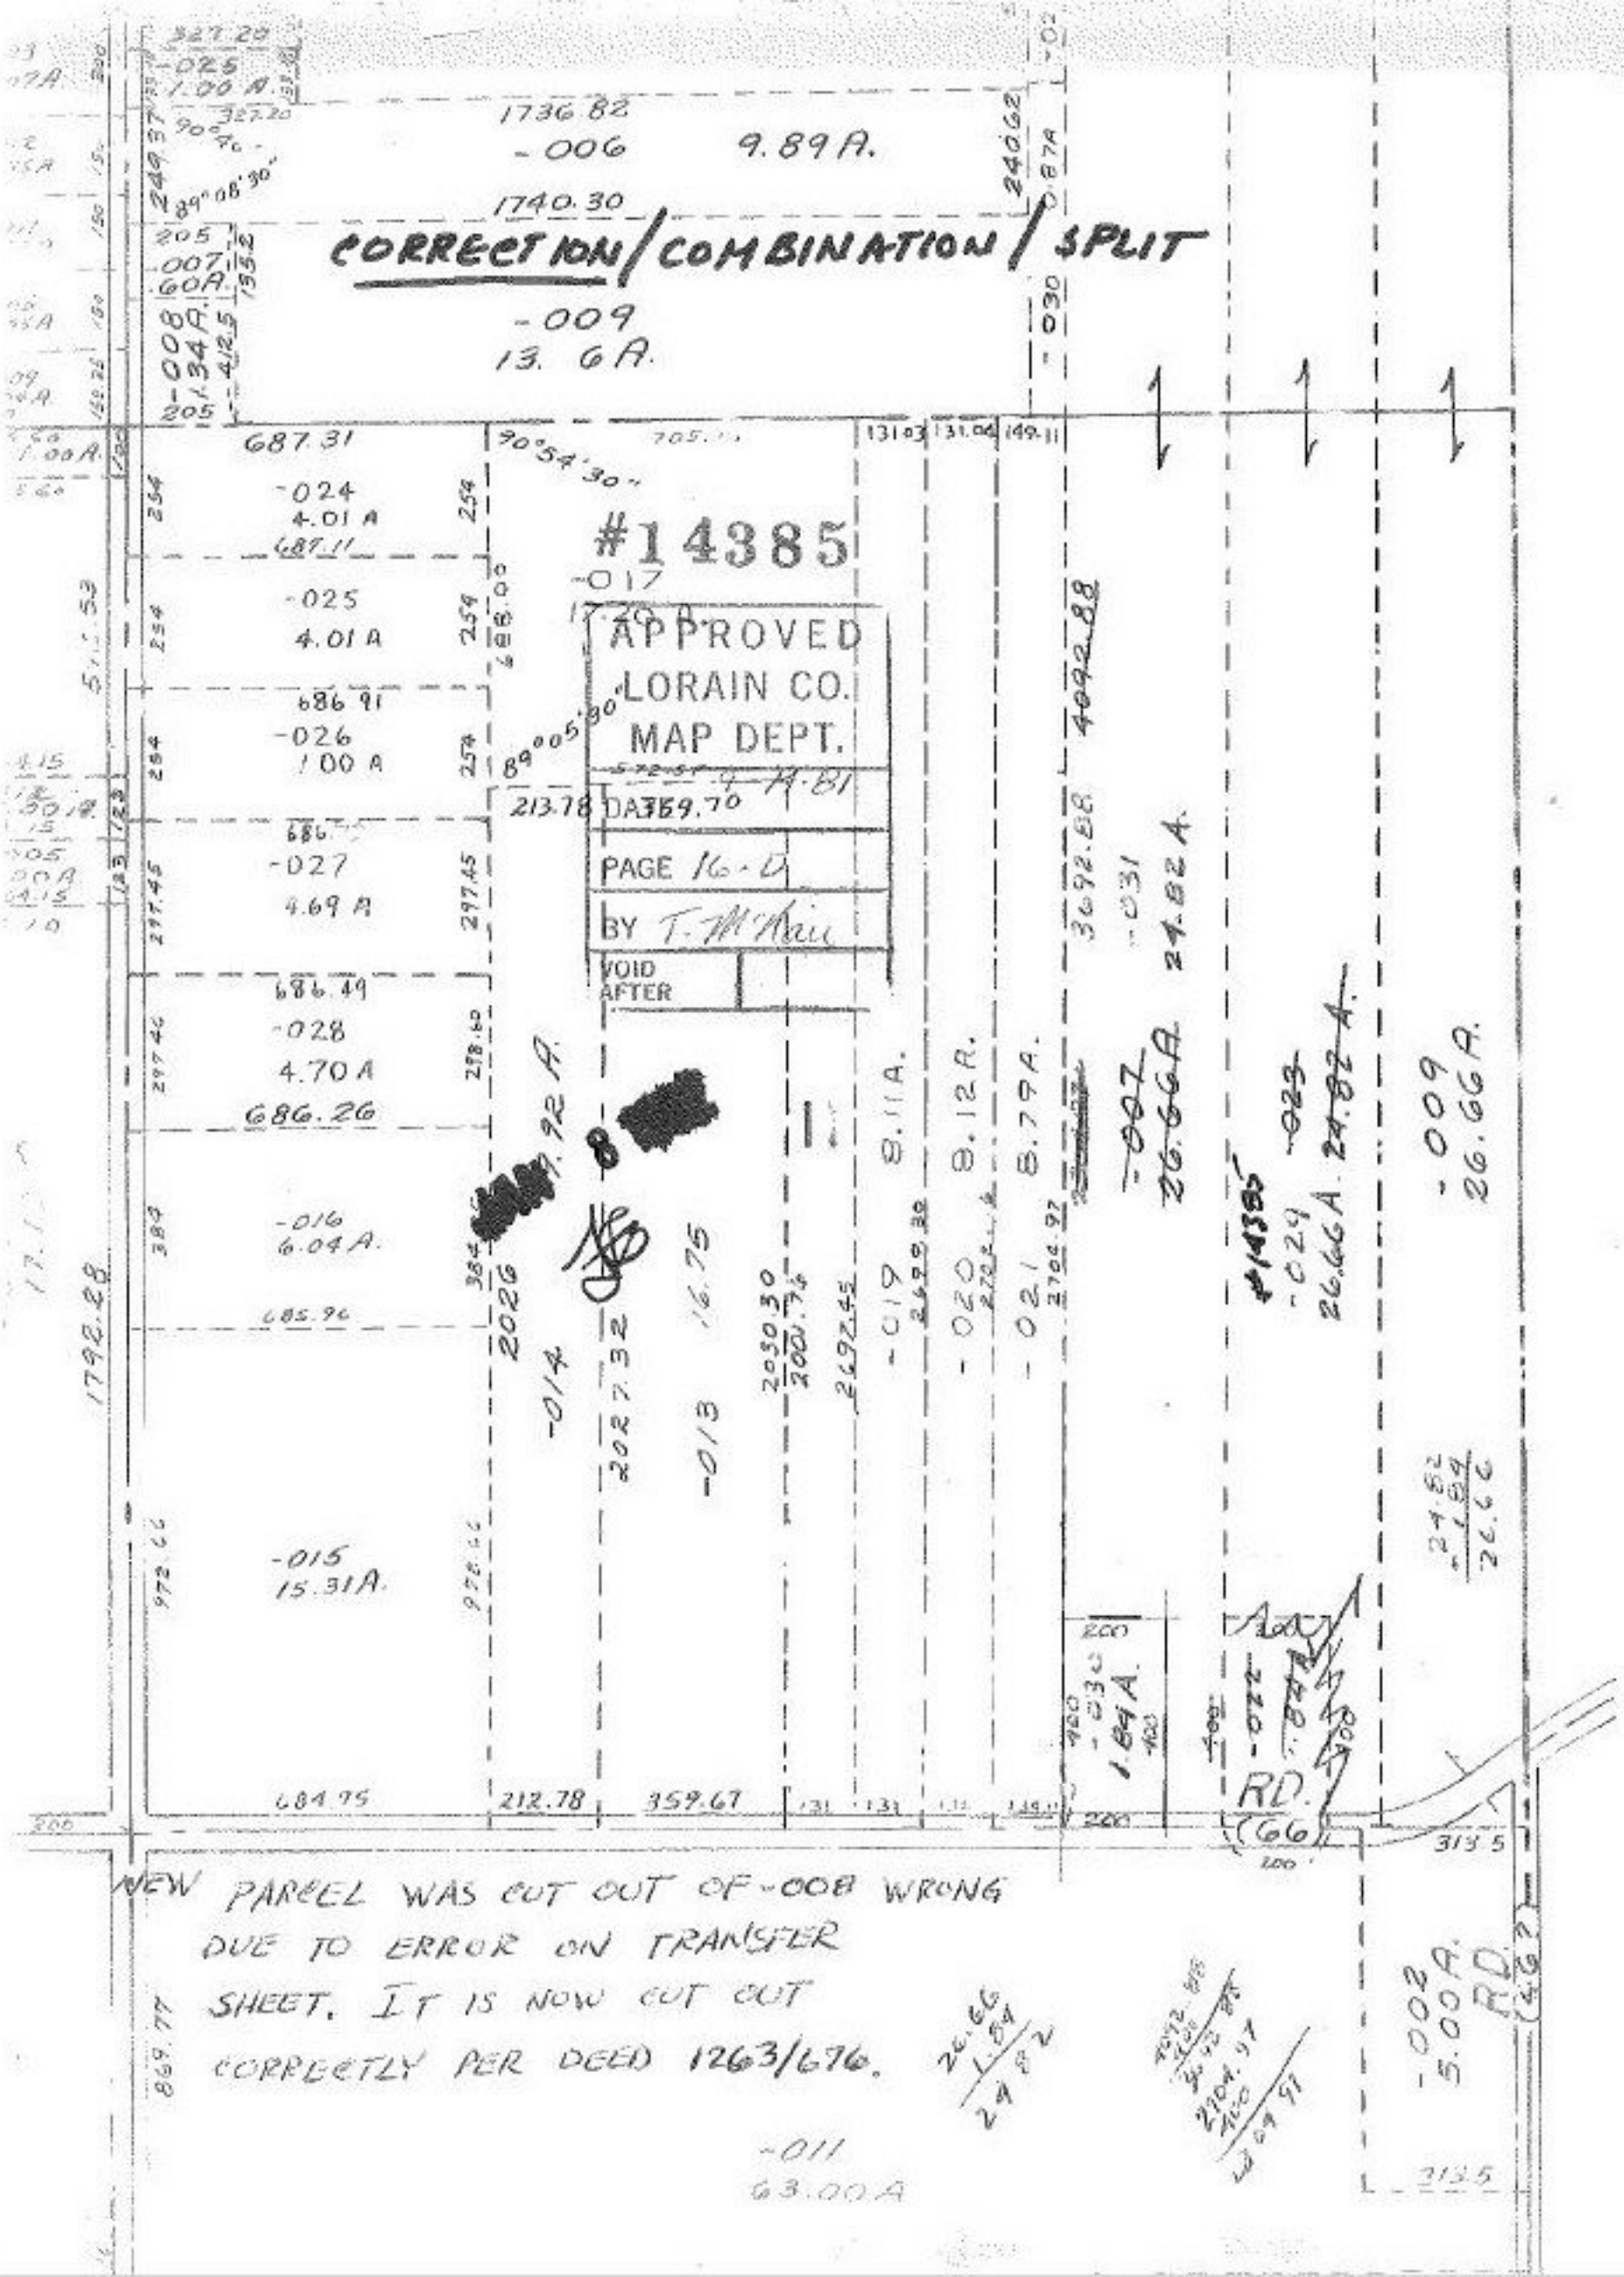

NEW PARCEL WAS CUT OUT OF -008 WRONG DUE TO ERROR ON TRANSFER SHEET. IT IS NOW CUT OUT CORRECTLY PER DEED 1263/676.