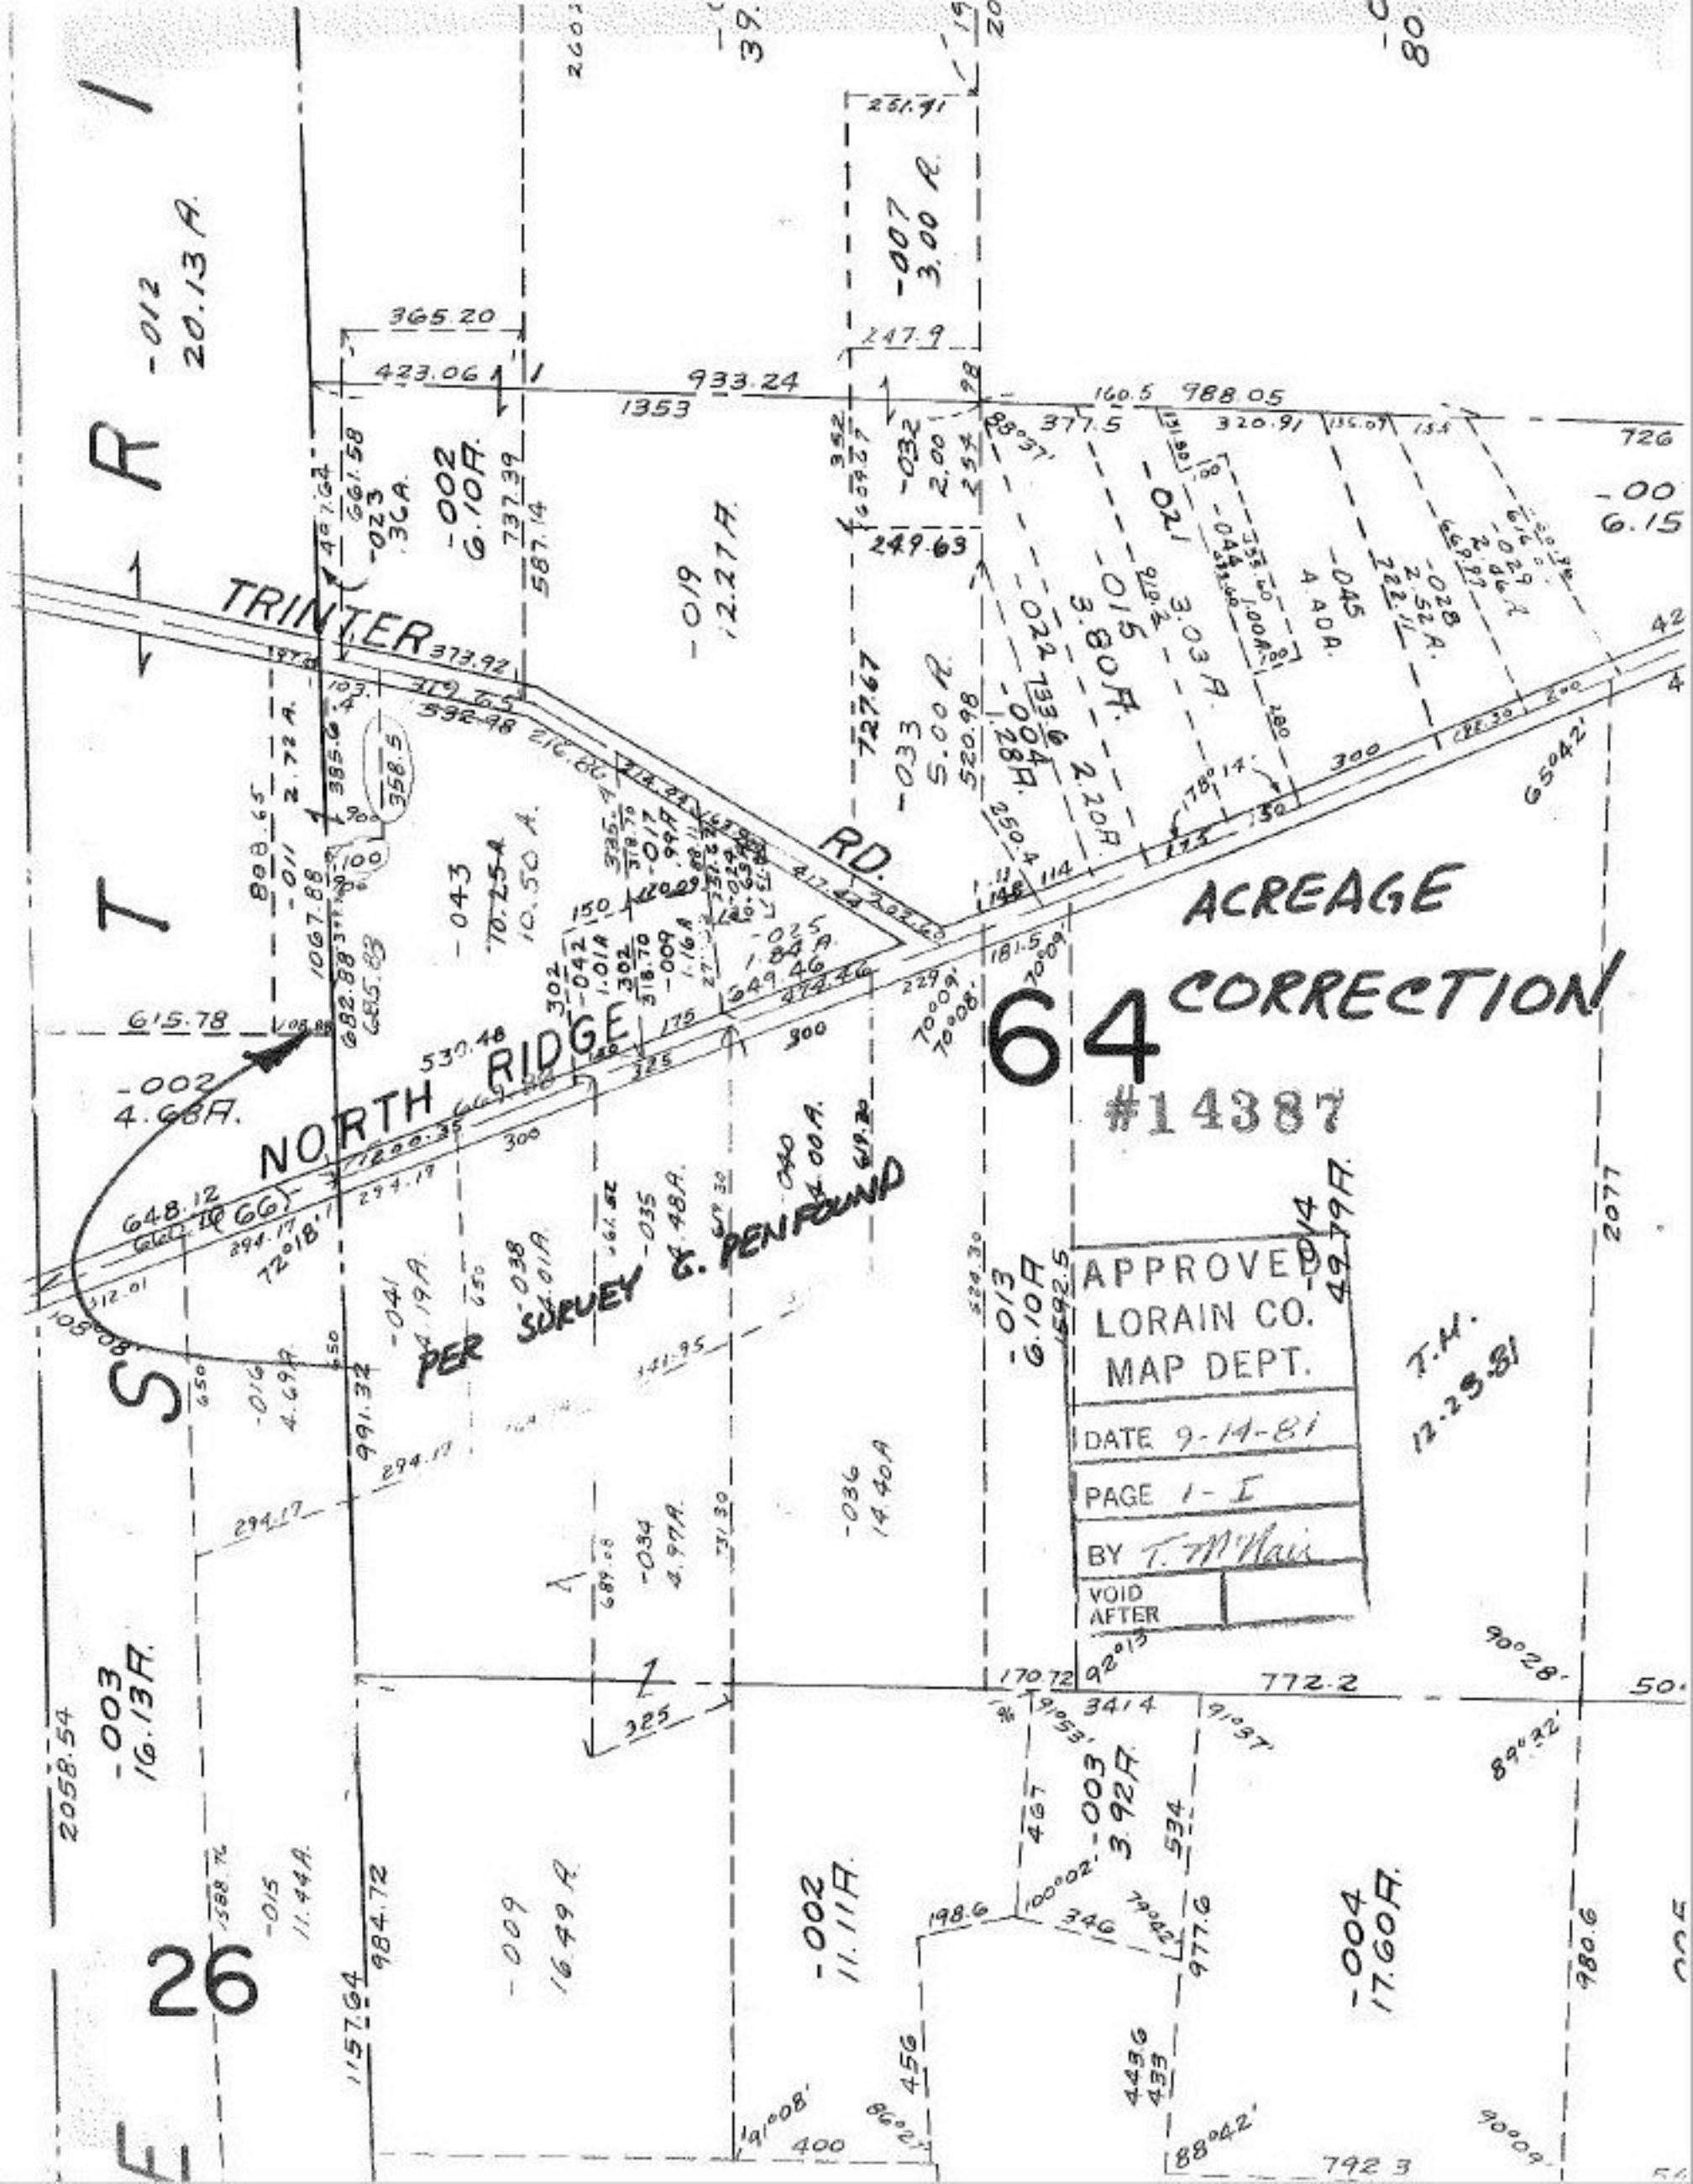

TRINTER RD.
NORTH RIDGE
ACREAGE CORRECTION
64
#14387
PER SURVEY G. PENFOUND
APPROVED
LORAIN CO.
MAP DEPT.
DATE 9-14-81
PAGE 1-I
BY T. McNair
VOID AFTER
T.M. 12-23-81
26