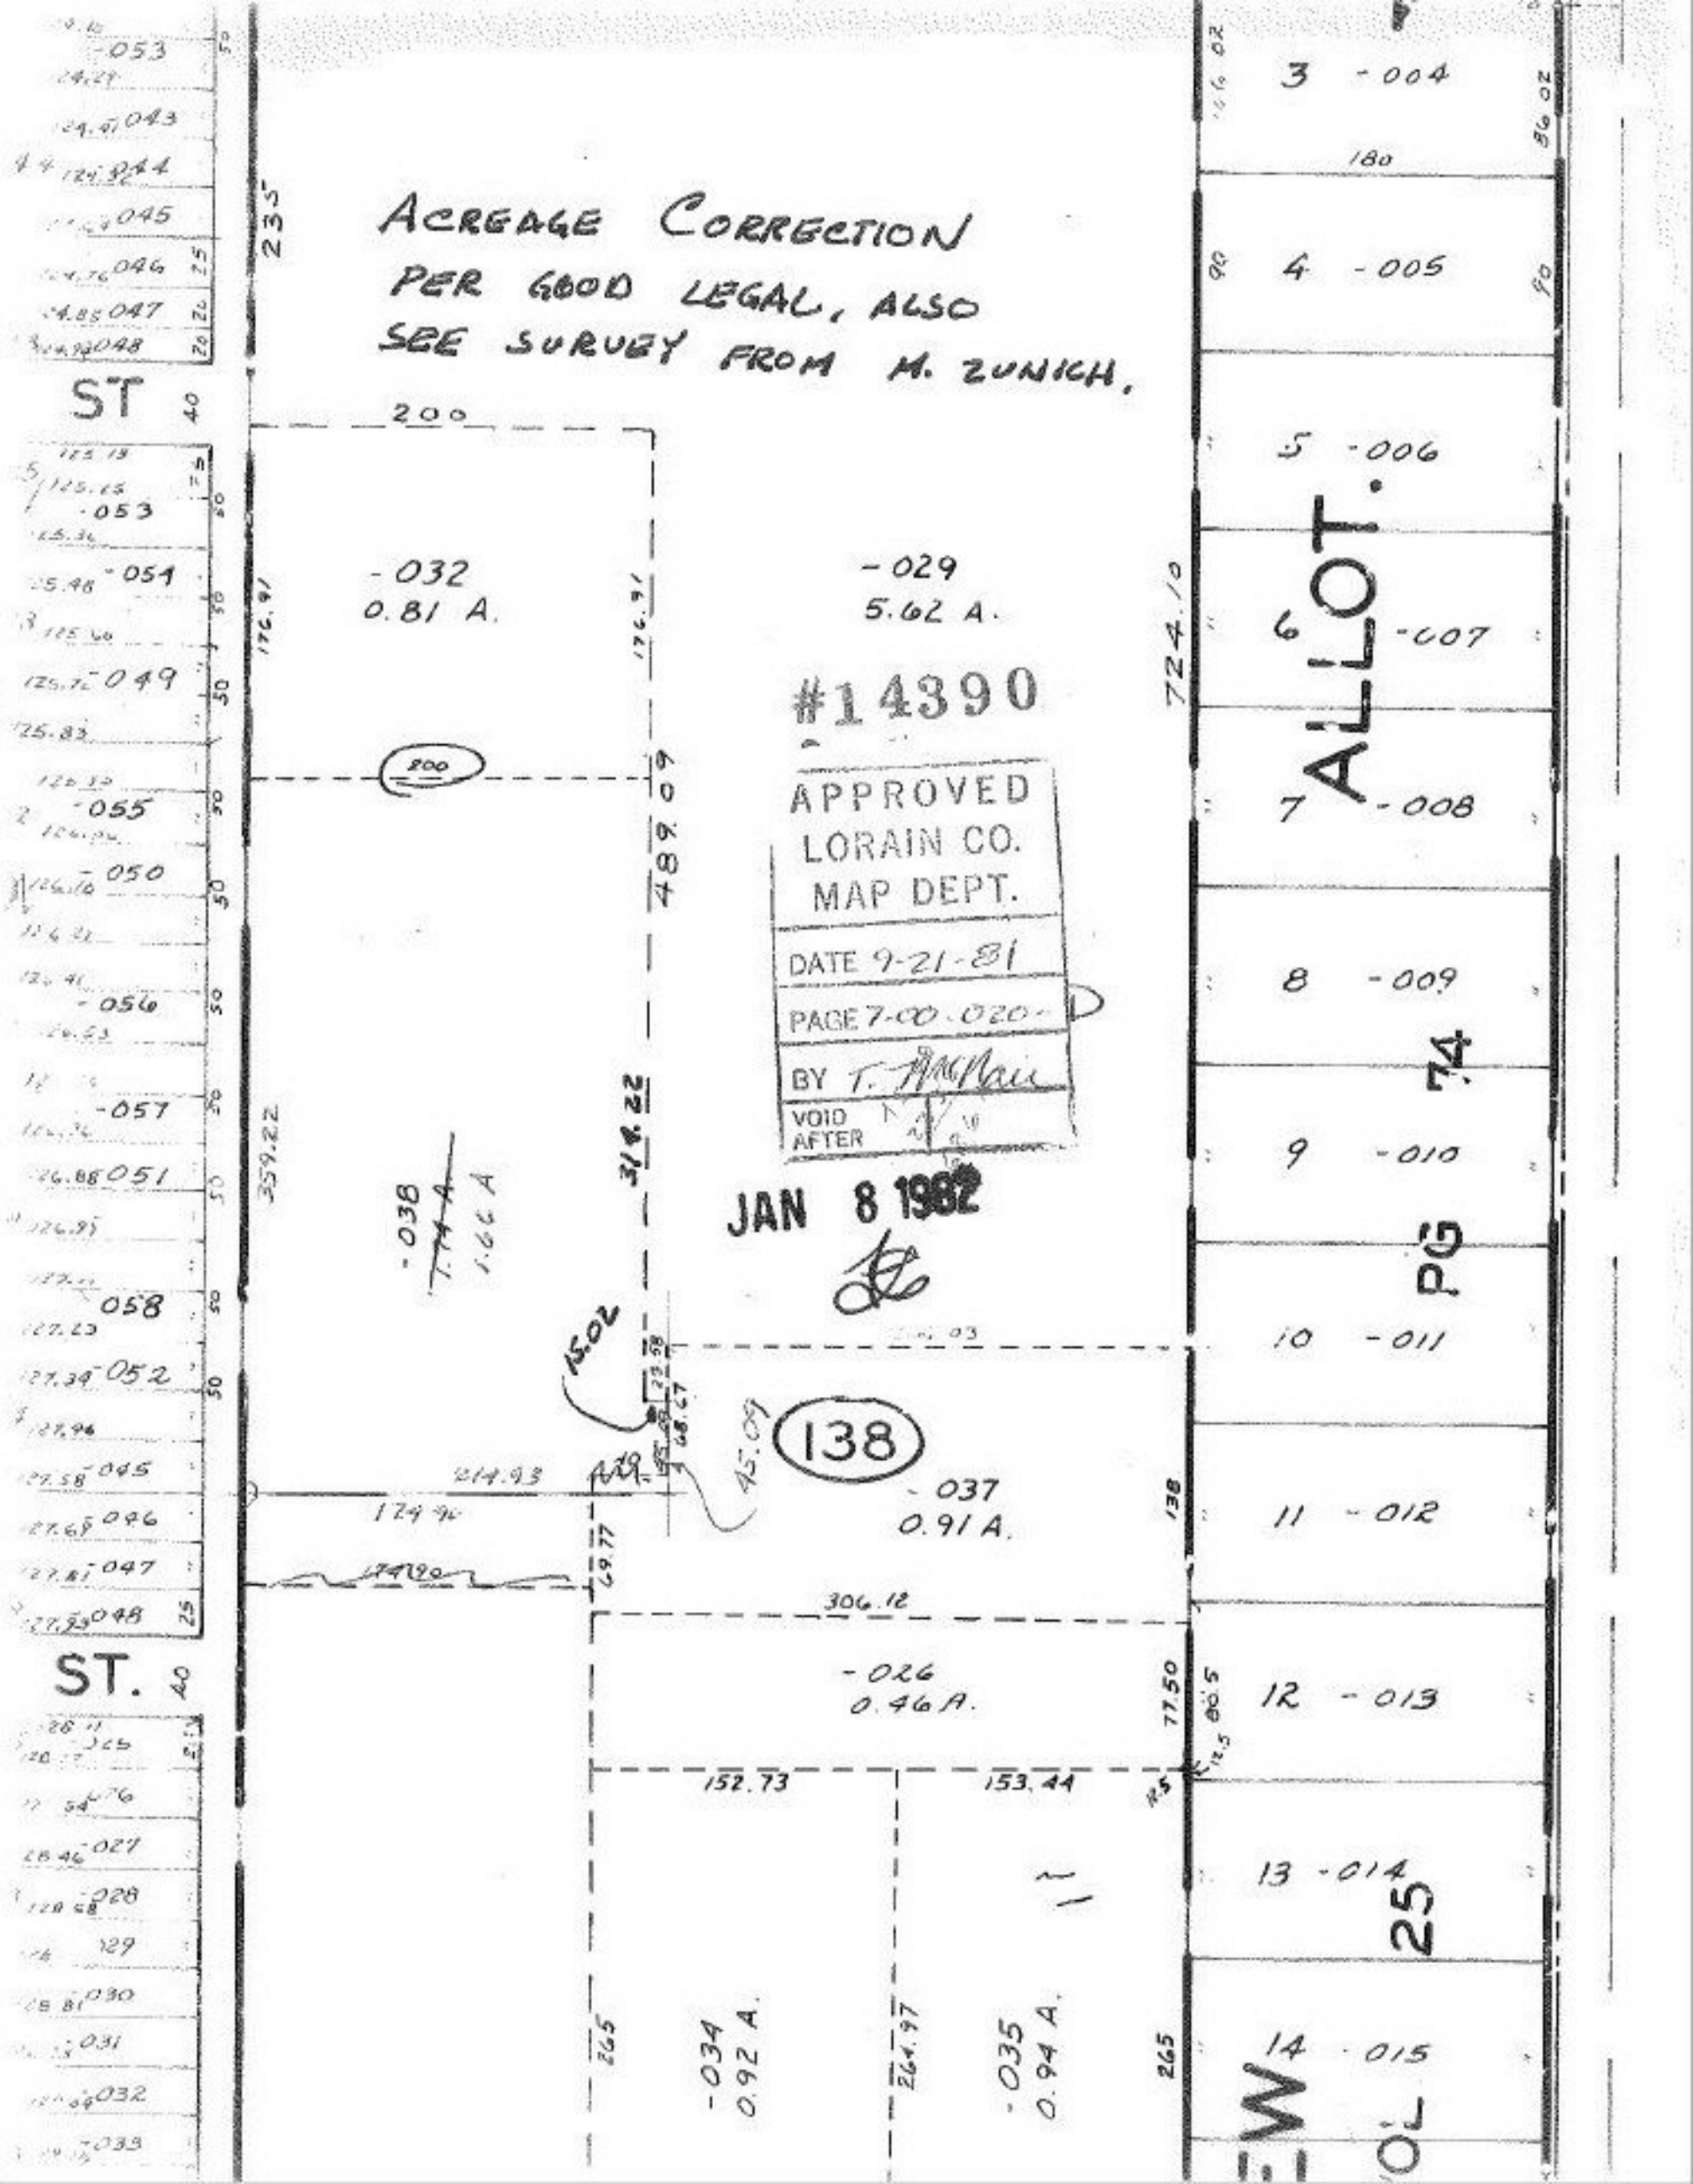
ACREAGE CORRECTION
PER GOOD LEGAL, ALSO
SEE SURVEY FROM M. ZUNICH.
#14390
APPROVED
LORAIN CO.
MAP DEPT.
DATE 9-21-81
PAGE 7-00-020-
BY
VOID
AFTER
JAN 8 1982
ST
ST.
ALLOT.
PG 74
25
-032
0.81 A.
-029
5.62 A.
-038
1.66 A
-037
0.91 A.
-026
0.46 A.
-034
0.92 A.
-035
0.94 A.
200
138
3 -004
4 -005
5 -006
6 -007
7 -008
8 -009
9 -010
10 -011
11 -012
12 -013
13 -014
14 -015
180
235
489.09
314.22
359.22
724.10
214.93
174.90
306.12
152.73
153.44
265
264.97
77.50
80.5
15.02
45.09
176.91
69.77