ACREAGE CORRECTION

SURVEYOR UNKNOWN BUT THE
LEGAL IS GOOD
CLOSES 1:333,333.

#14393

APPROVED
LORAIN CO.
MAP DEPT.
DATE 9-22-81
PAGE 4-00-014-E
BY T. McNair
VOID
AFTER
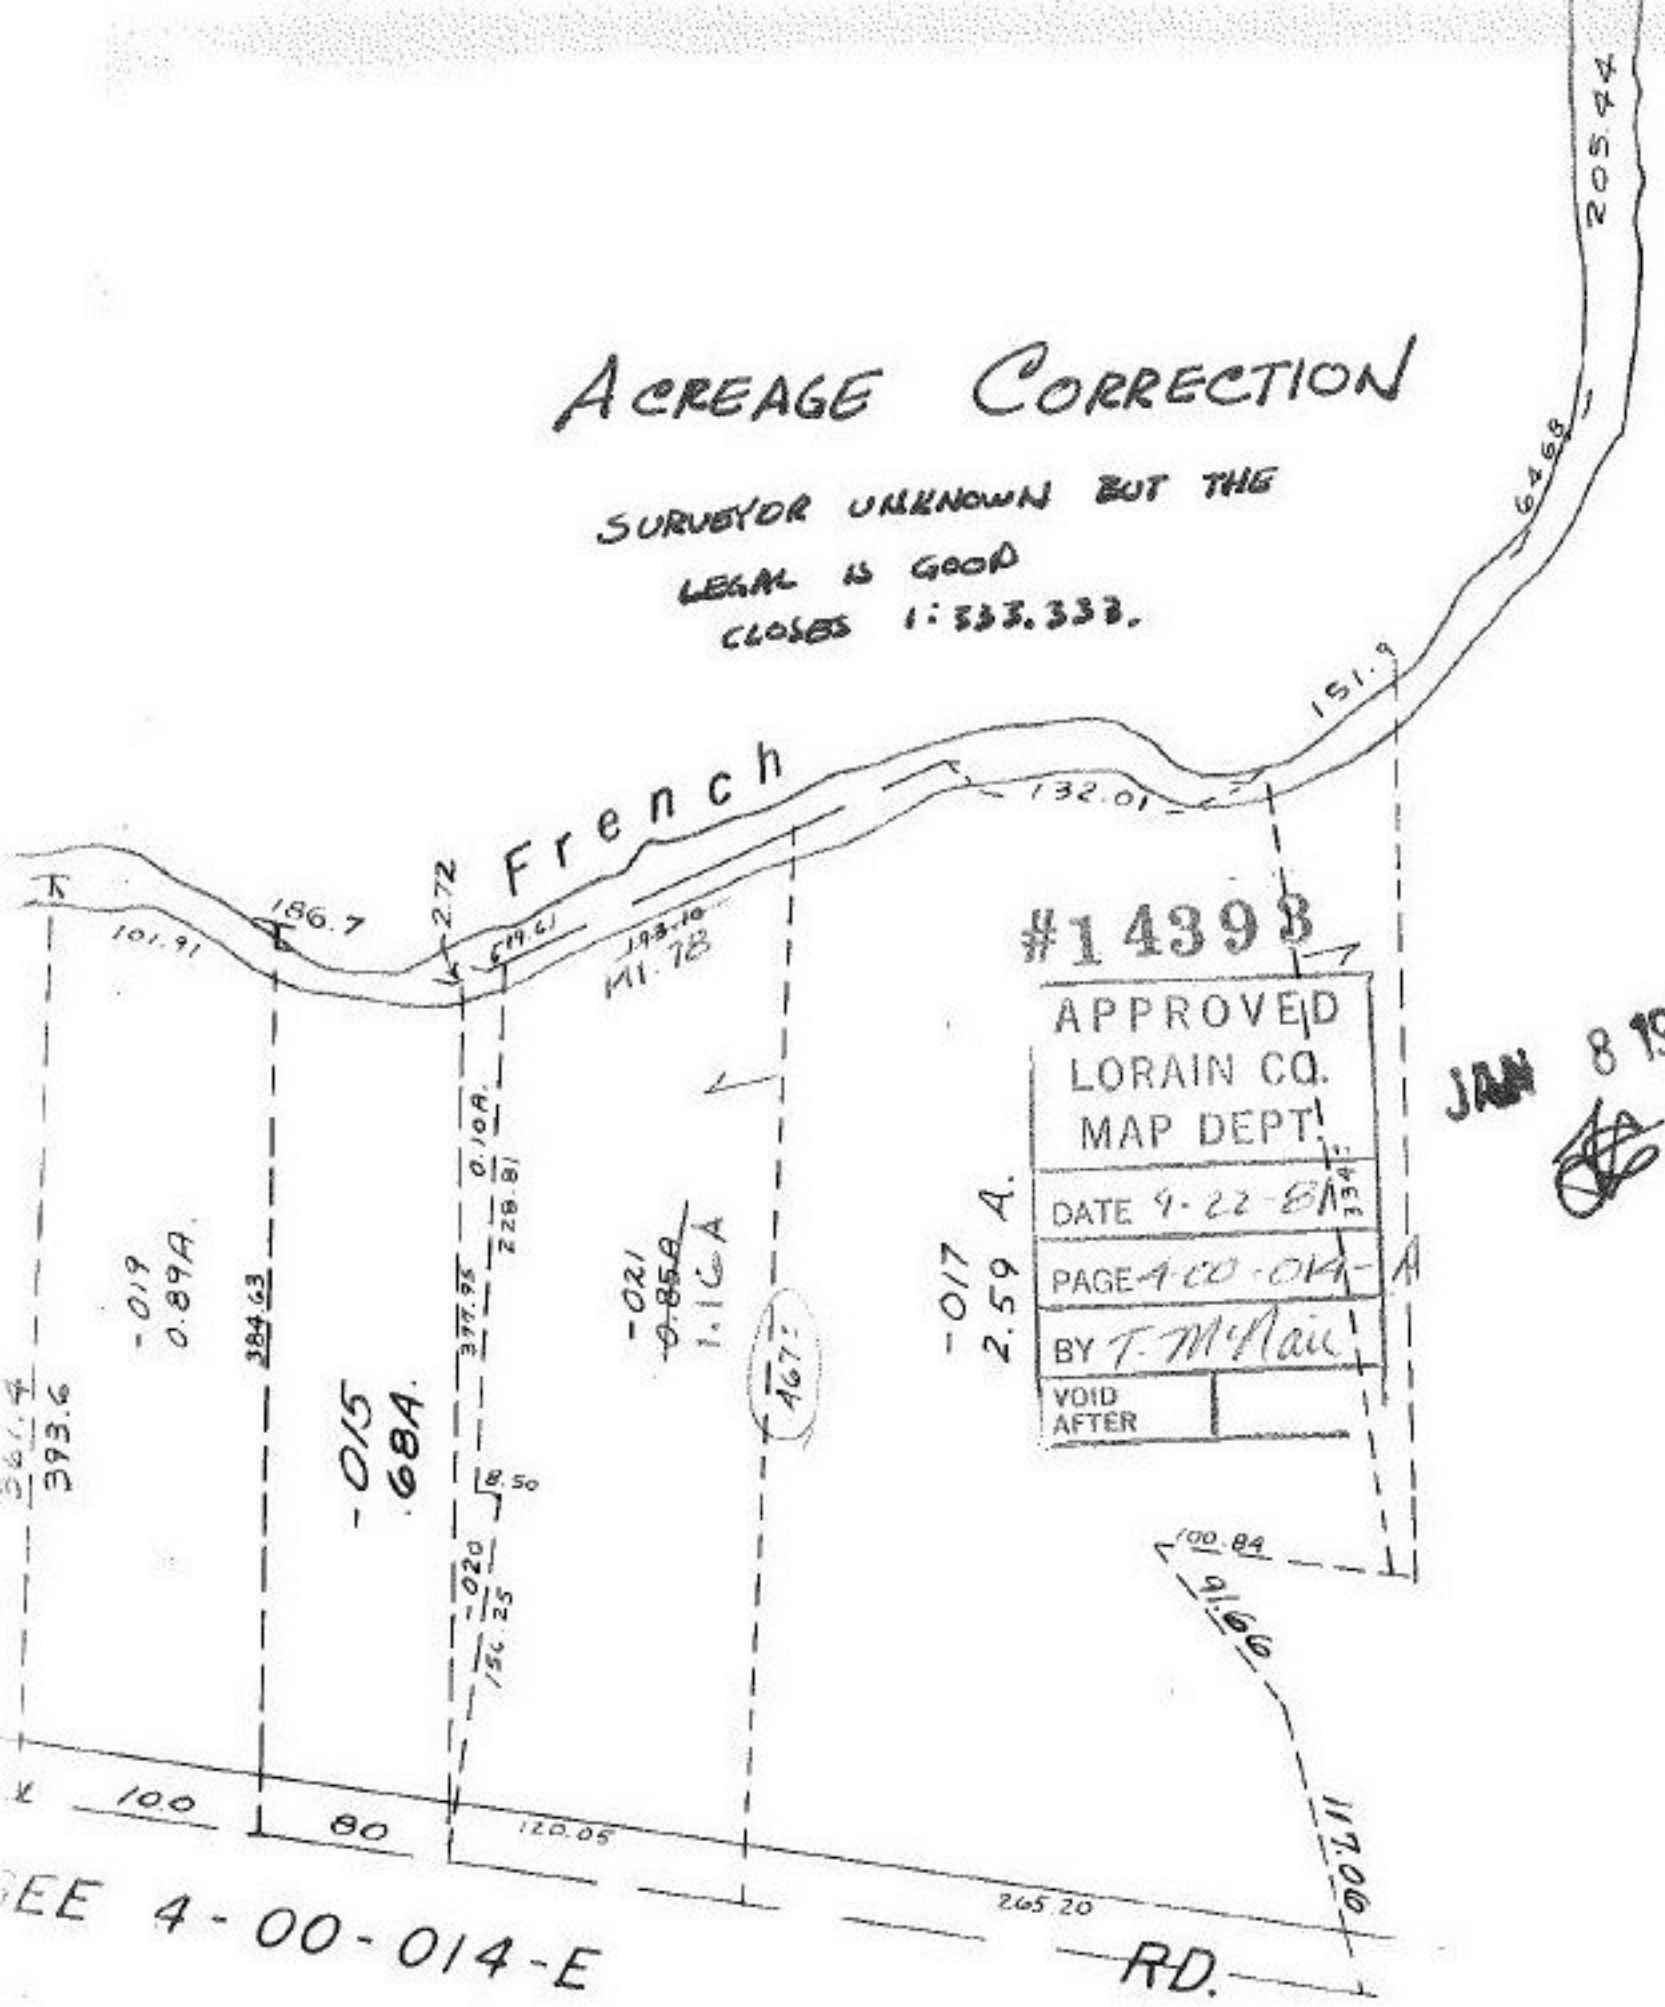
JAN 8 1982