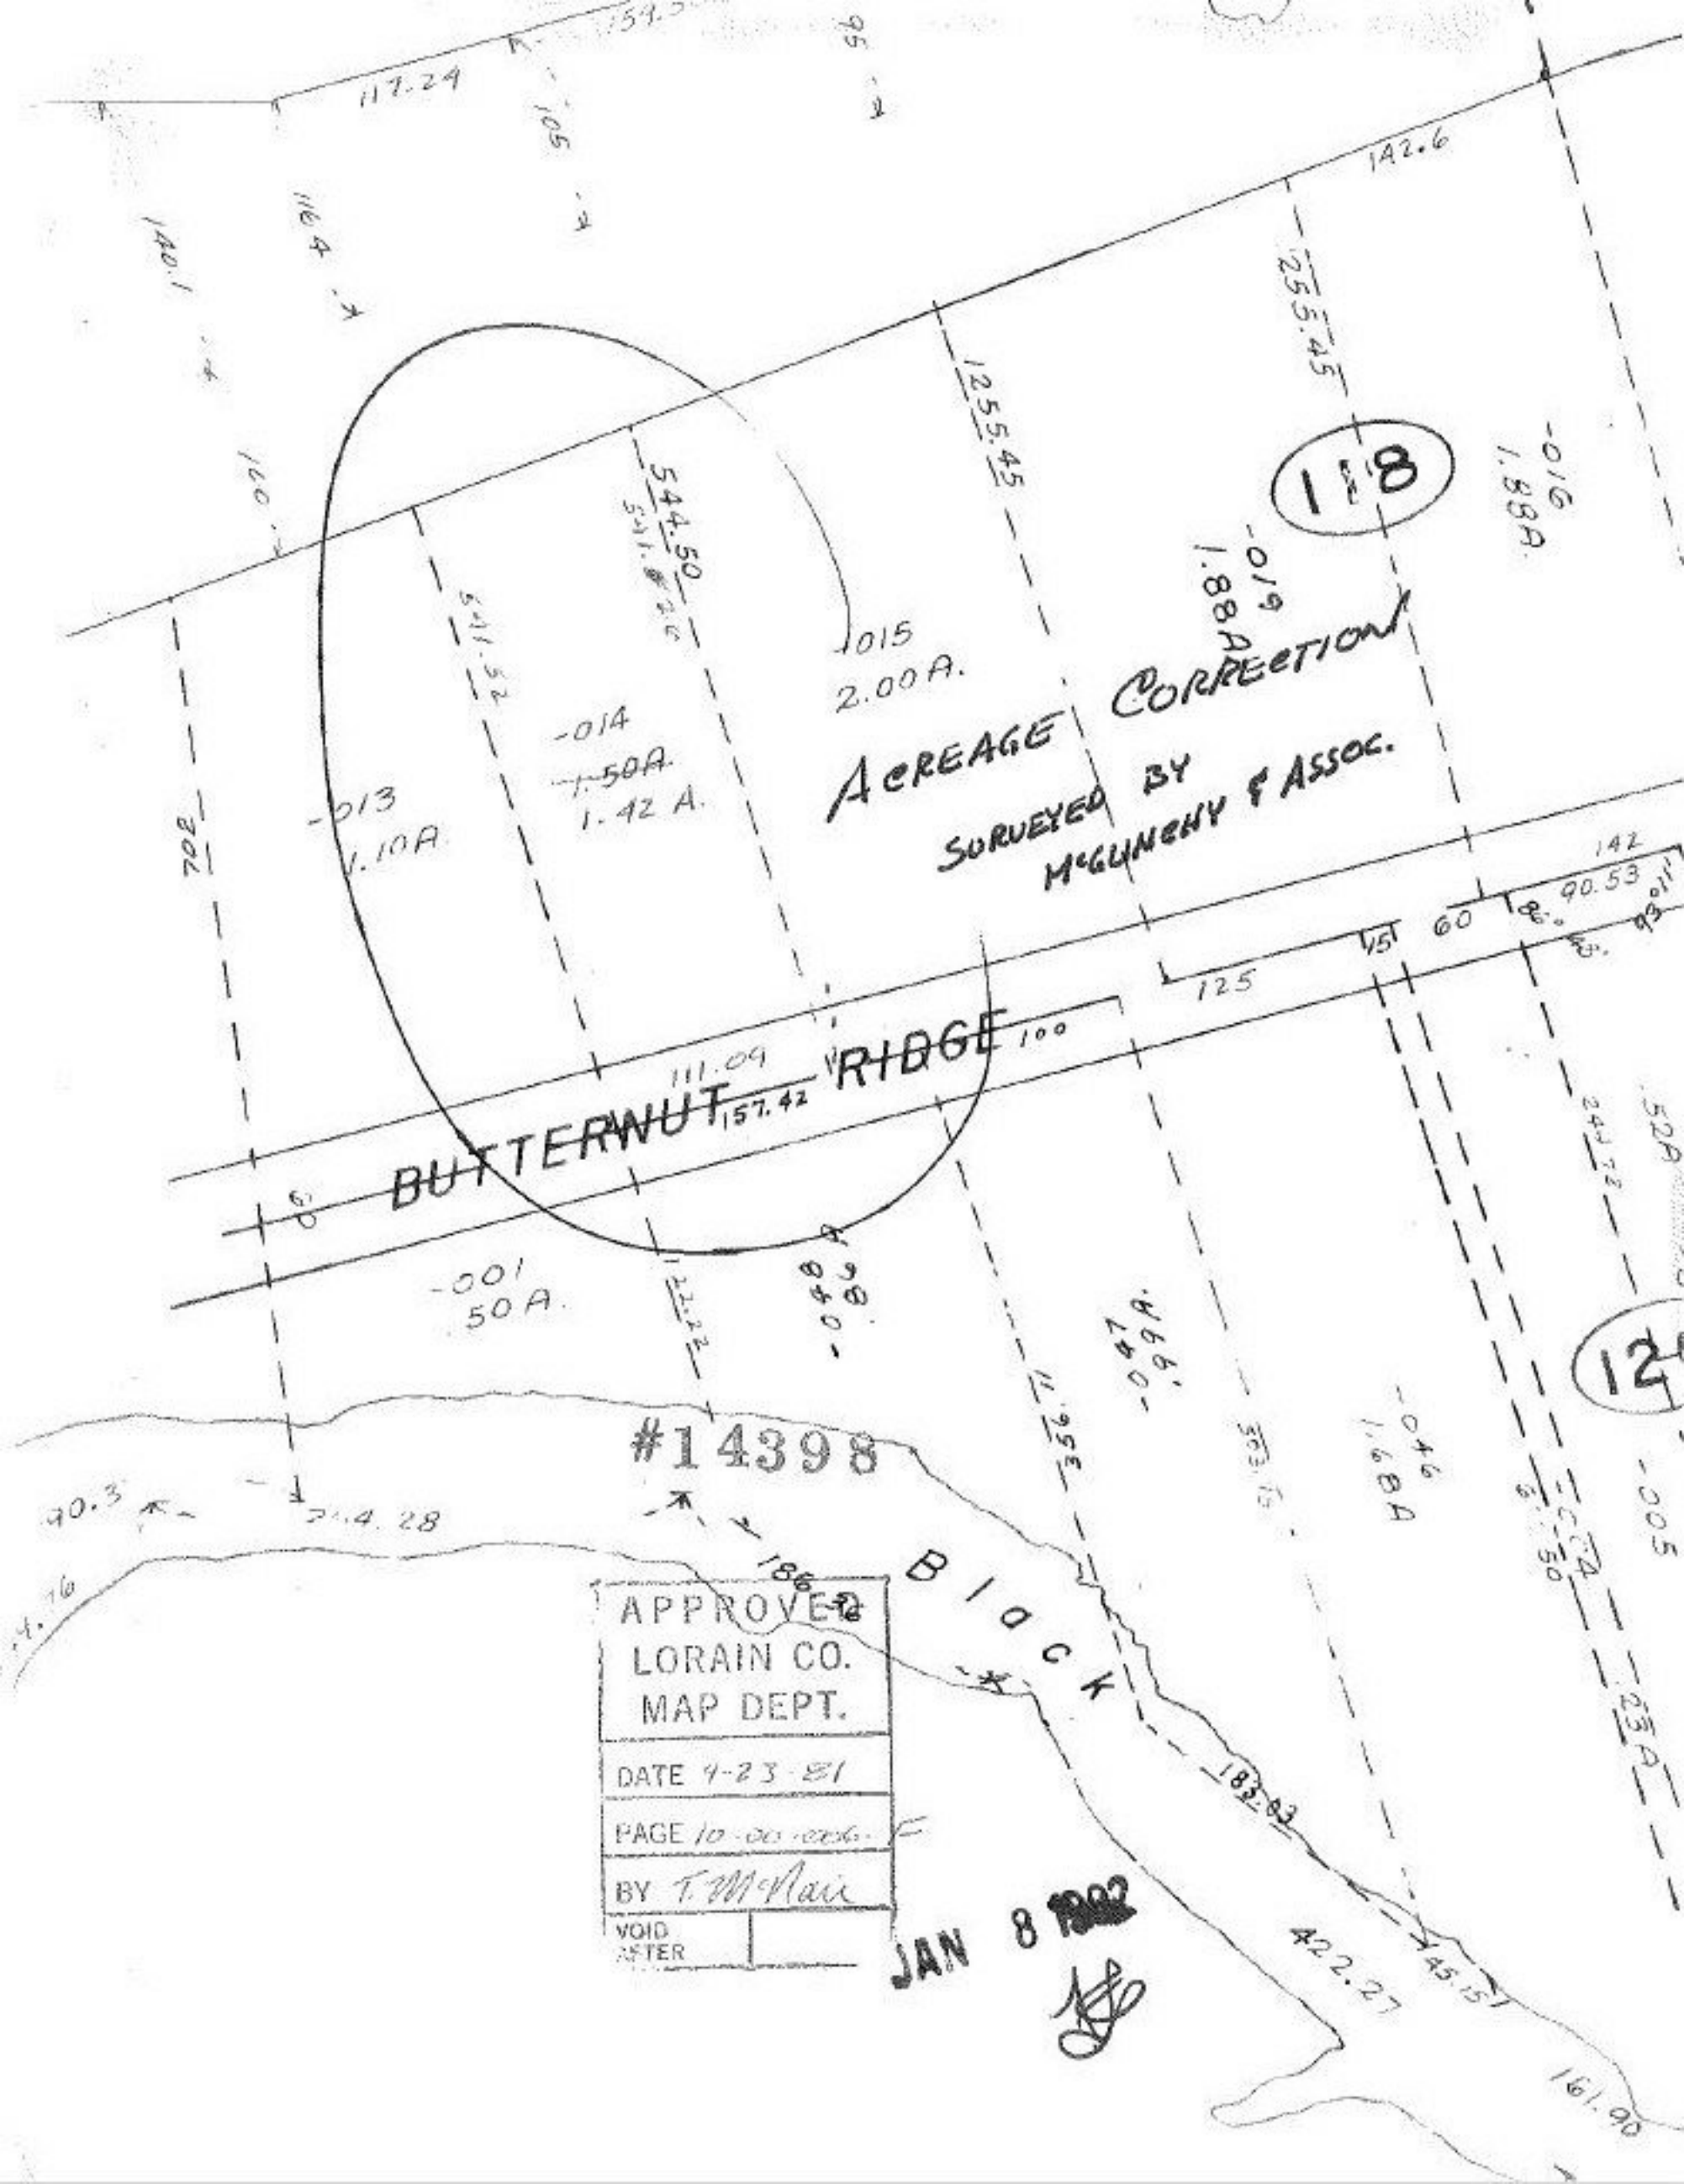

APPROVED
LORAIN CO.
MAP DEPT.
DATE 4-23-81
PAGE 10-00-006-F
BY T. McNair
VOID AFTER

JAN 8 1982