DETAIL MAP

650

#14402

APPROVED
LORAIN CO.
MAP DEPT.

DATE 9-28-81

PAGE 1-00-001-A

BY T. McNair
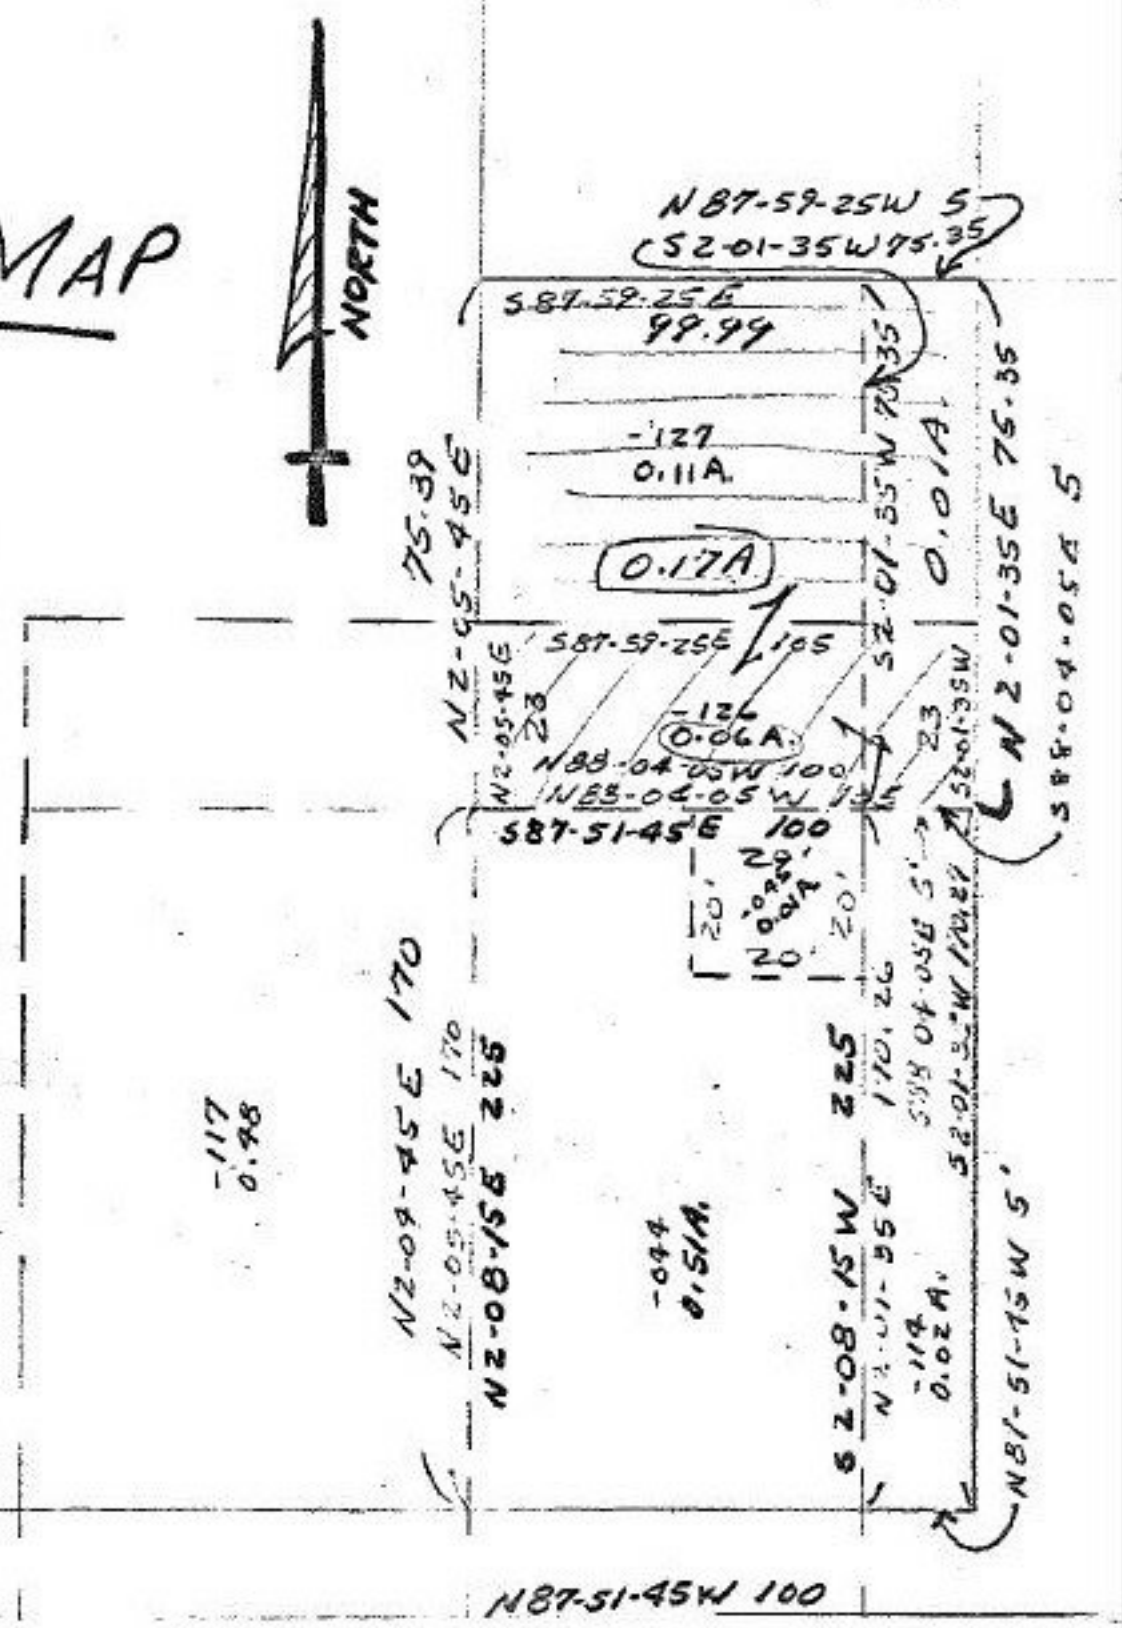
VOID AFTER