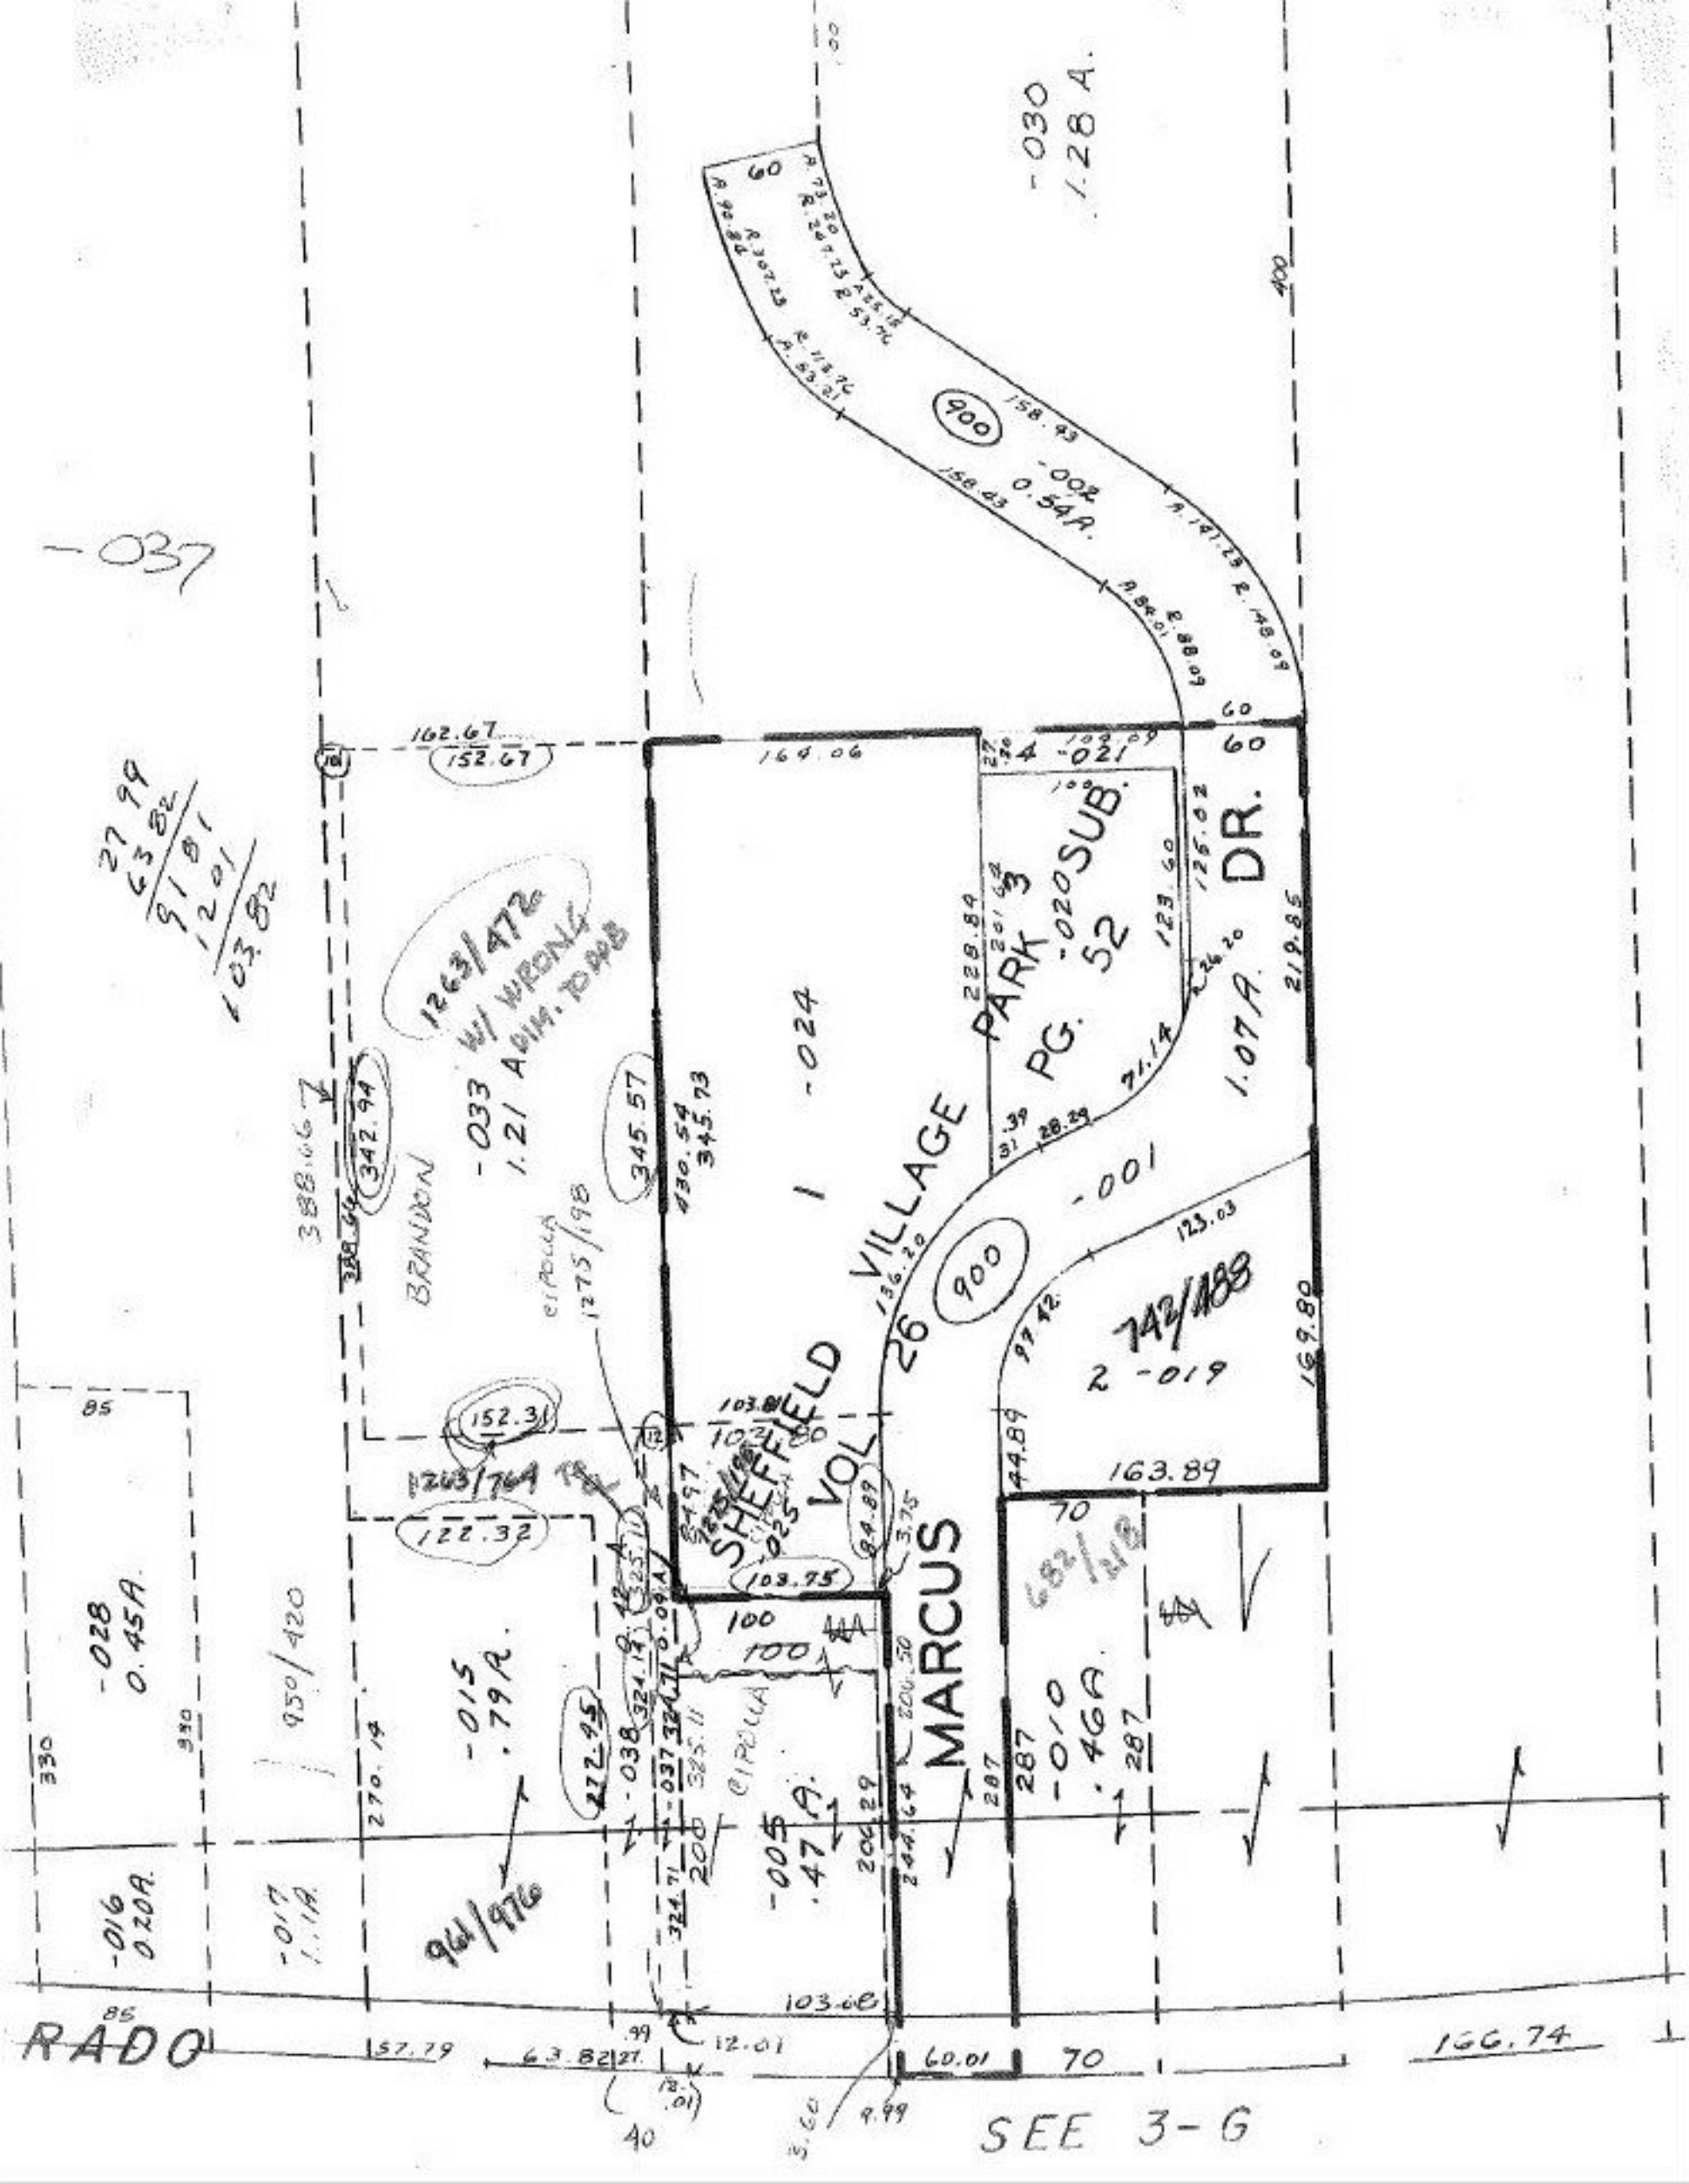

-030
1.28 A.
-037
900
-002
0.54A.
162.67
152.67
164.06
-021
PARK 3
-020 SUB.
PG. 52
DR.
1.07A.
-024
-033
1.21 A
1263/472
W/ WRONG
ADIM. TO PAB
342.94
345.57
BRANDON
CIPOLLA
1275/198
-001
900
742/488
2 -019
SHEFFIELD VILLAGE
VOL 26
MARCUS
152.31
1263/764
122.32
103.75
100
-028
0.45A.
950/420
-015
.79A.
272.95
-038
-037
CIPOLLA
-005
.47A.
-010
.46A.
682/218
-016
0.20A.
-017
1.1A.
961/976
RADO
57.79
63.82
60.01
70
166.74
SEE 3-G