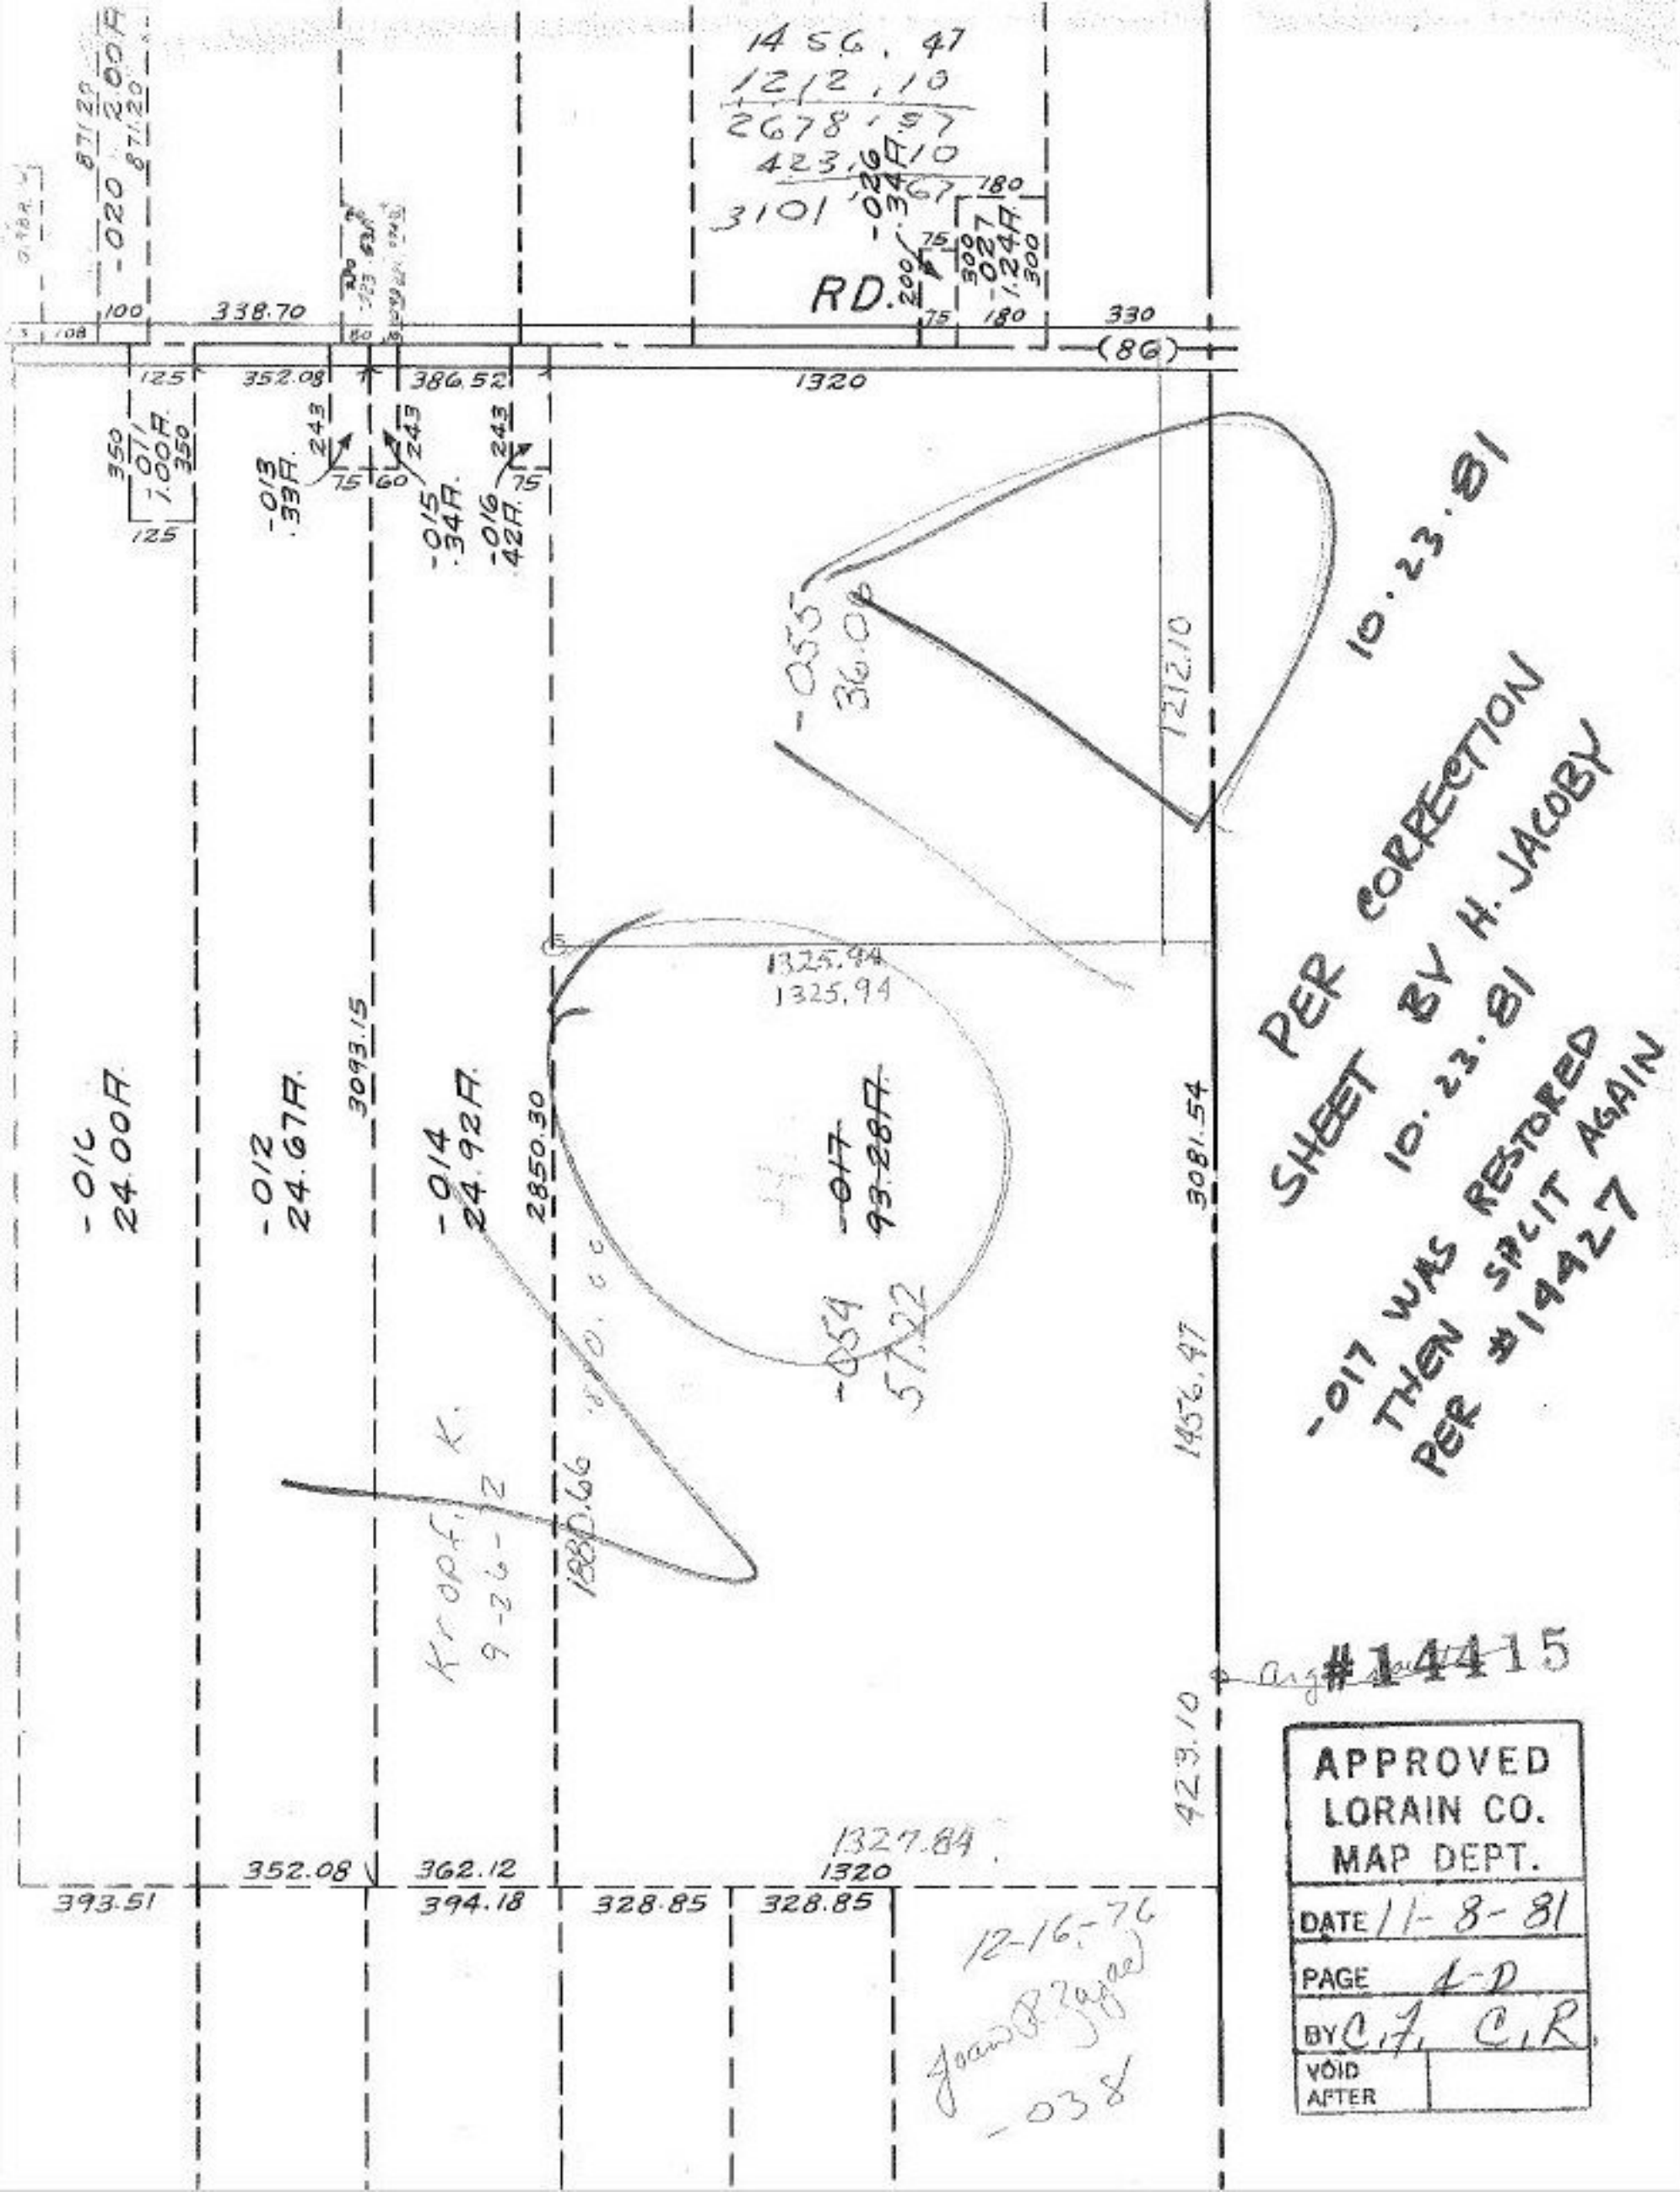
1456.47
1212.10
2678.57
423.10
3101
RD.
(86)
338.70
352.08
386.52
1320
-020 2.00A.
-013 .33A.
-015 .34A.
-016 .42A.
-055 36.00A.
1212.10
1325.94
1325.94
-010 24.00A.
-012 24.67A.
-014 24.92A.
3093.15
2850.30
-017 93.28A.
-054 57.22
3081.54
1456.47
423.10
1327.84
1320
352.08
362.12
393.51
394.18
328.85
328.85
10.23.81
PER CORRECTION SHEET BY H. JACOBY 10.23.81
-017 WAS RESTORED THEN SPLIT AGAIN PER #14427
Kropf, K. 9-26-72
12-16-76
-038
#14415
APPROVED
LORAIN CO.
MAP DEPT.
DATE 11-8-81
PAGE 1-D
BY C.F. C.R.
VOID AFTER