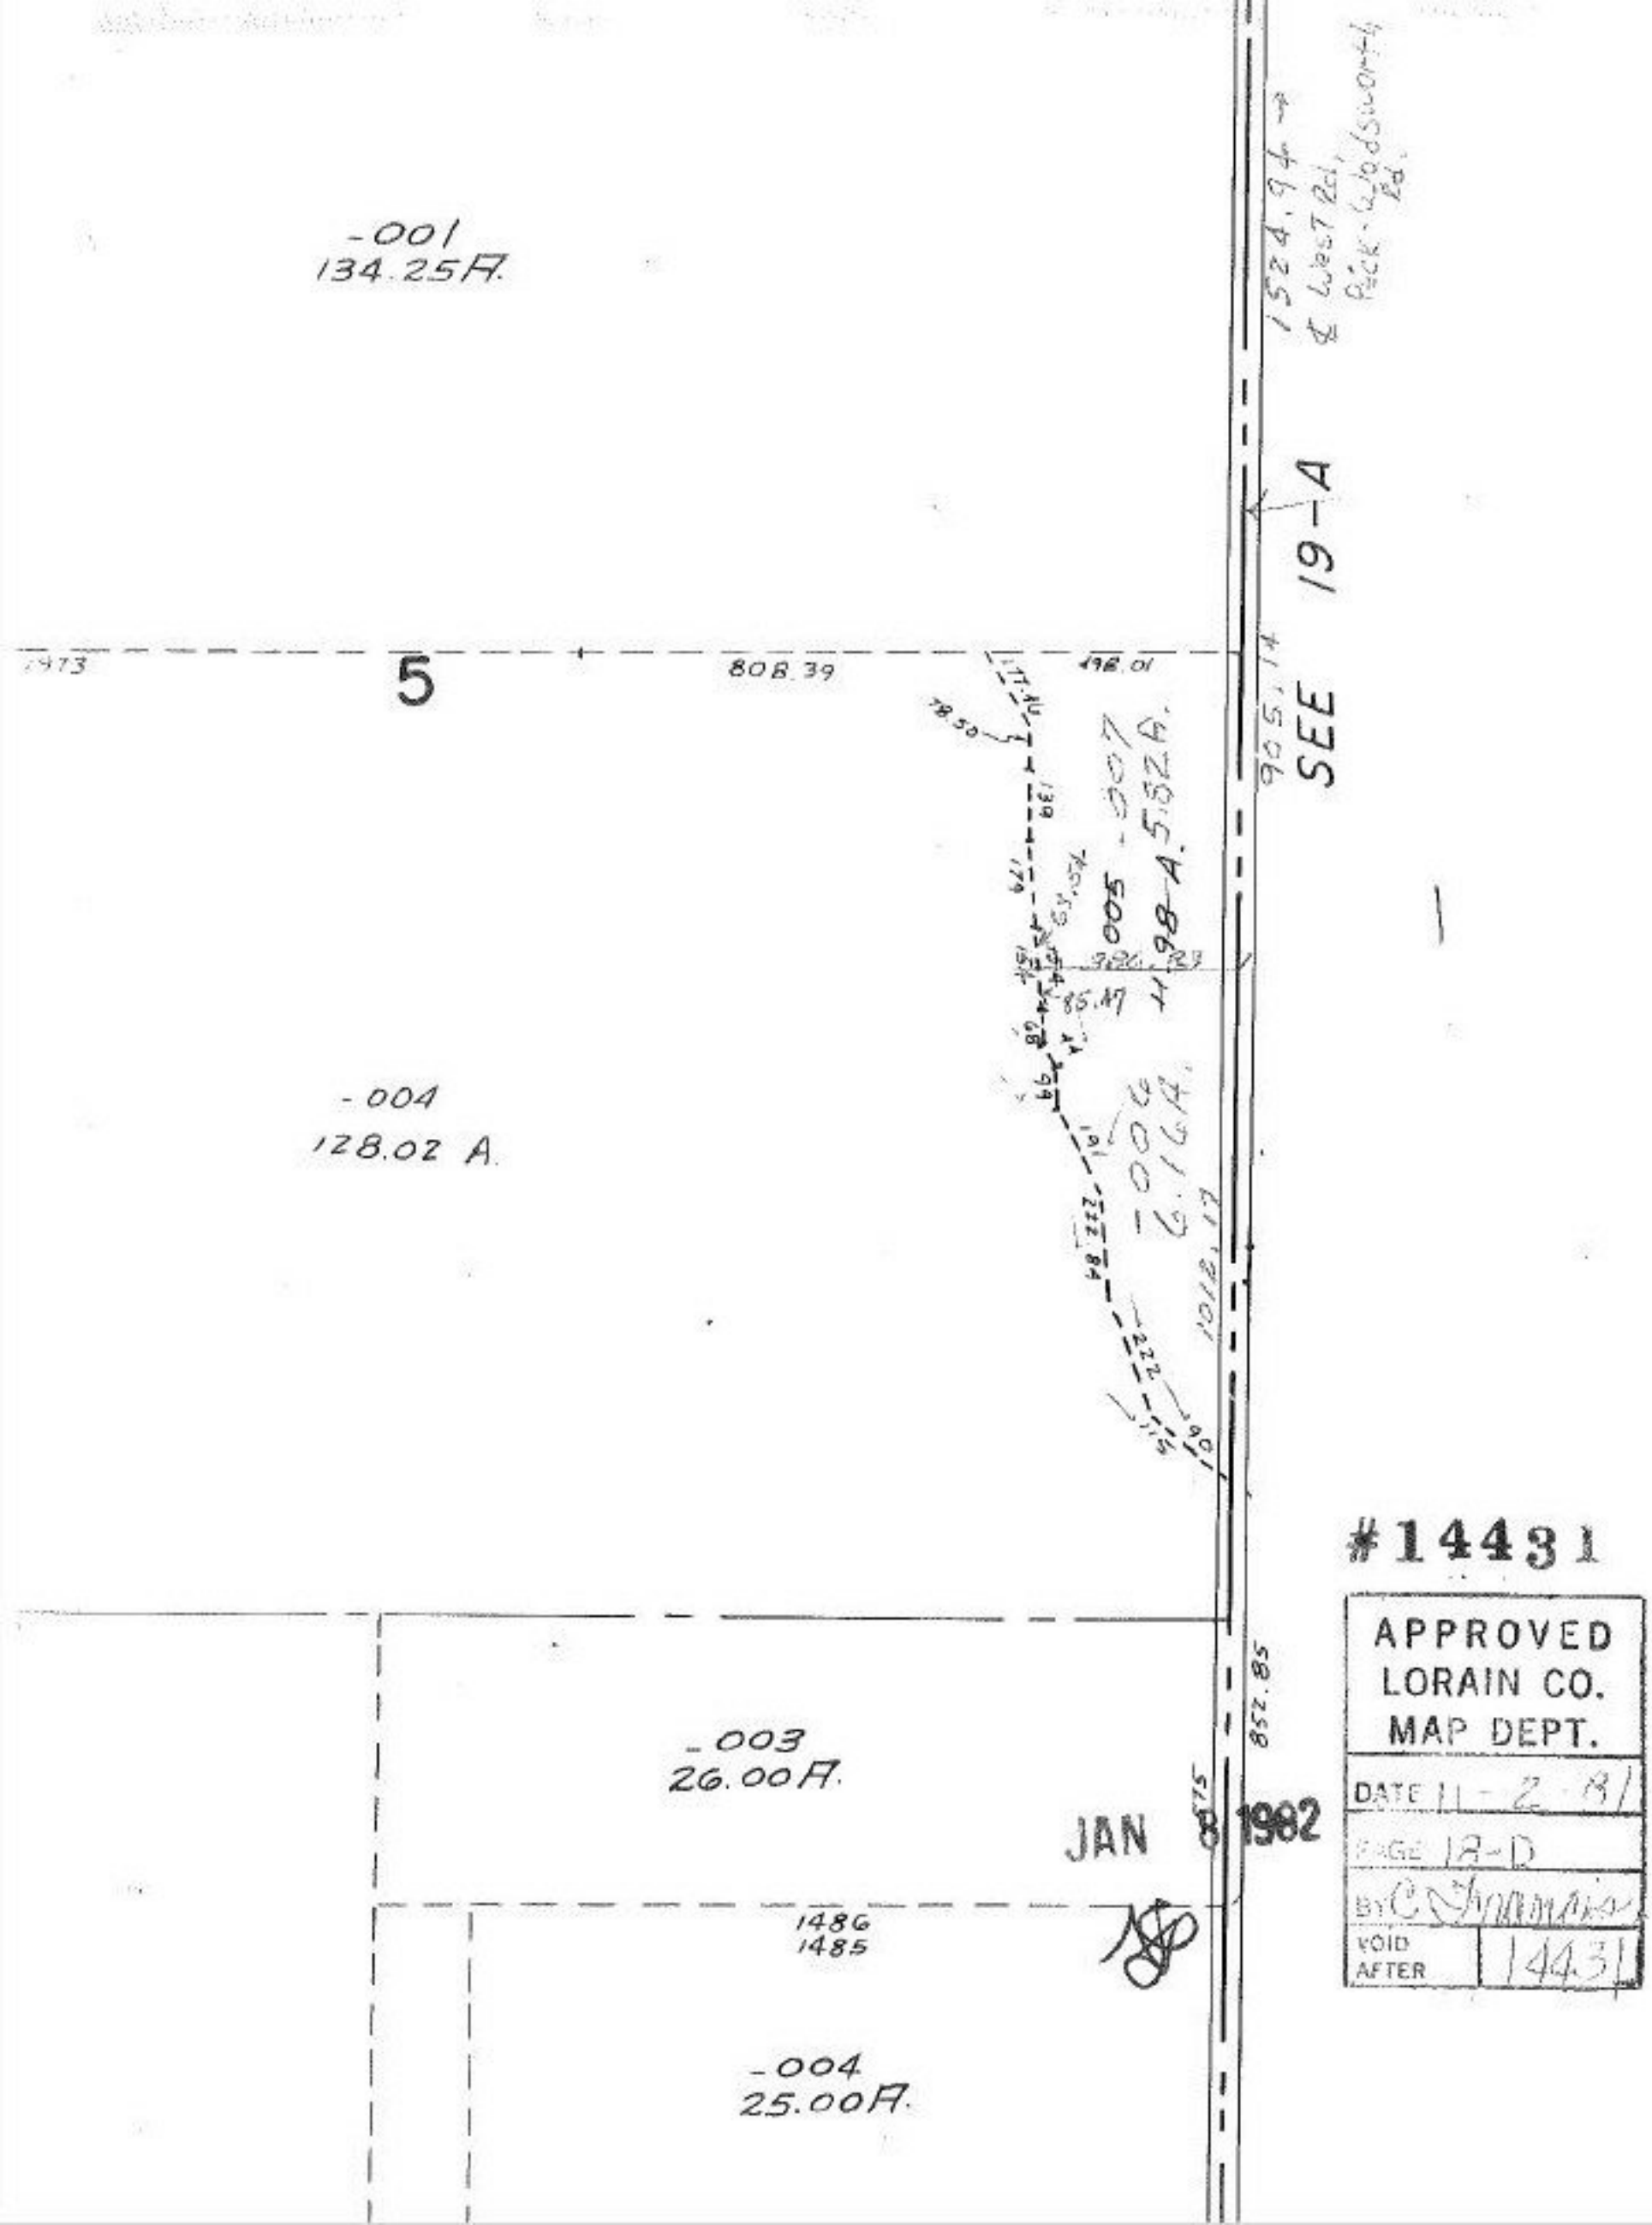

#14431

APPROVED
LORAIN CO.
MAP DEPT.

DATE	11-2-81
PAGE	18-D
BY	C. Francis
VOID AFTER	14431