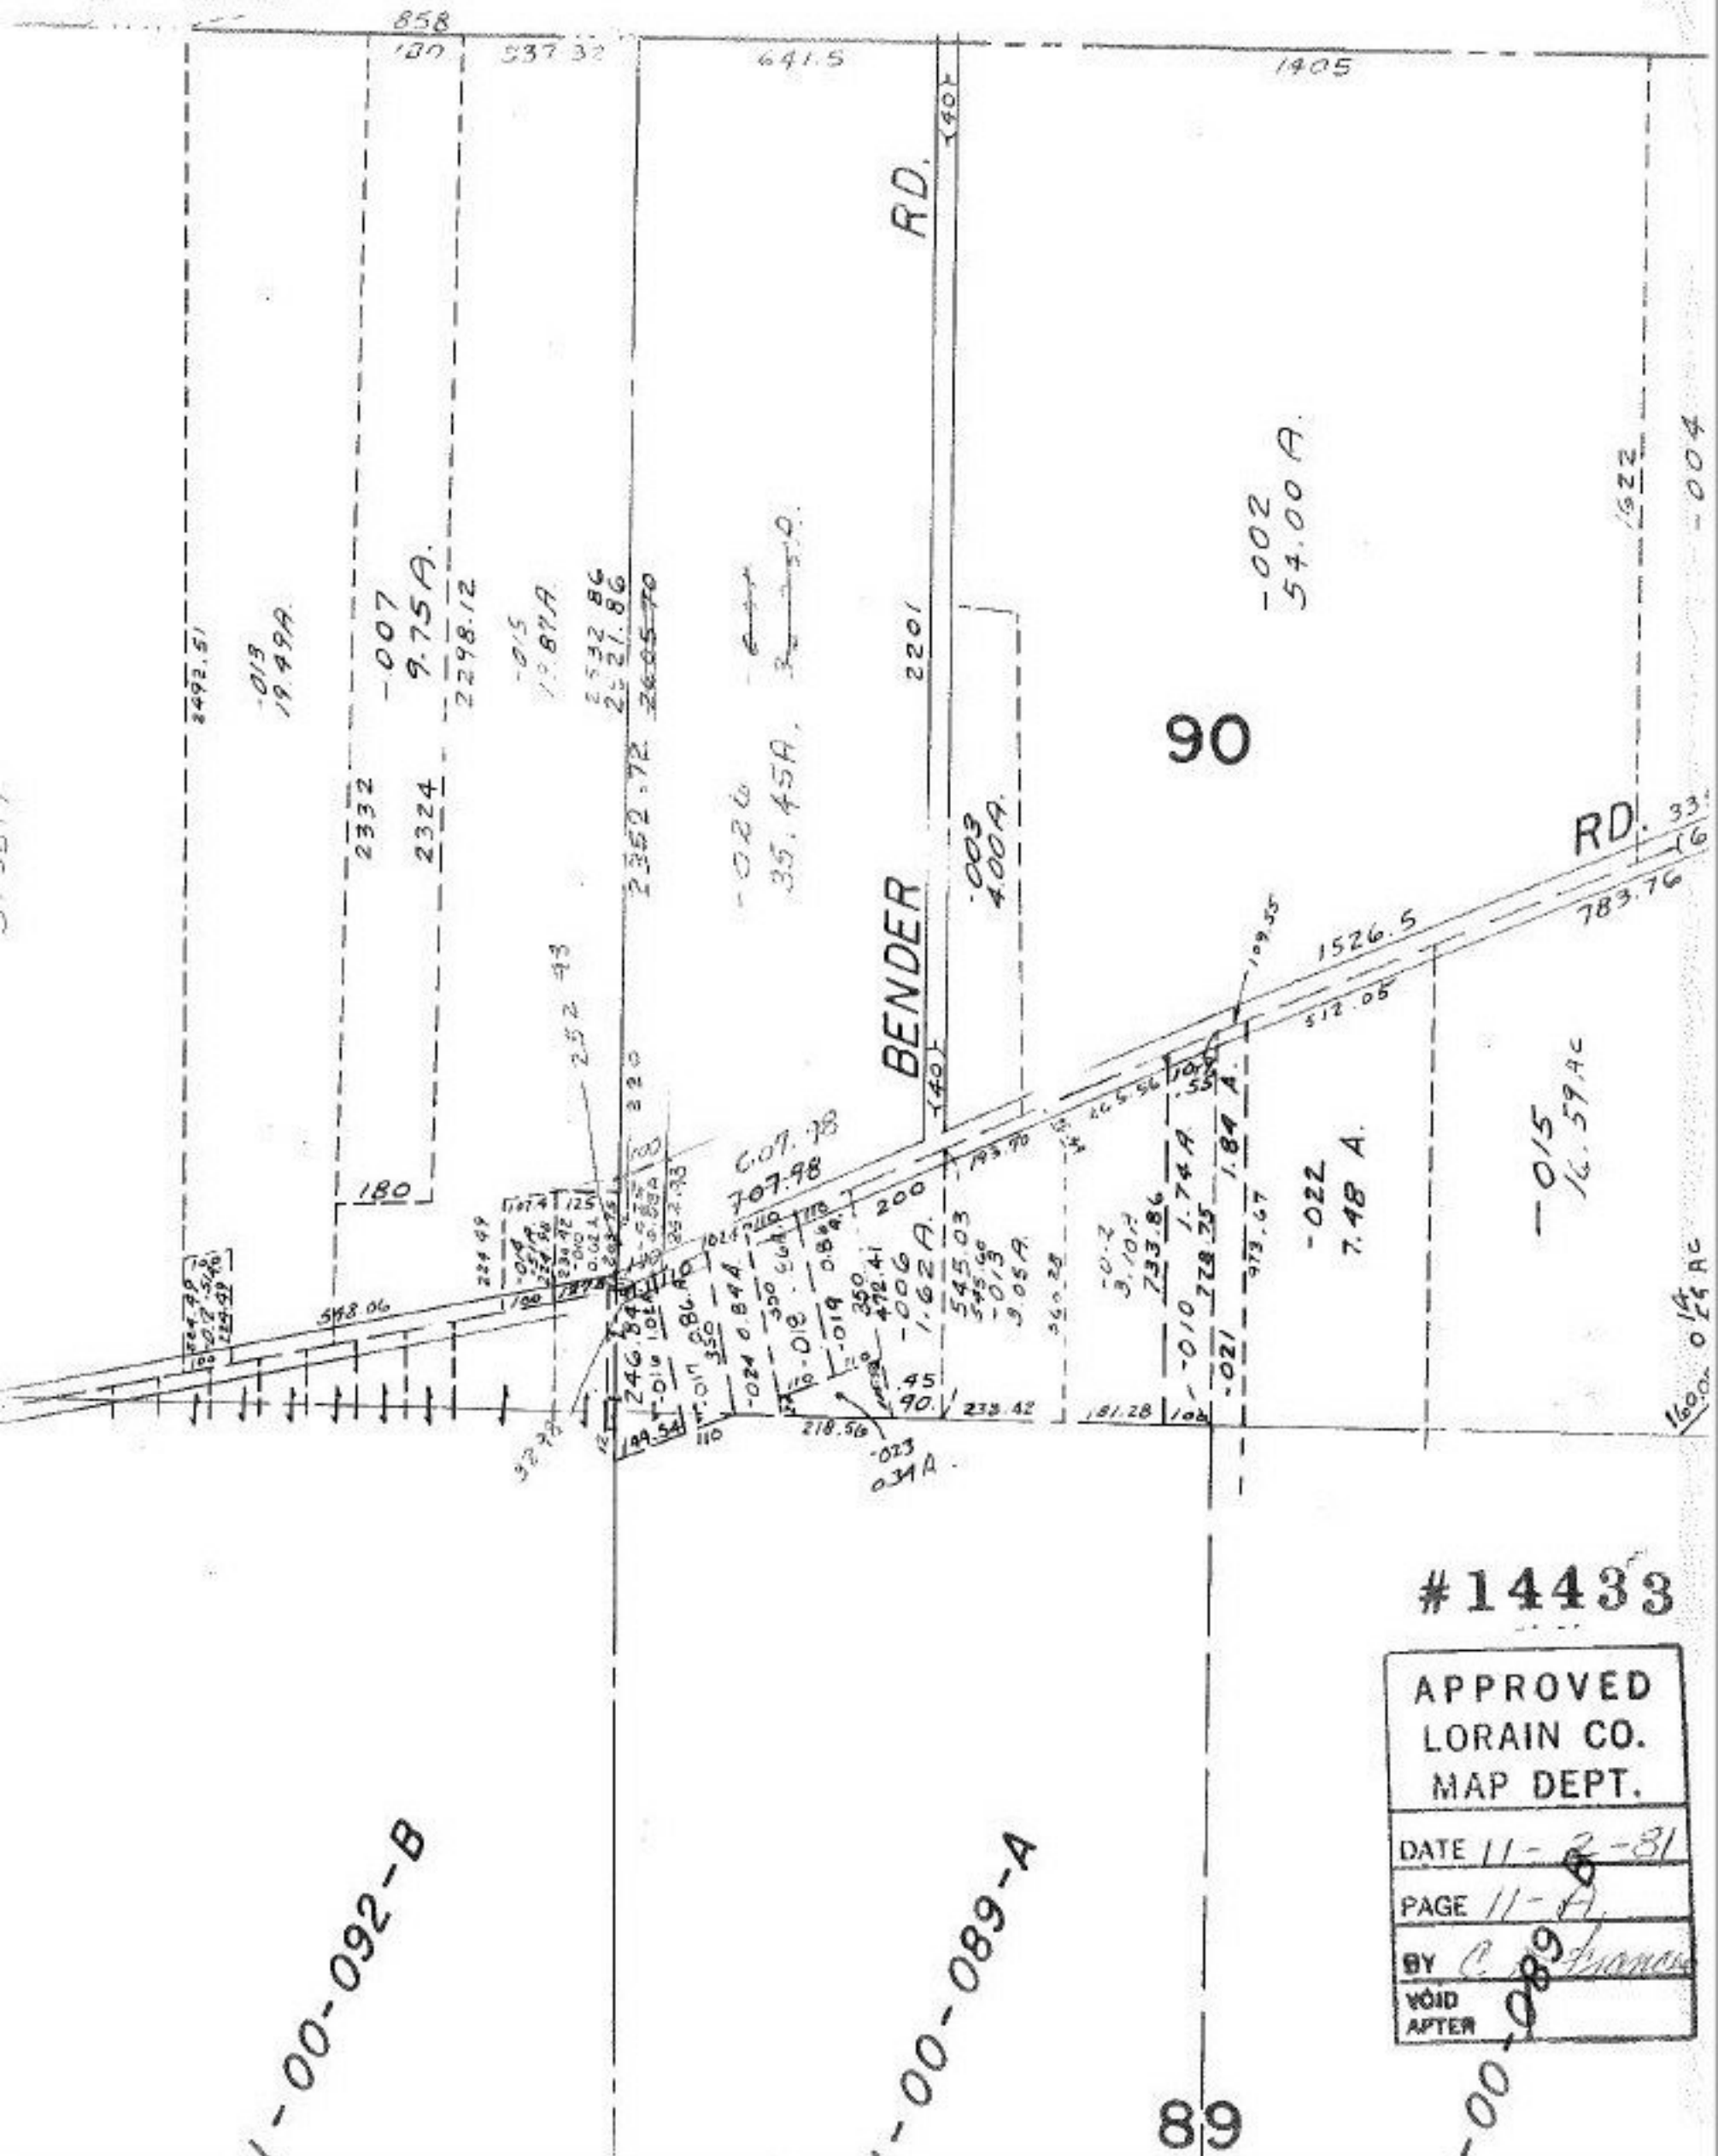


#14433

APPROVED
LORAIN CO.
MAP DEPT.

DATE 11-2-81

PAGE 11-A

BY C. Thomas

VOID
AFTER