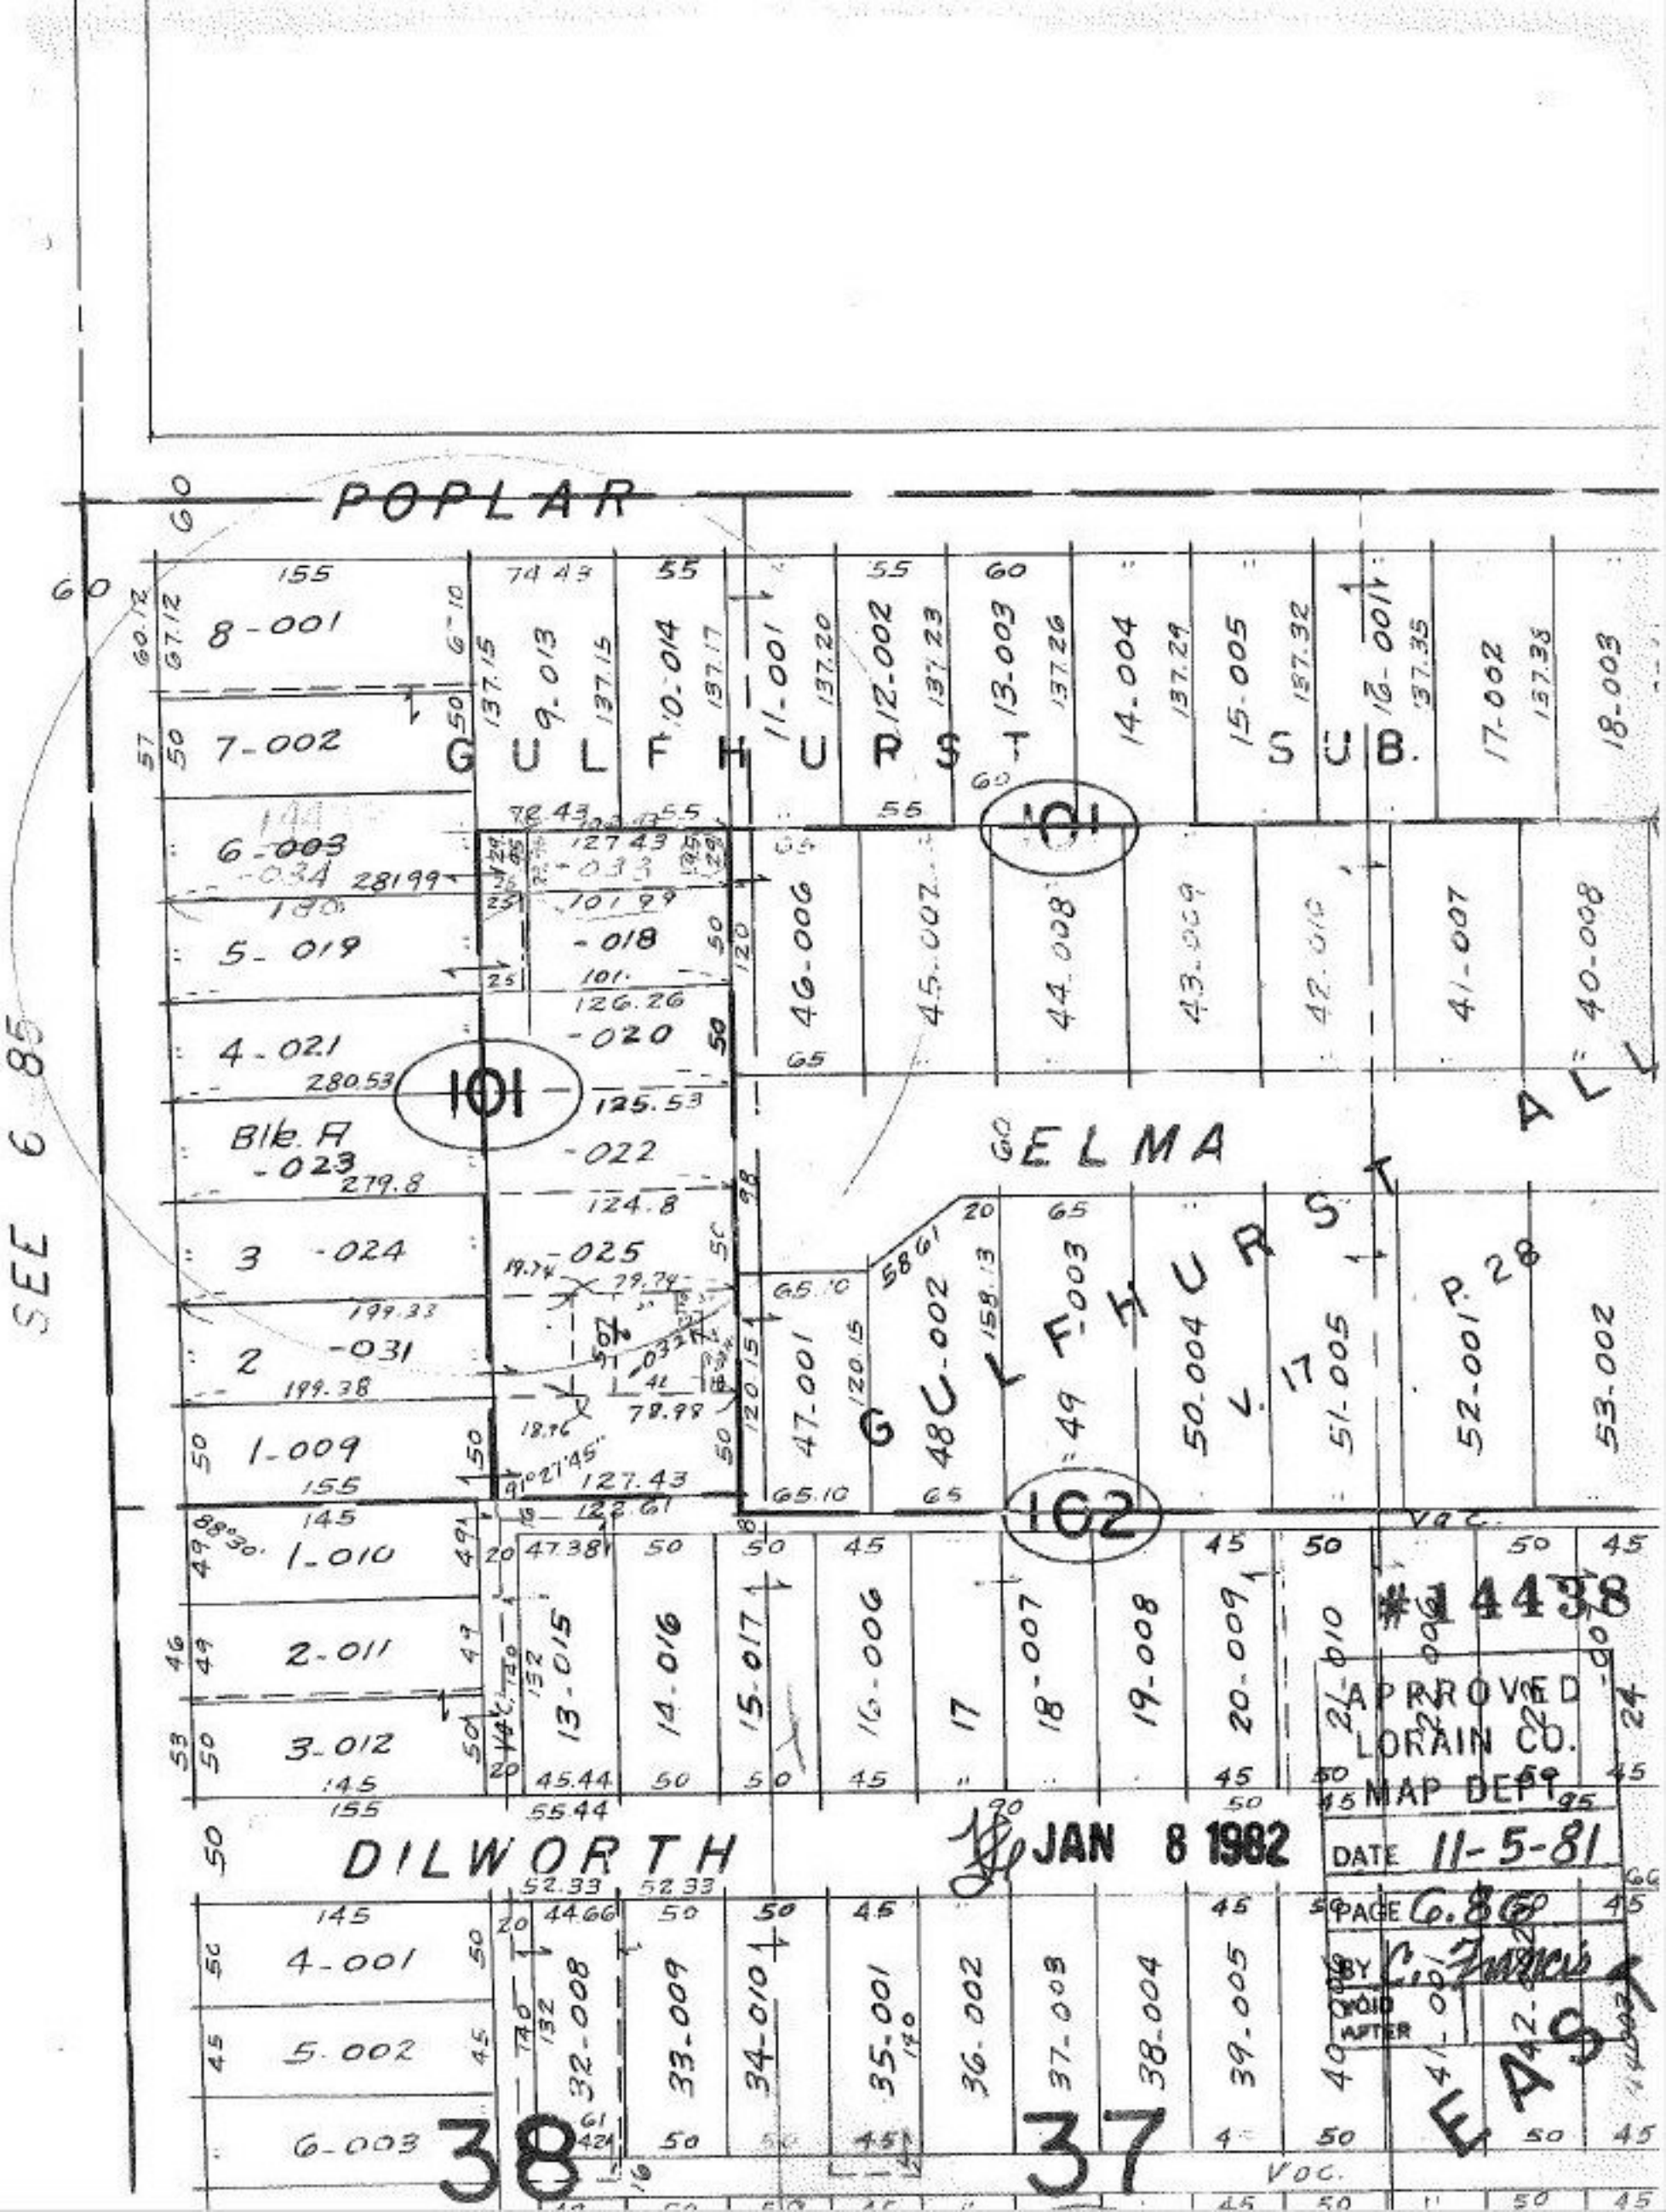
POPLAR
GULFHURST SUB.
ELMA
GULFHURST ALL
DILWORTH
EAST
SEE 6 85
101
102
38
37
#14438
APPROVED
LORAIN CO.
MAP DEPT.
JAN 8 1982
DATE 11-5-81
PAGE 6.86
BY C. Francis
VOID AFTER