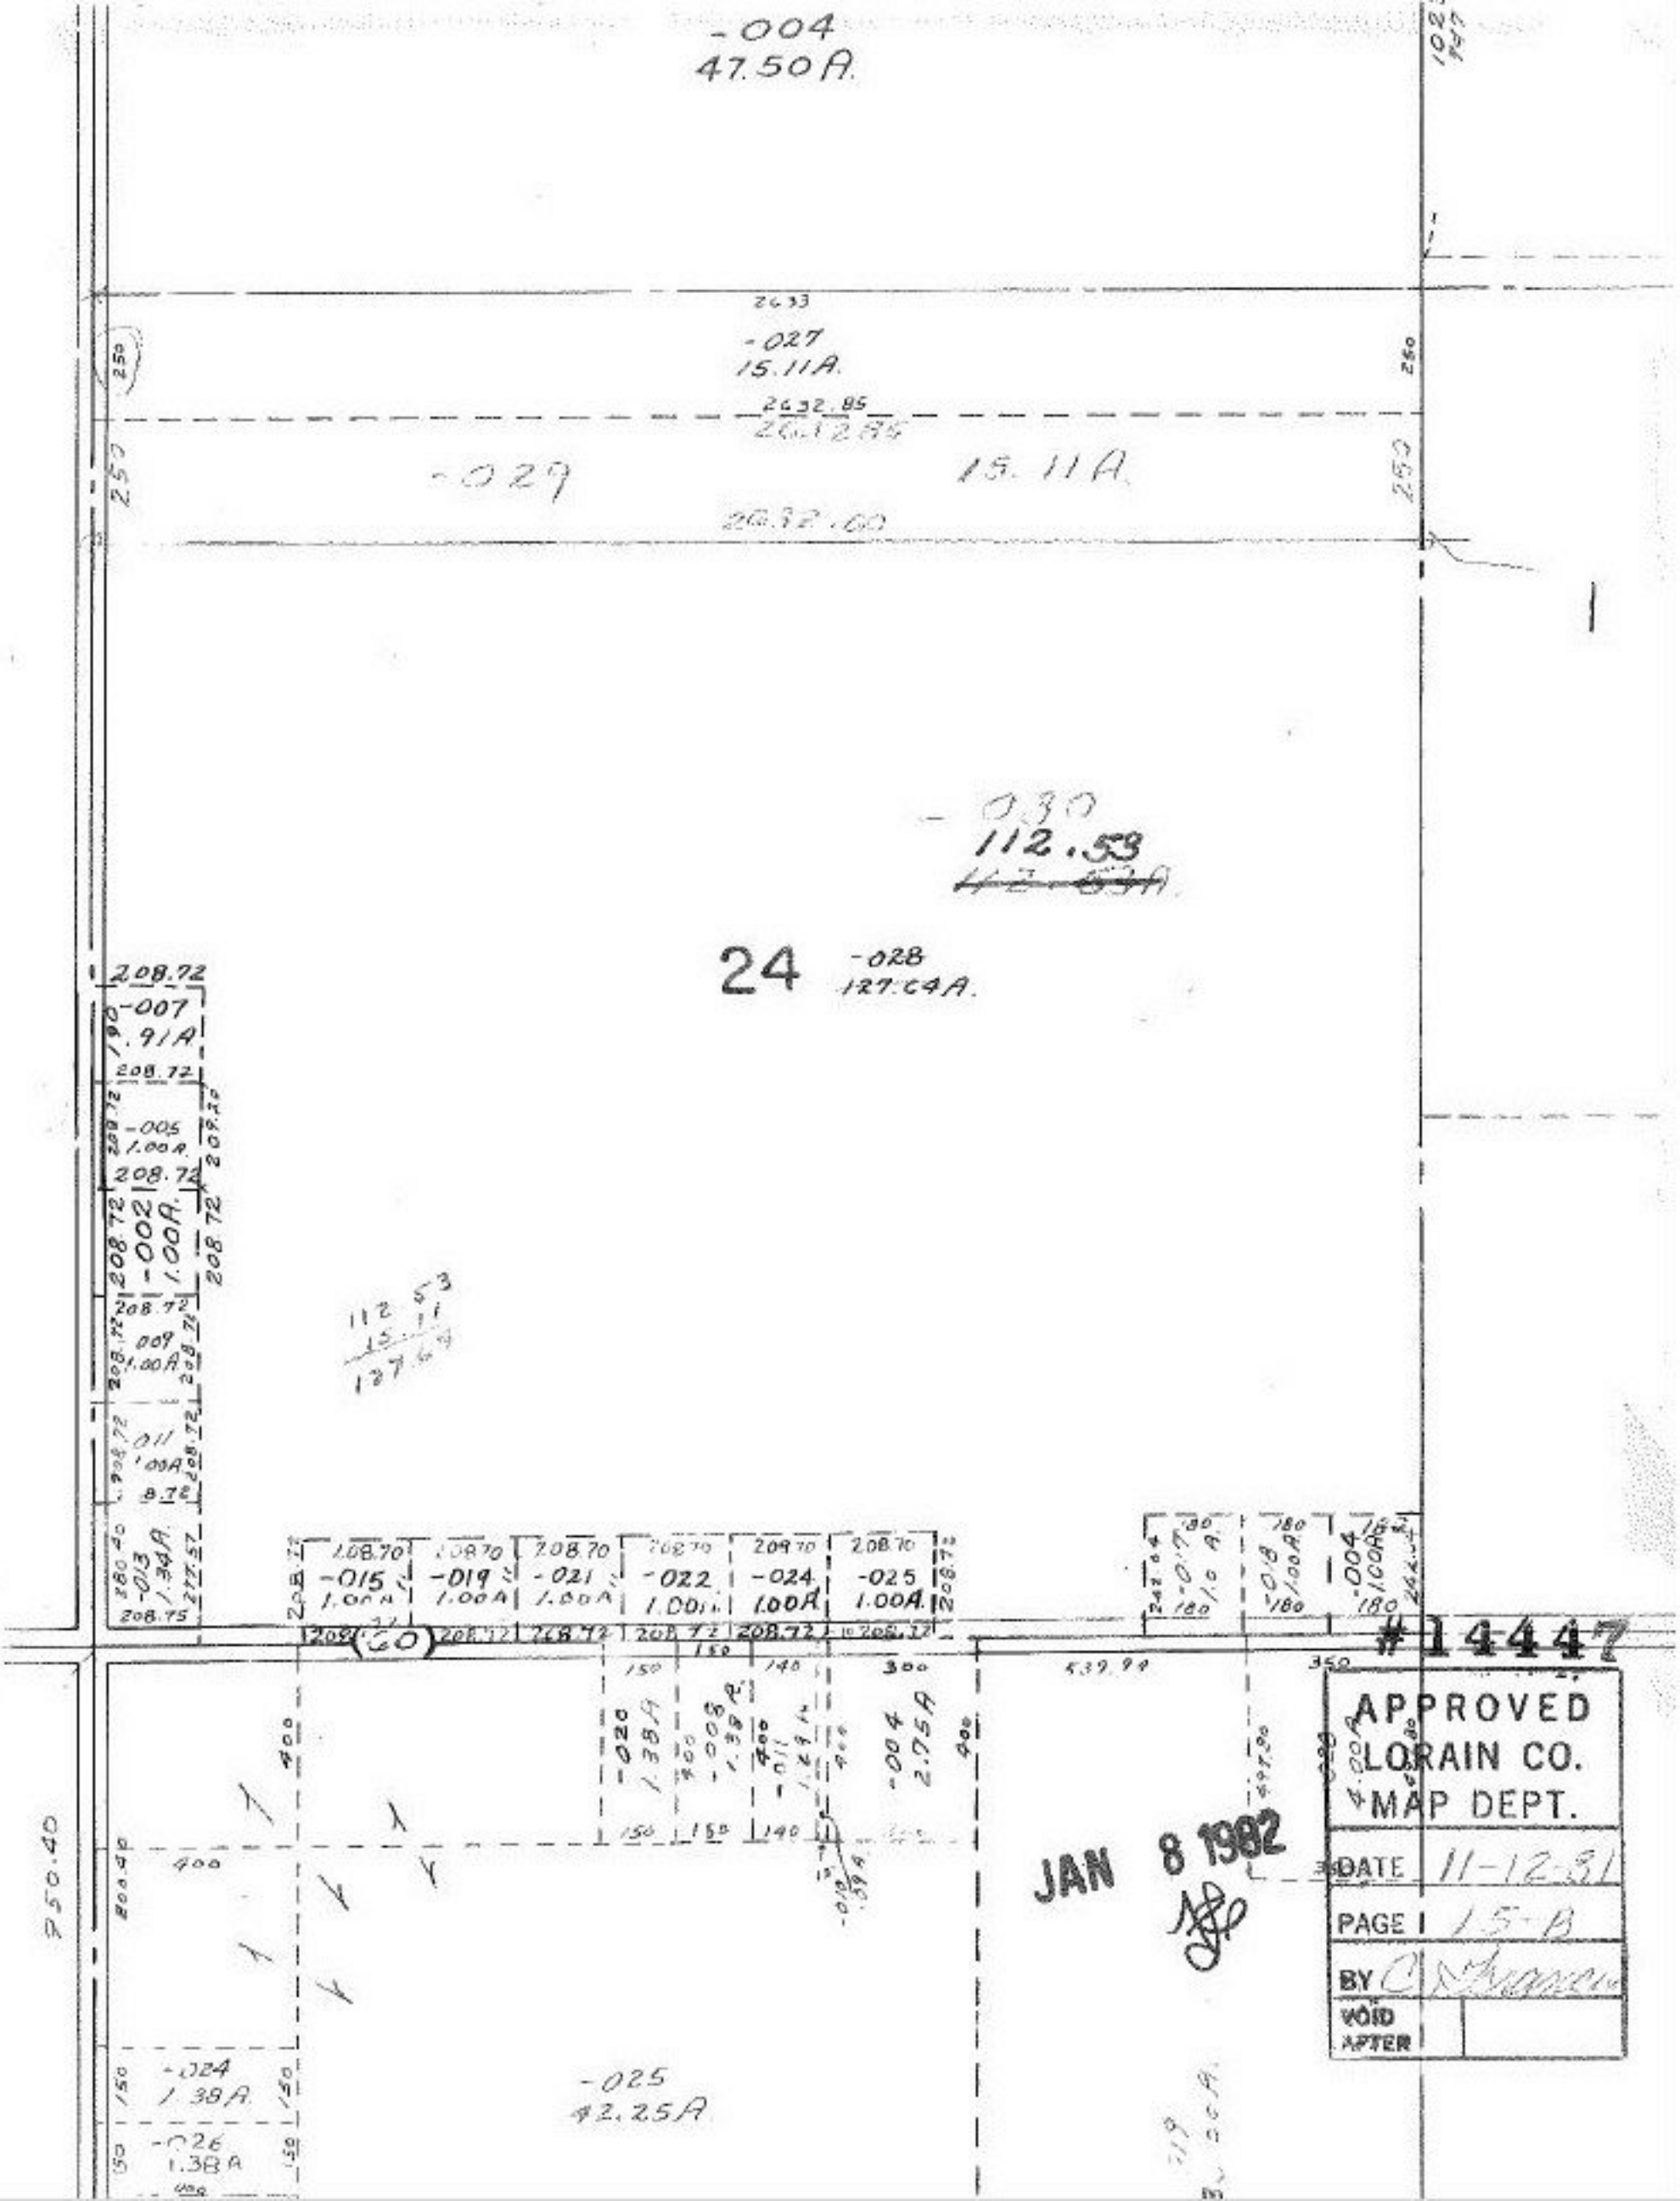
-004
47.50A.
2633
-027
15.11A.
2632.85
-029
15.11A.
2632.60
-030
112.53
24
-028
127.64A.
208.72
-007
.91A
-005
1.00A.
-002
1.00A.
-009
1.00A
-011
1.00A
-013
1.34A.
208.75
-015
1.00A
-019
1.00A
-021
1.00A
-022
1.00A
-024
1.00A
-025
1.00A.
-020
1.38A
-008
1.38A
-011
1.29A
-004
2.75A
-024
1.38A.
-026
1.38A
-025
42.25A
950.40
539.94
#14447
APPROVED
LORAIN CO.
MAP DEPT.
DATE 11-12-81
PAGE 15-B
BY
VOID AFTER
JAN 8 1982