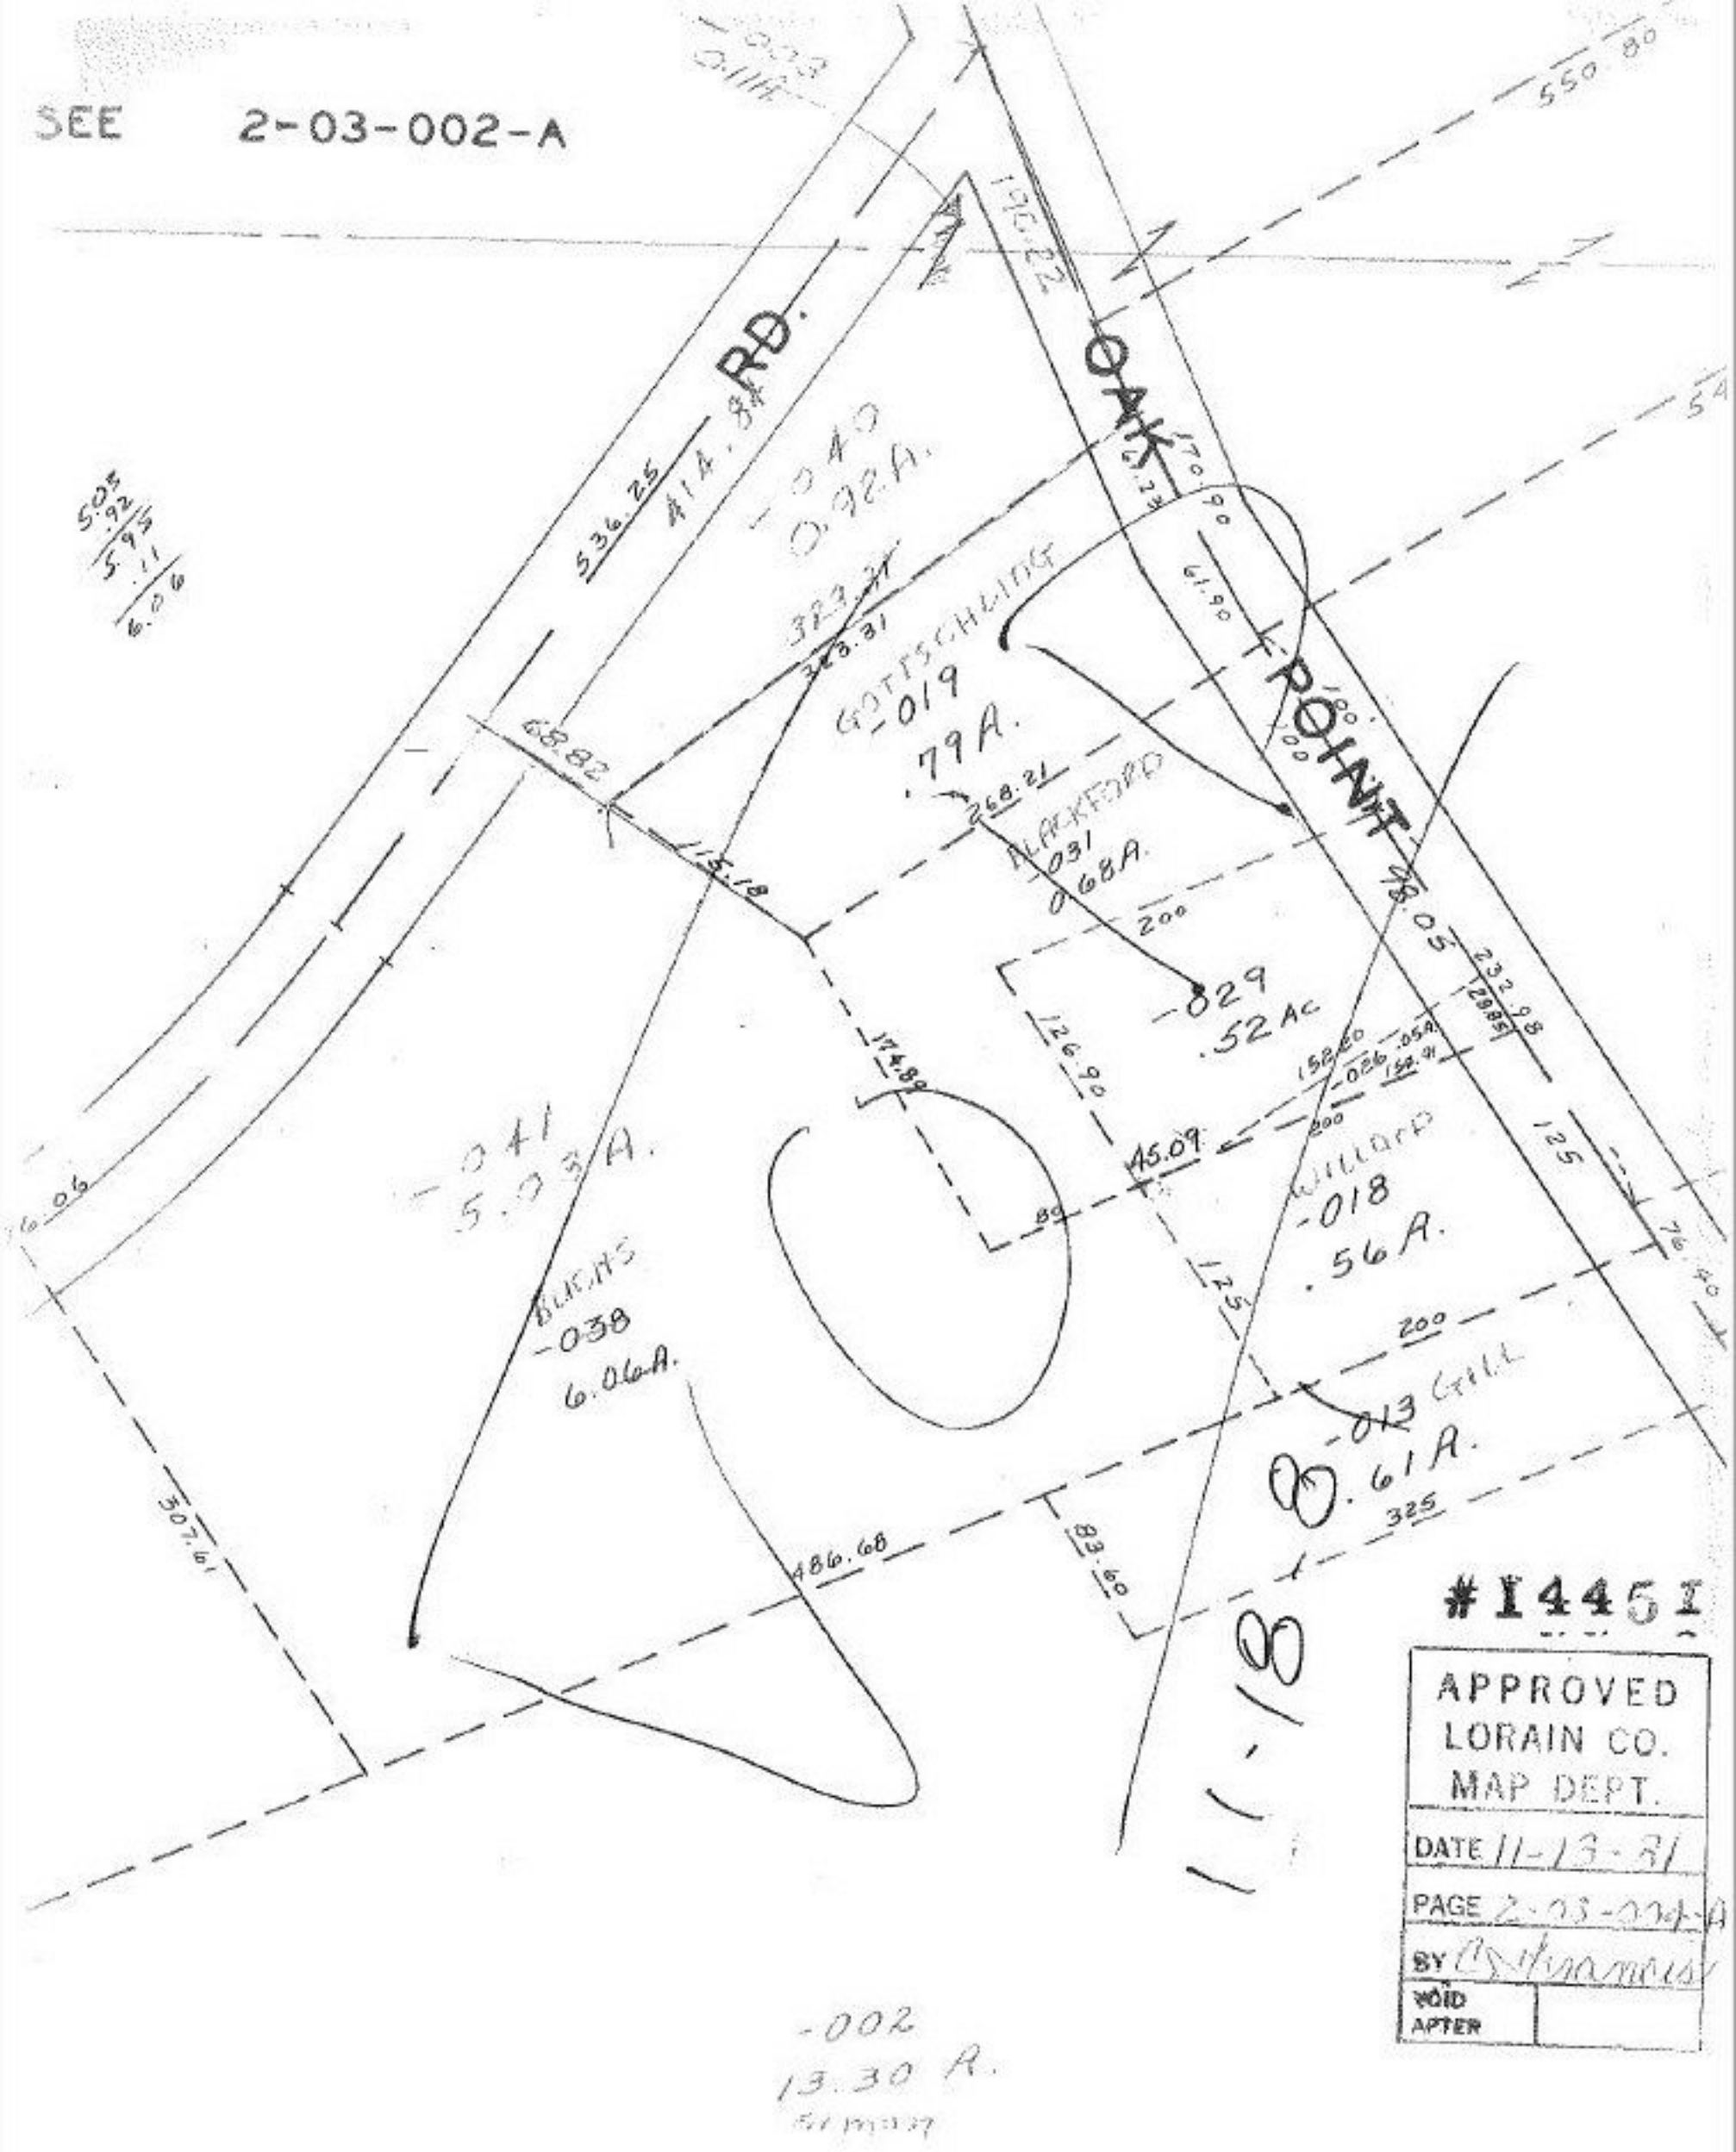
SEE 2-03-002-A
RD.
OAK
POINT
GOTTSCHLING
-019
.79A.
BLACKFORD
-031
0.68A.
-029
.52 Ac
WILLARD
-018
.56A.
-013 GILL
.61A.
BUCHS
-038
6.06A.
-041
5.03A.
-040
0.92A.
-002
13.30 A.
11-18-81
#I445I
APPROVED
LORAIN CO.
MAP DEPT.
DATE 11-13-81
PAGE 2-03-004-A
BY
VOID
AFTER