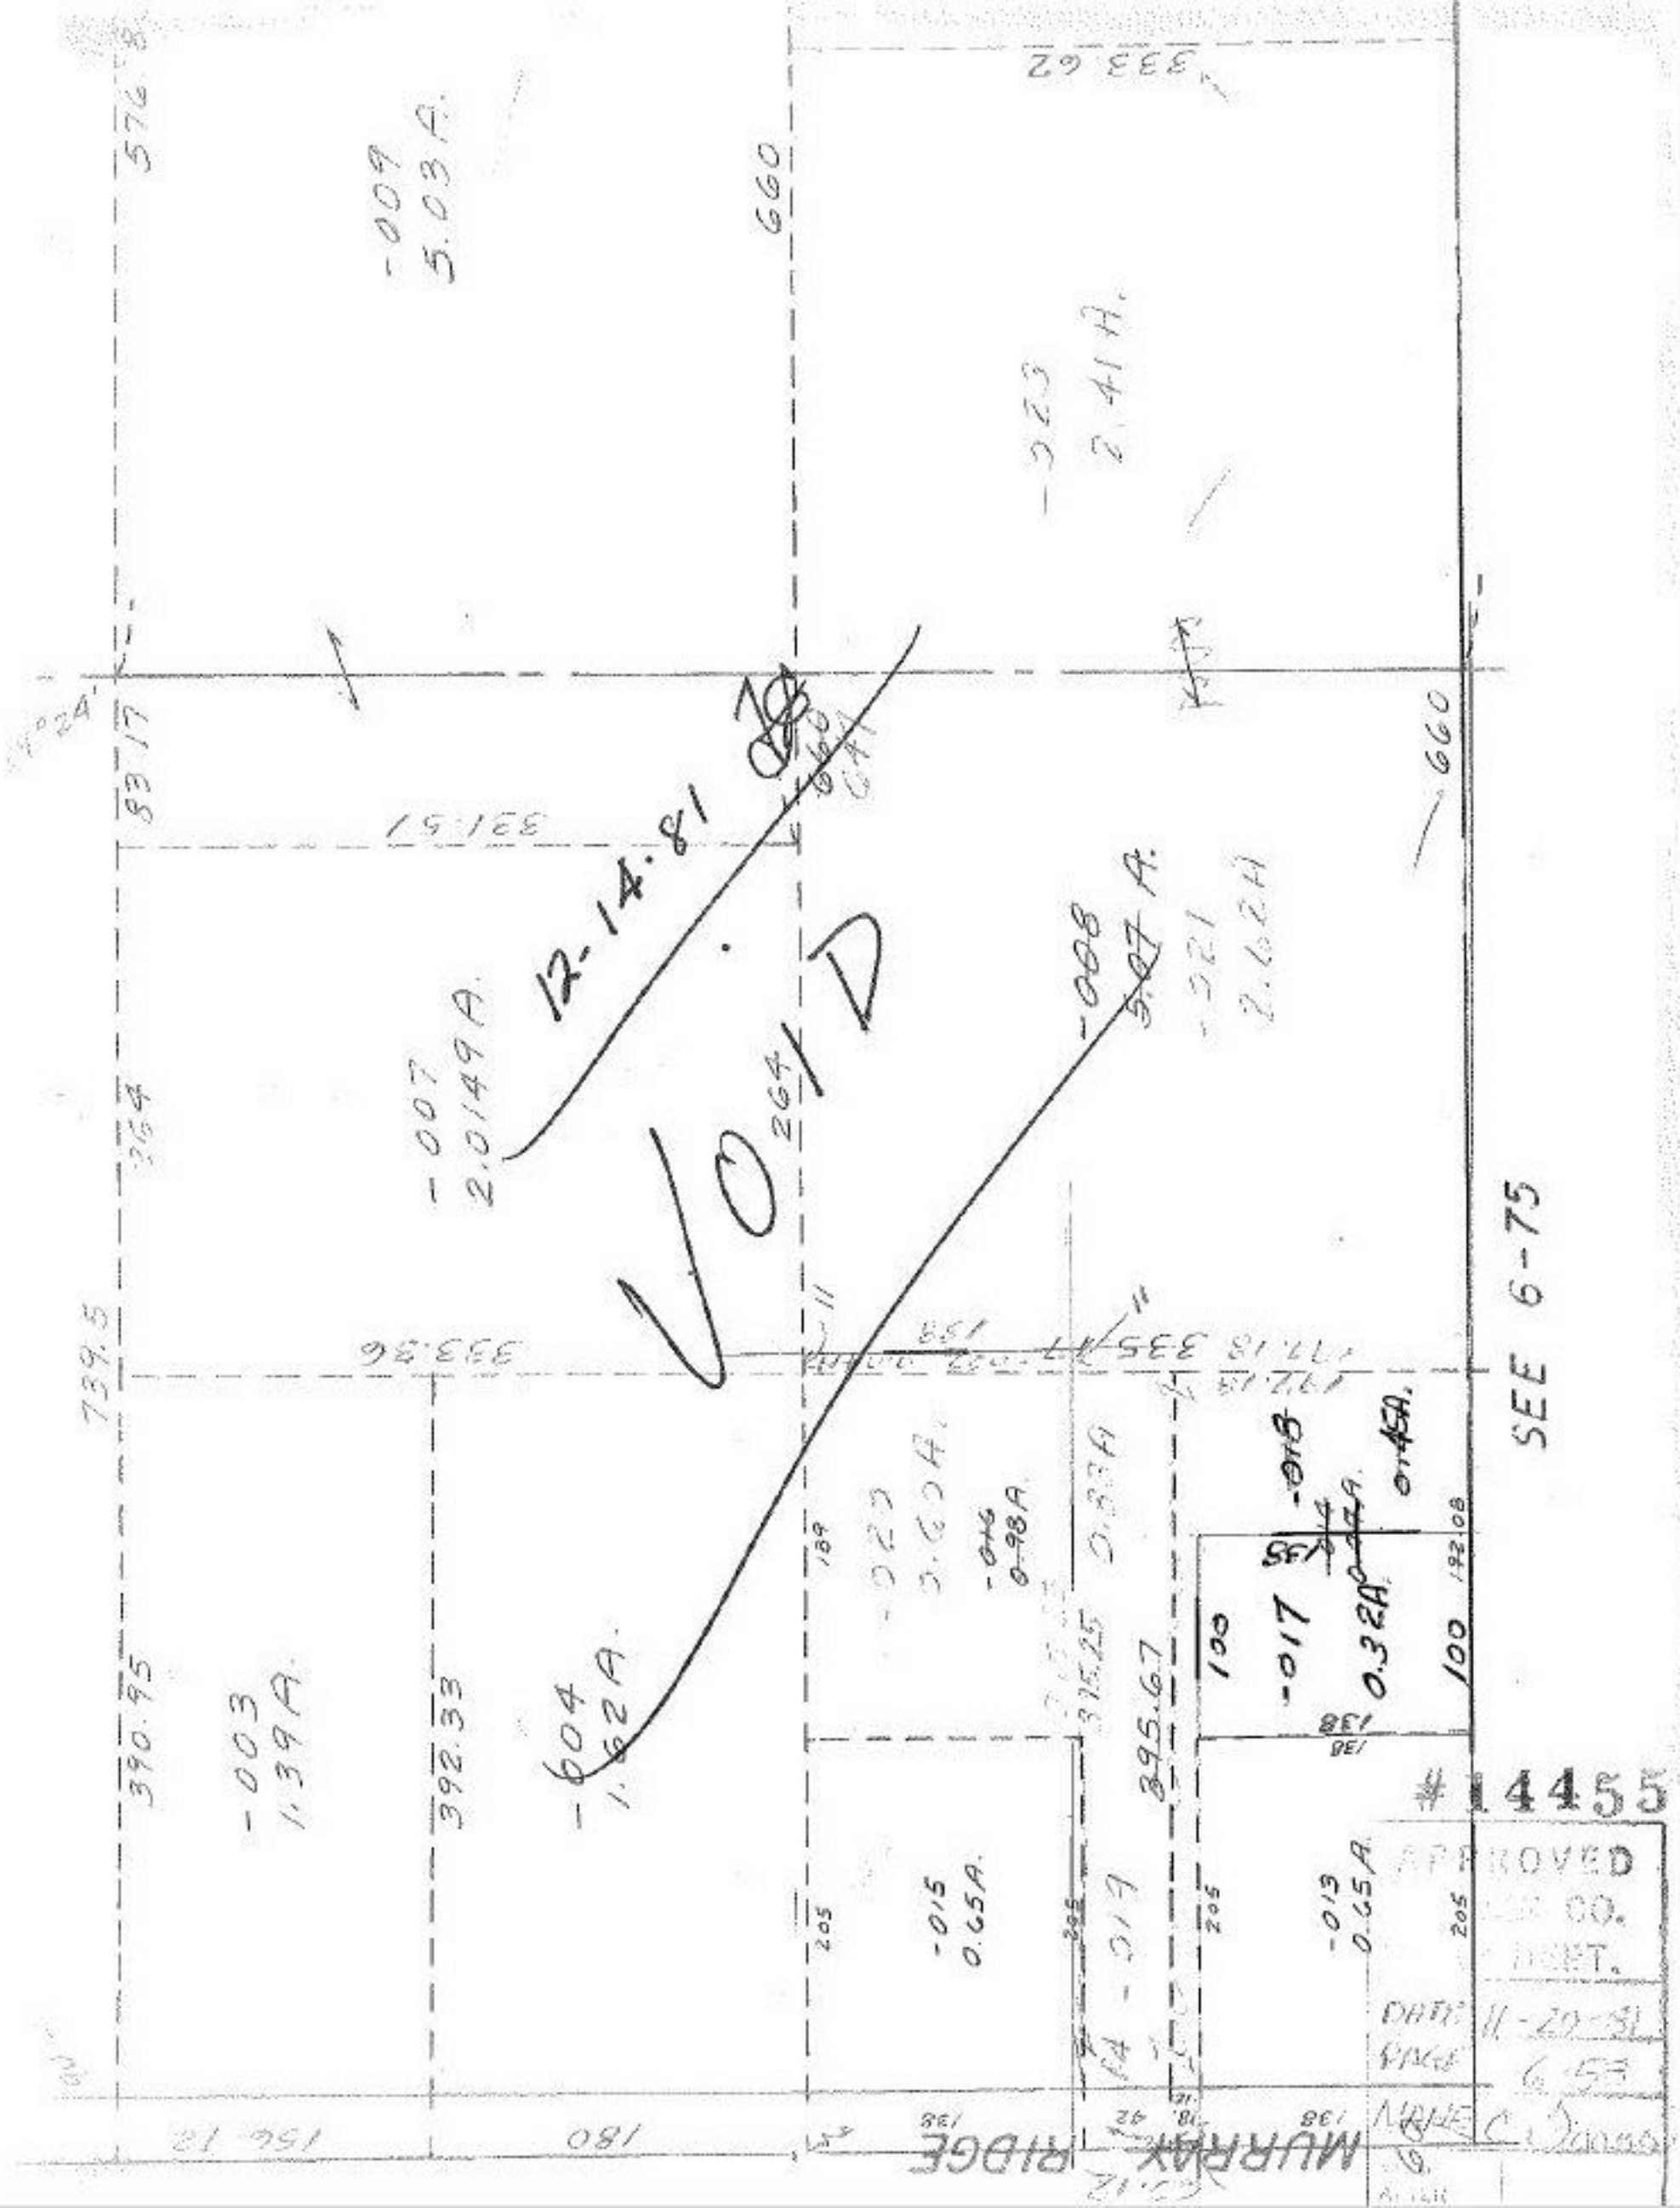

-009
5.03 A.
660
333.62
-023
2.41 A.
12-14-81
VOID
-007
2.0149 A.
-008
5.07 A.
-021
2.62 A
-003
1.39 A.
-004
1.62 A.
-015
0.65 A.
-013
0.65 A.
-017
0.32 A.
100
100
SEE 6-75
MURRAY RIDGE
#14455
APPROVED
DATE 11-20-81
PAGE 6-53