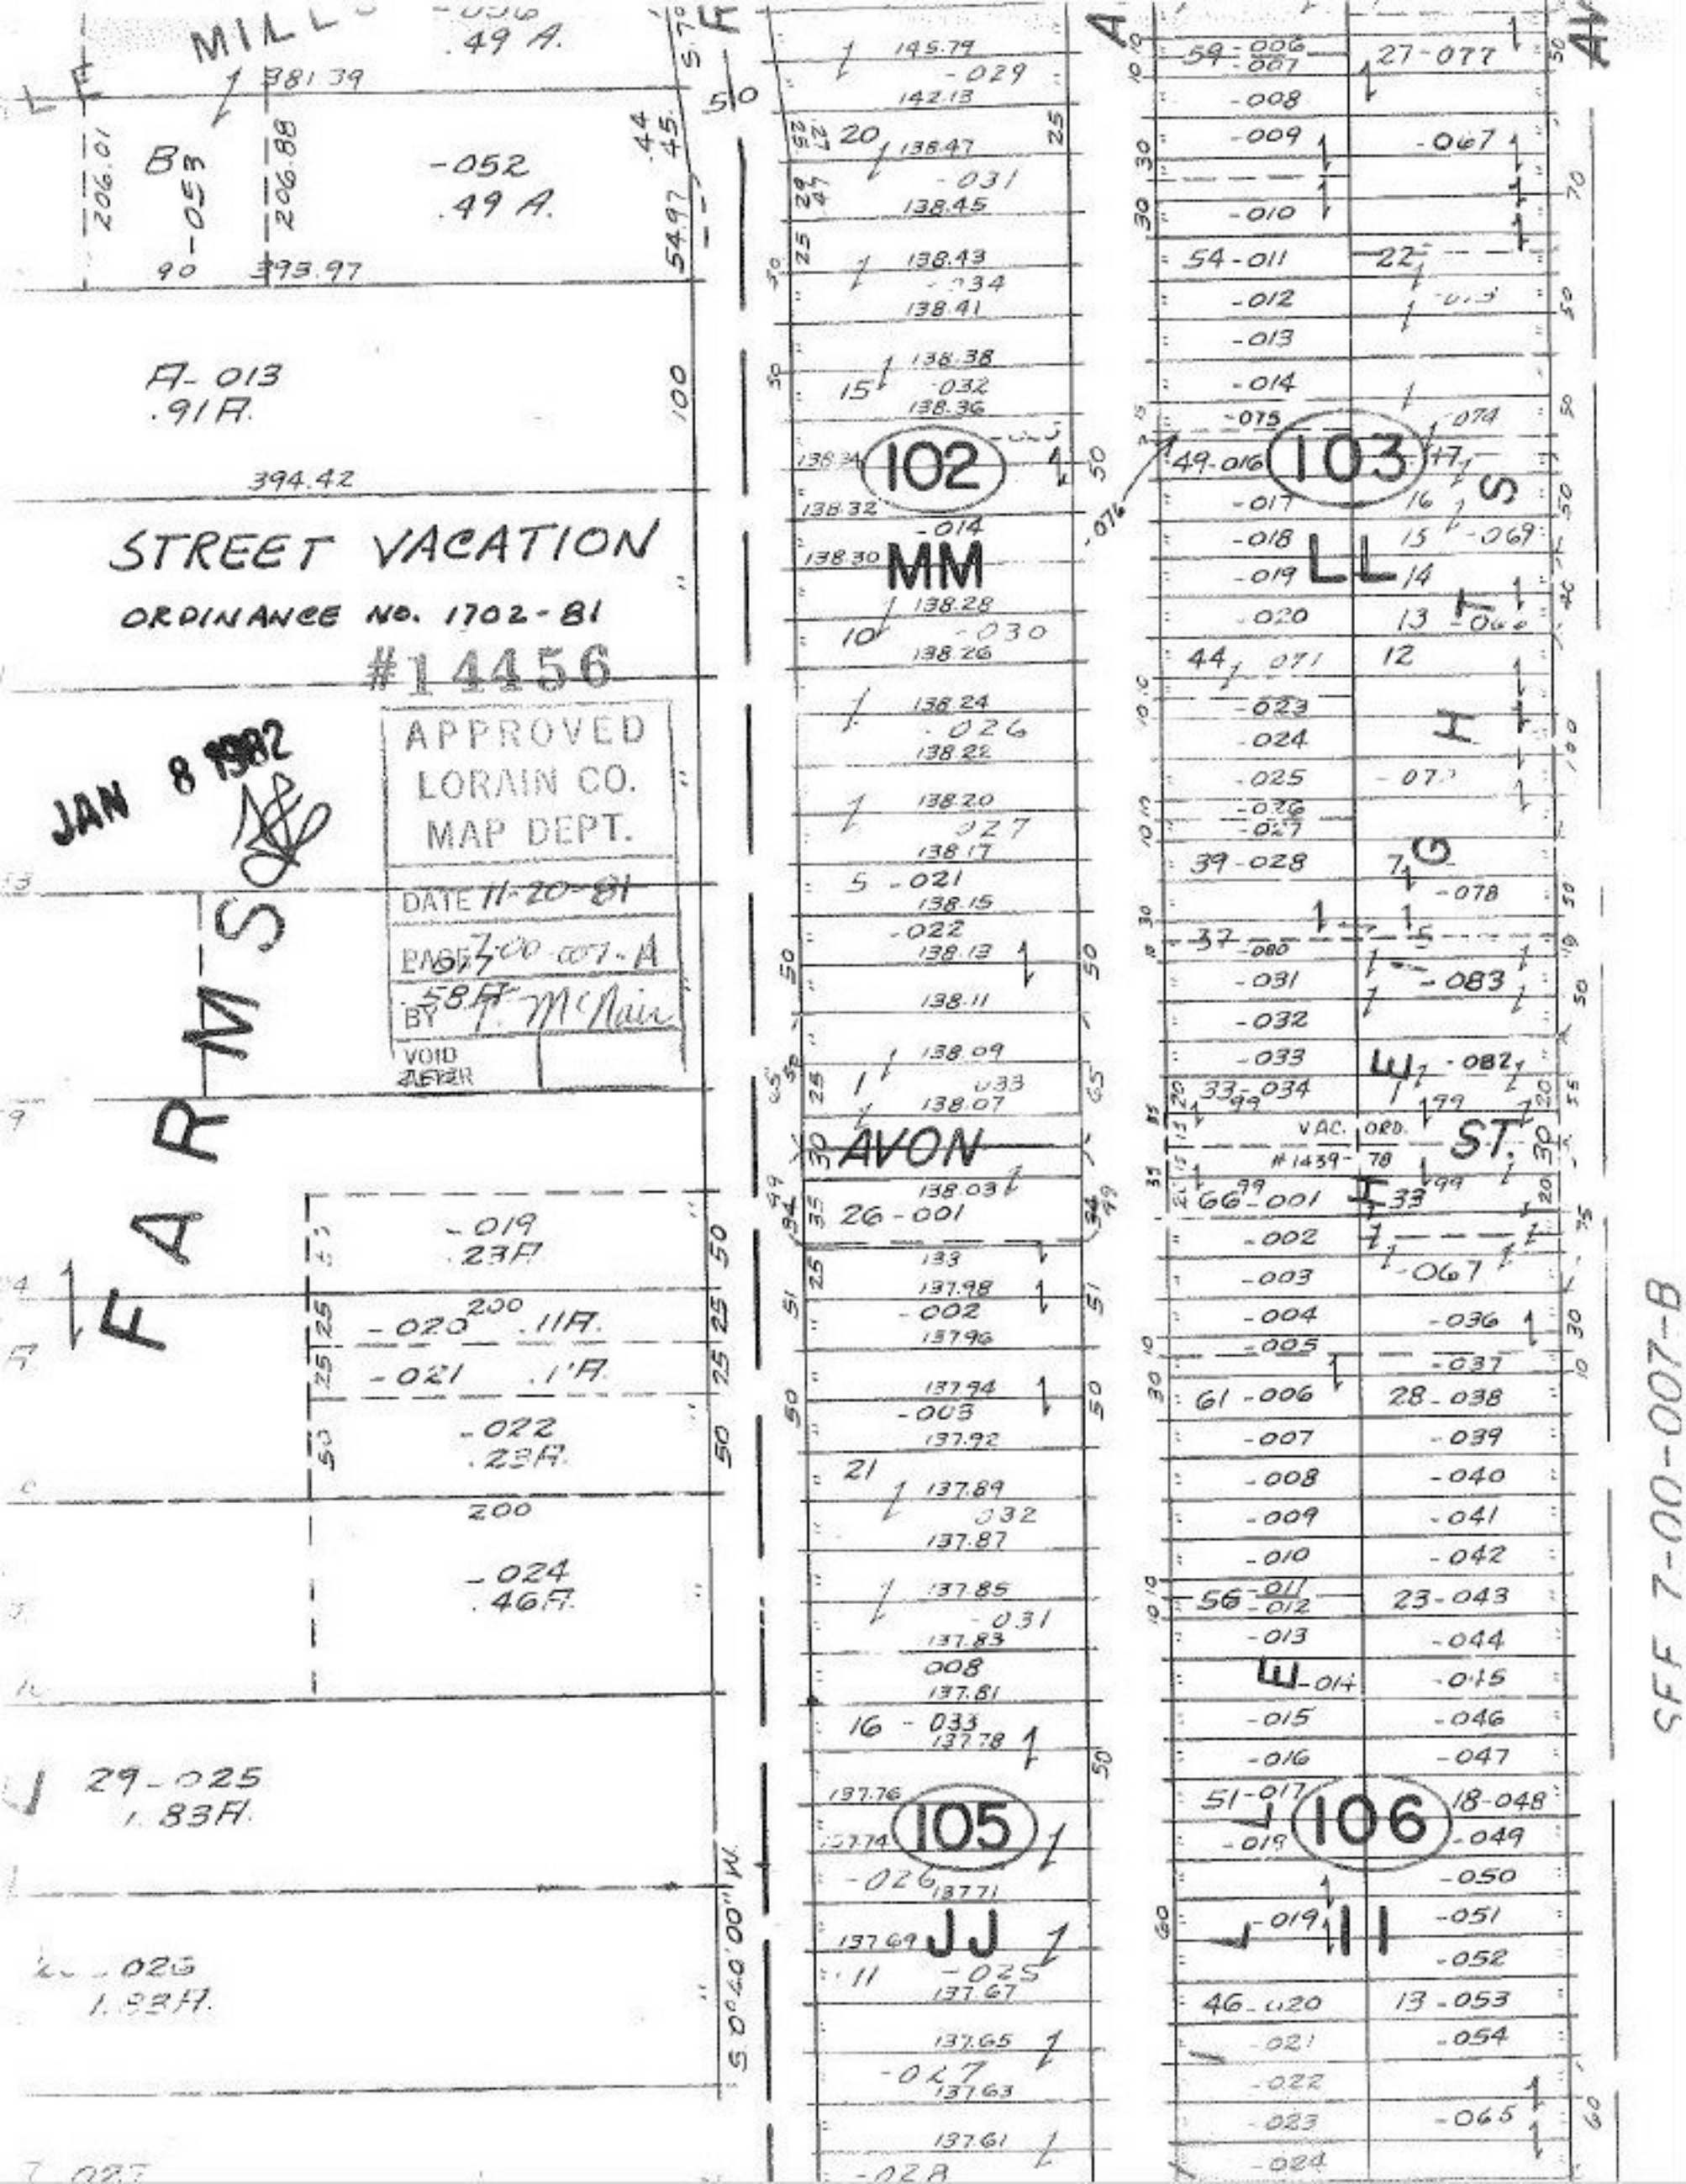

STREET VACATION
ORDINANCE NO. 1702-81
#14456
JAN 8 1982
APPROVED
LORAIN CO.
MAP DEPT.
DATE 11-20-81
PAGE 7-00-007-A
BY T. McNair
VOID AFTER
FARMS
MILLS
102
MM
103
LL
AVON
105
JJ
106
II
ST.
VAC. ORD. #1439-78
SEE 7-00-007-B