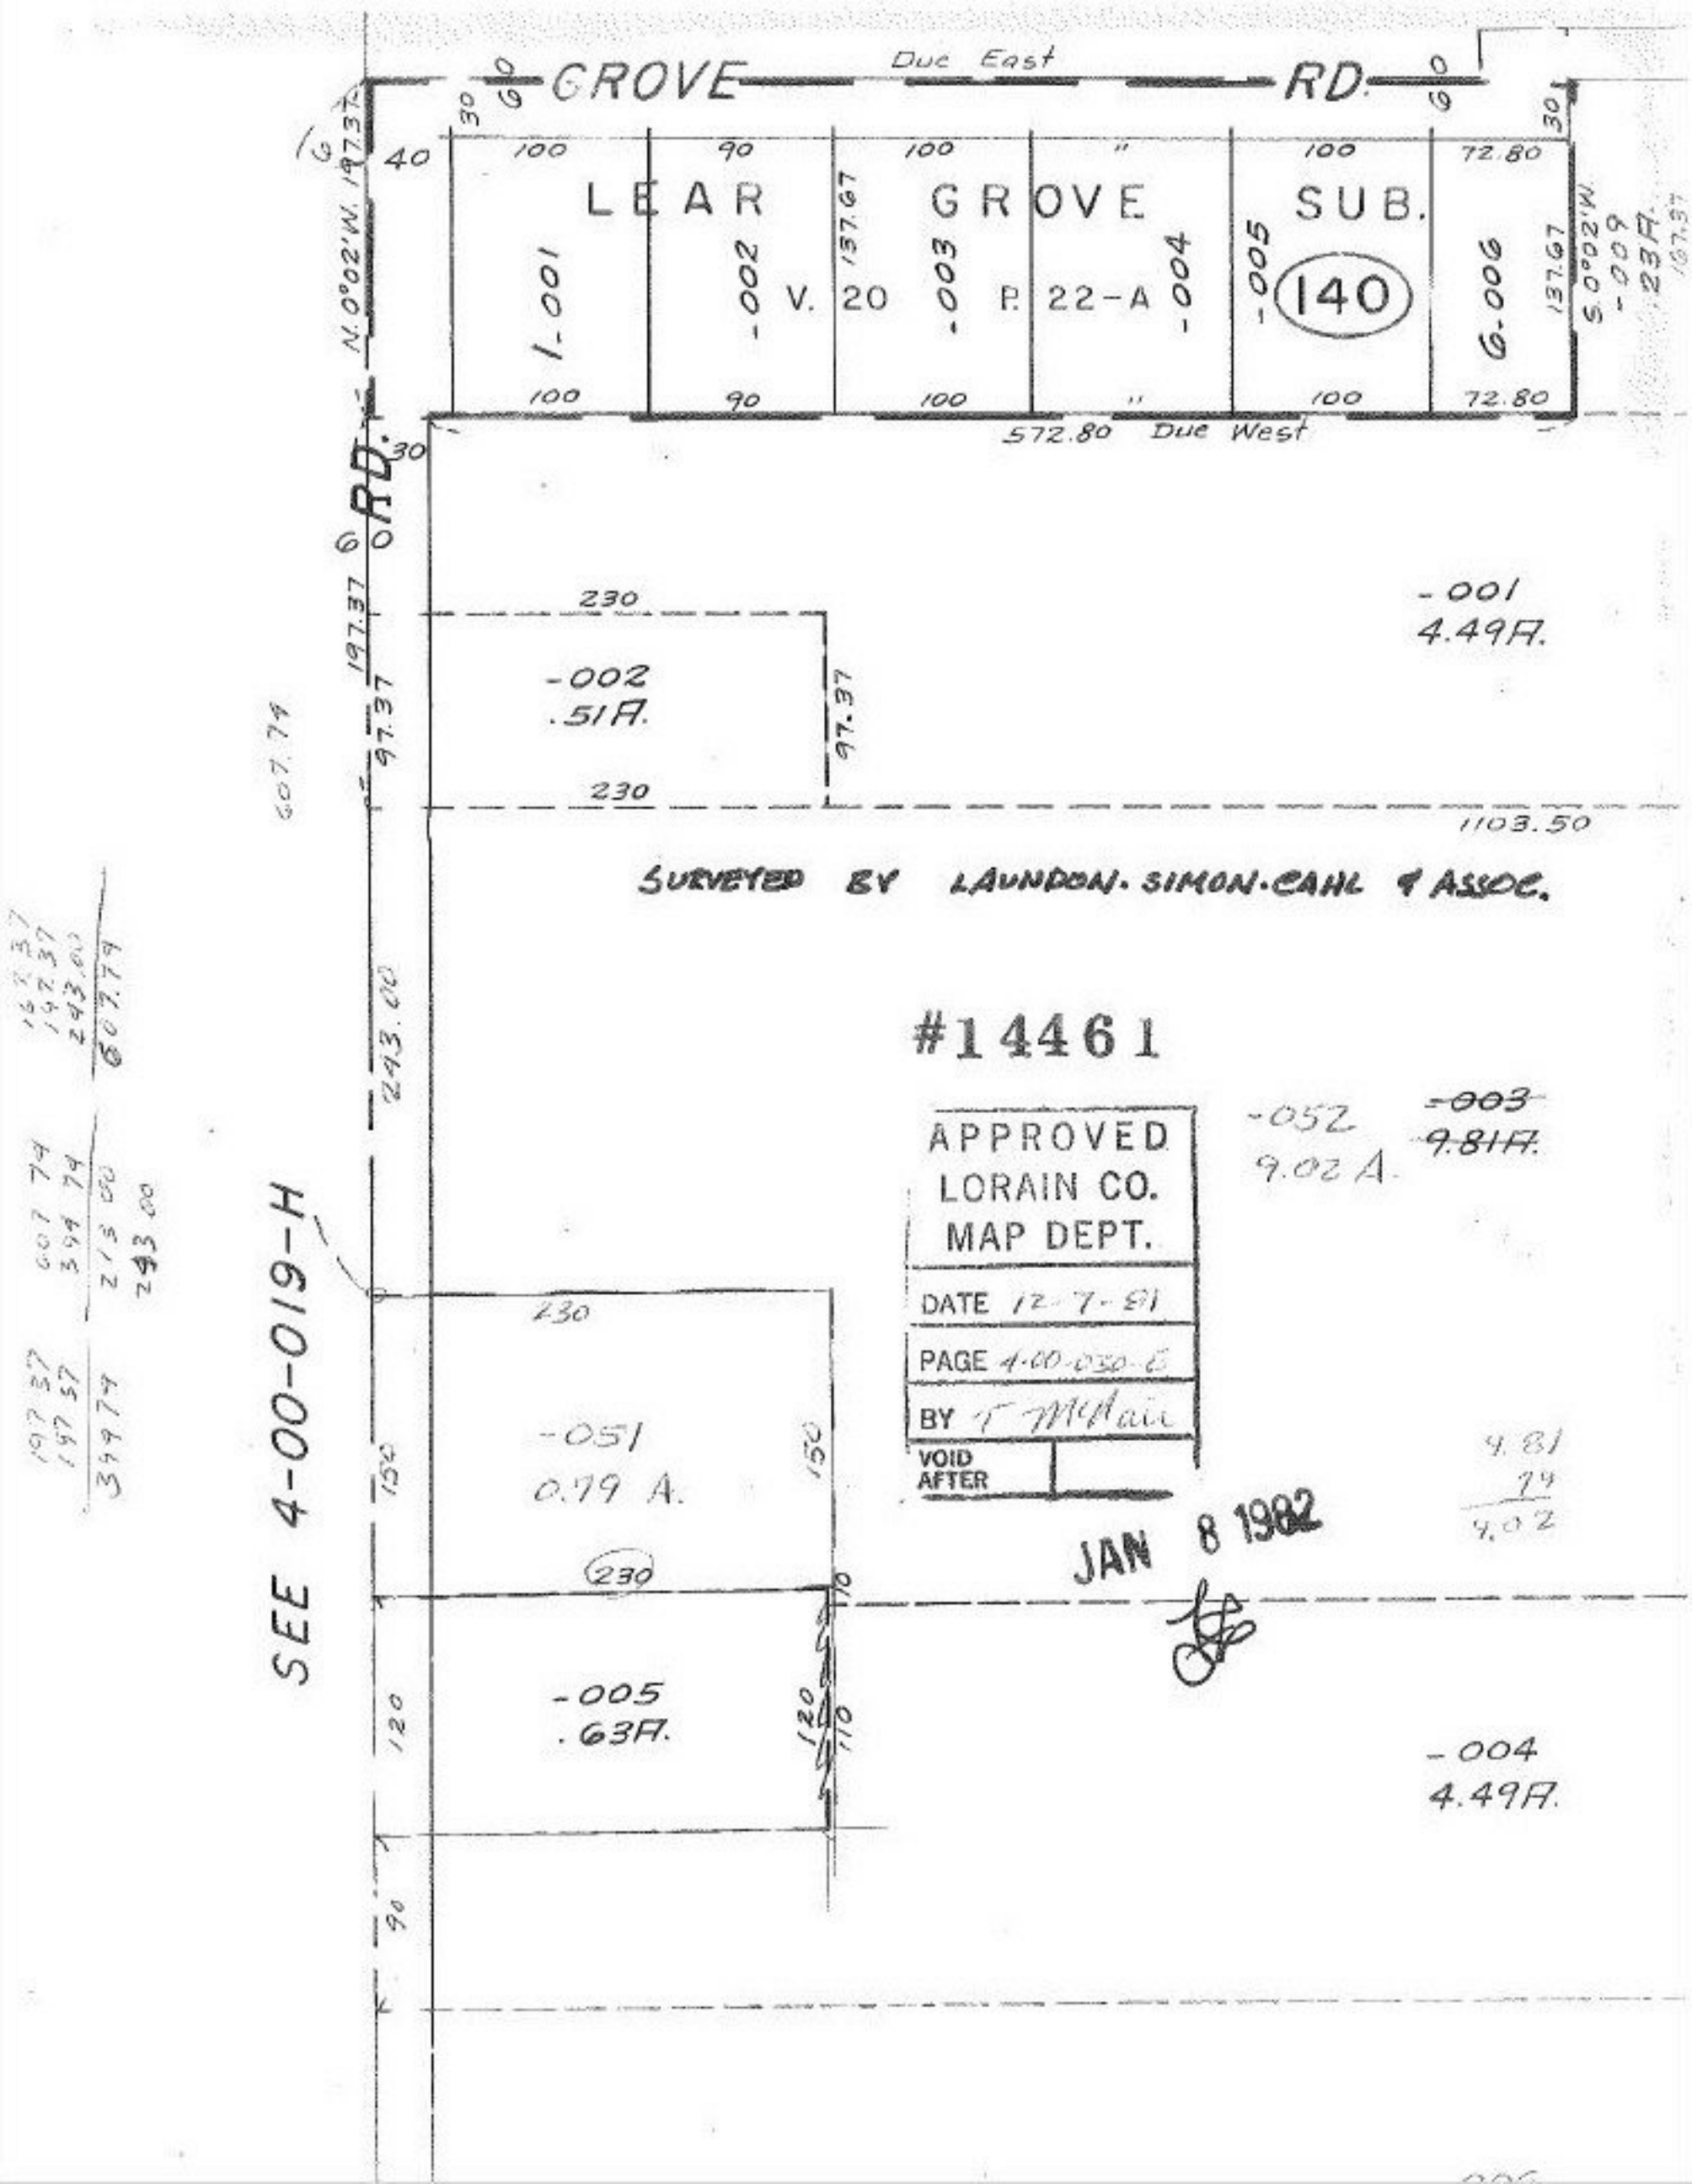
GROVE RD.
Due East
LEAR GROVE SUB.
V. 20 P. 22-A
140
1-001
-002
-003
-004
-005
6-006
572.80 Due West
N. 0°02'W. 197.37
S. 0°02'W. -009 .23A.
-001 4.49A.
-002 .51A.
1103.50
SURVEYED BY LAUNDON. SIMON. CAHL & ASSOC.
#14461
APPROVED LORAIN CO. MAP DEPT.
DATE 12-7-81
PAGE 4-00-030-E
BY T McNair
VOID AFTER
-052 9.02 A.
~~-003 9.81A.~~
-051 0.79 A.
-005 .63A.
-004 4.49A.
JAN 8 1982
SEE 4-00-019-H
607.74
243.00
197.37
197.37
349.74
607.74
394.74
213.00
243.00
167.37
197.37
243.00
607.74
4.81
.74
4.02