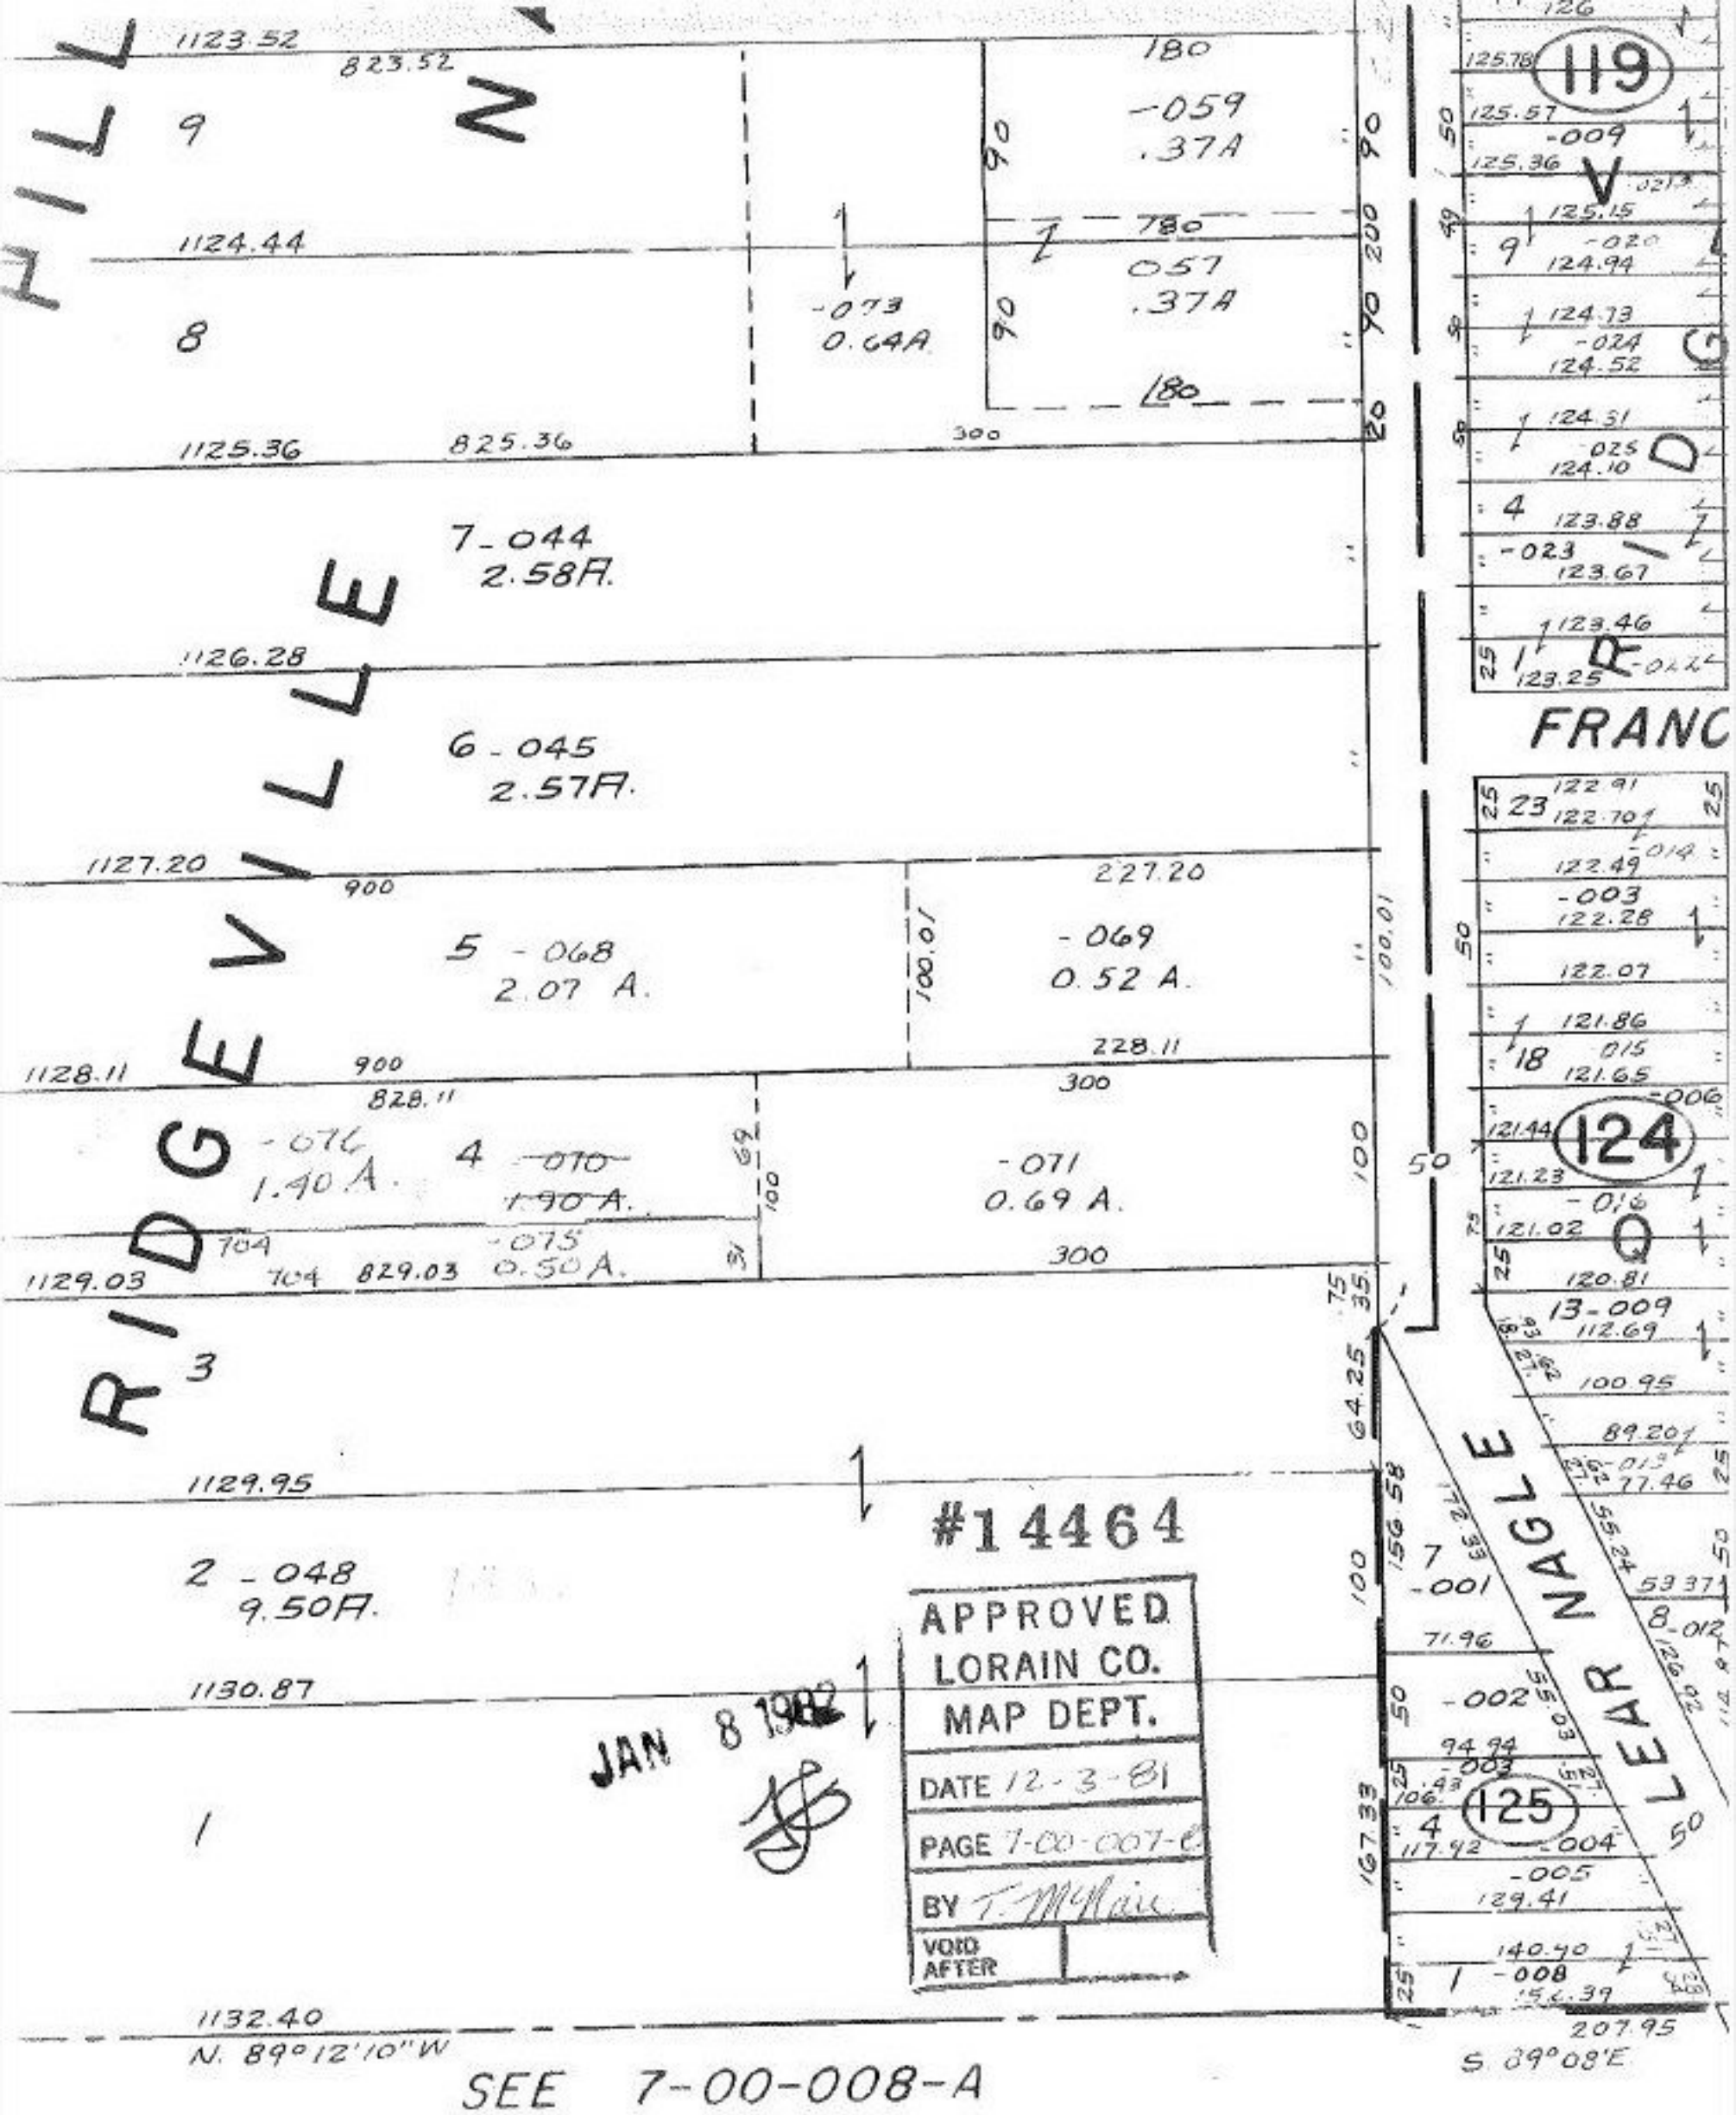

HILL
RIDGEVILLE
FRANC
LEAR NAGLE
1123.52
823.52
9
1124.44
8
1125.36
825.36
180
-059
.37A
780
057
.37A
-073
0.64A
300
7-044
2.58A.
1126.28
6-045
2.57A.
1127.20
900
5-068
2.07 A.
227.20
-069
0.52 A.
100.01
228.11
1128.11
828.11
-076
1.40 A.
4 ~~-070~~
~~1.90 A.~~
-071
0.69 A.
704
-075
0.50 A.
1129.03
829.03
3
1129.95
2-048
9.50A.
1130.87
1
1132.40
N. 89°12'10"W
SEE 7-00-008-A
119
124
125
207.95
S. 89°08'E
#14464
APPROVED
LORAIN CO.
MAP DEPT.
DATE 12-3-81
PAGE 7-00-007-C
BY T. McNair
VOID AFTER
JAN 8 1982