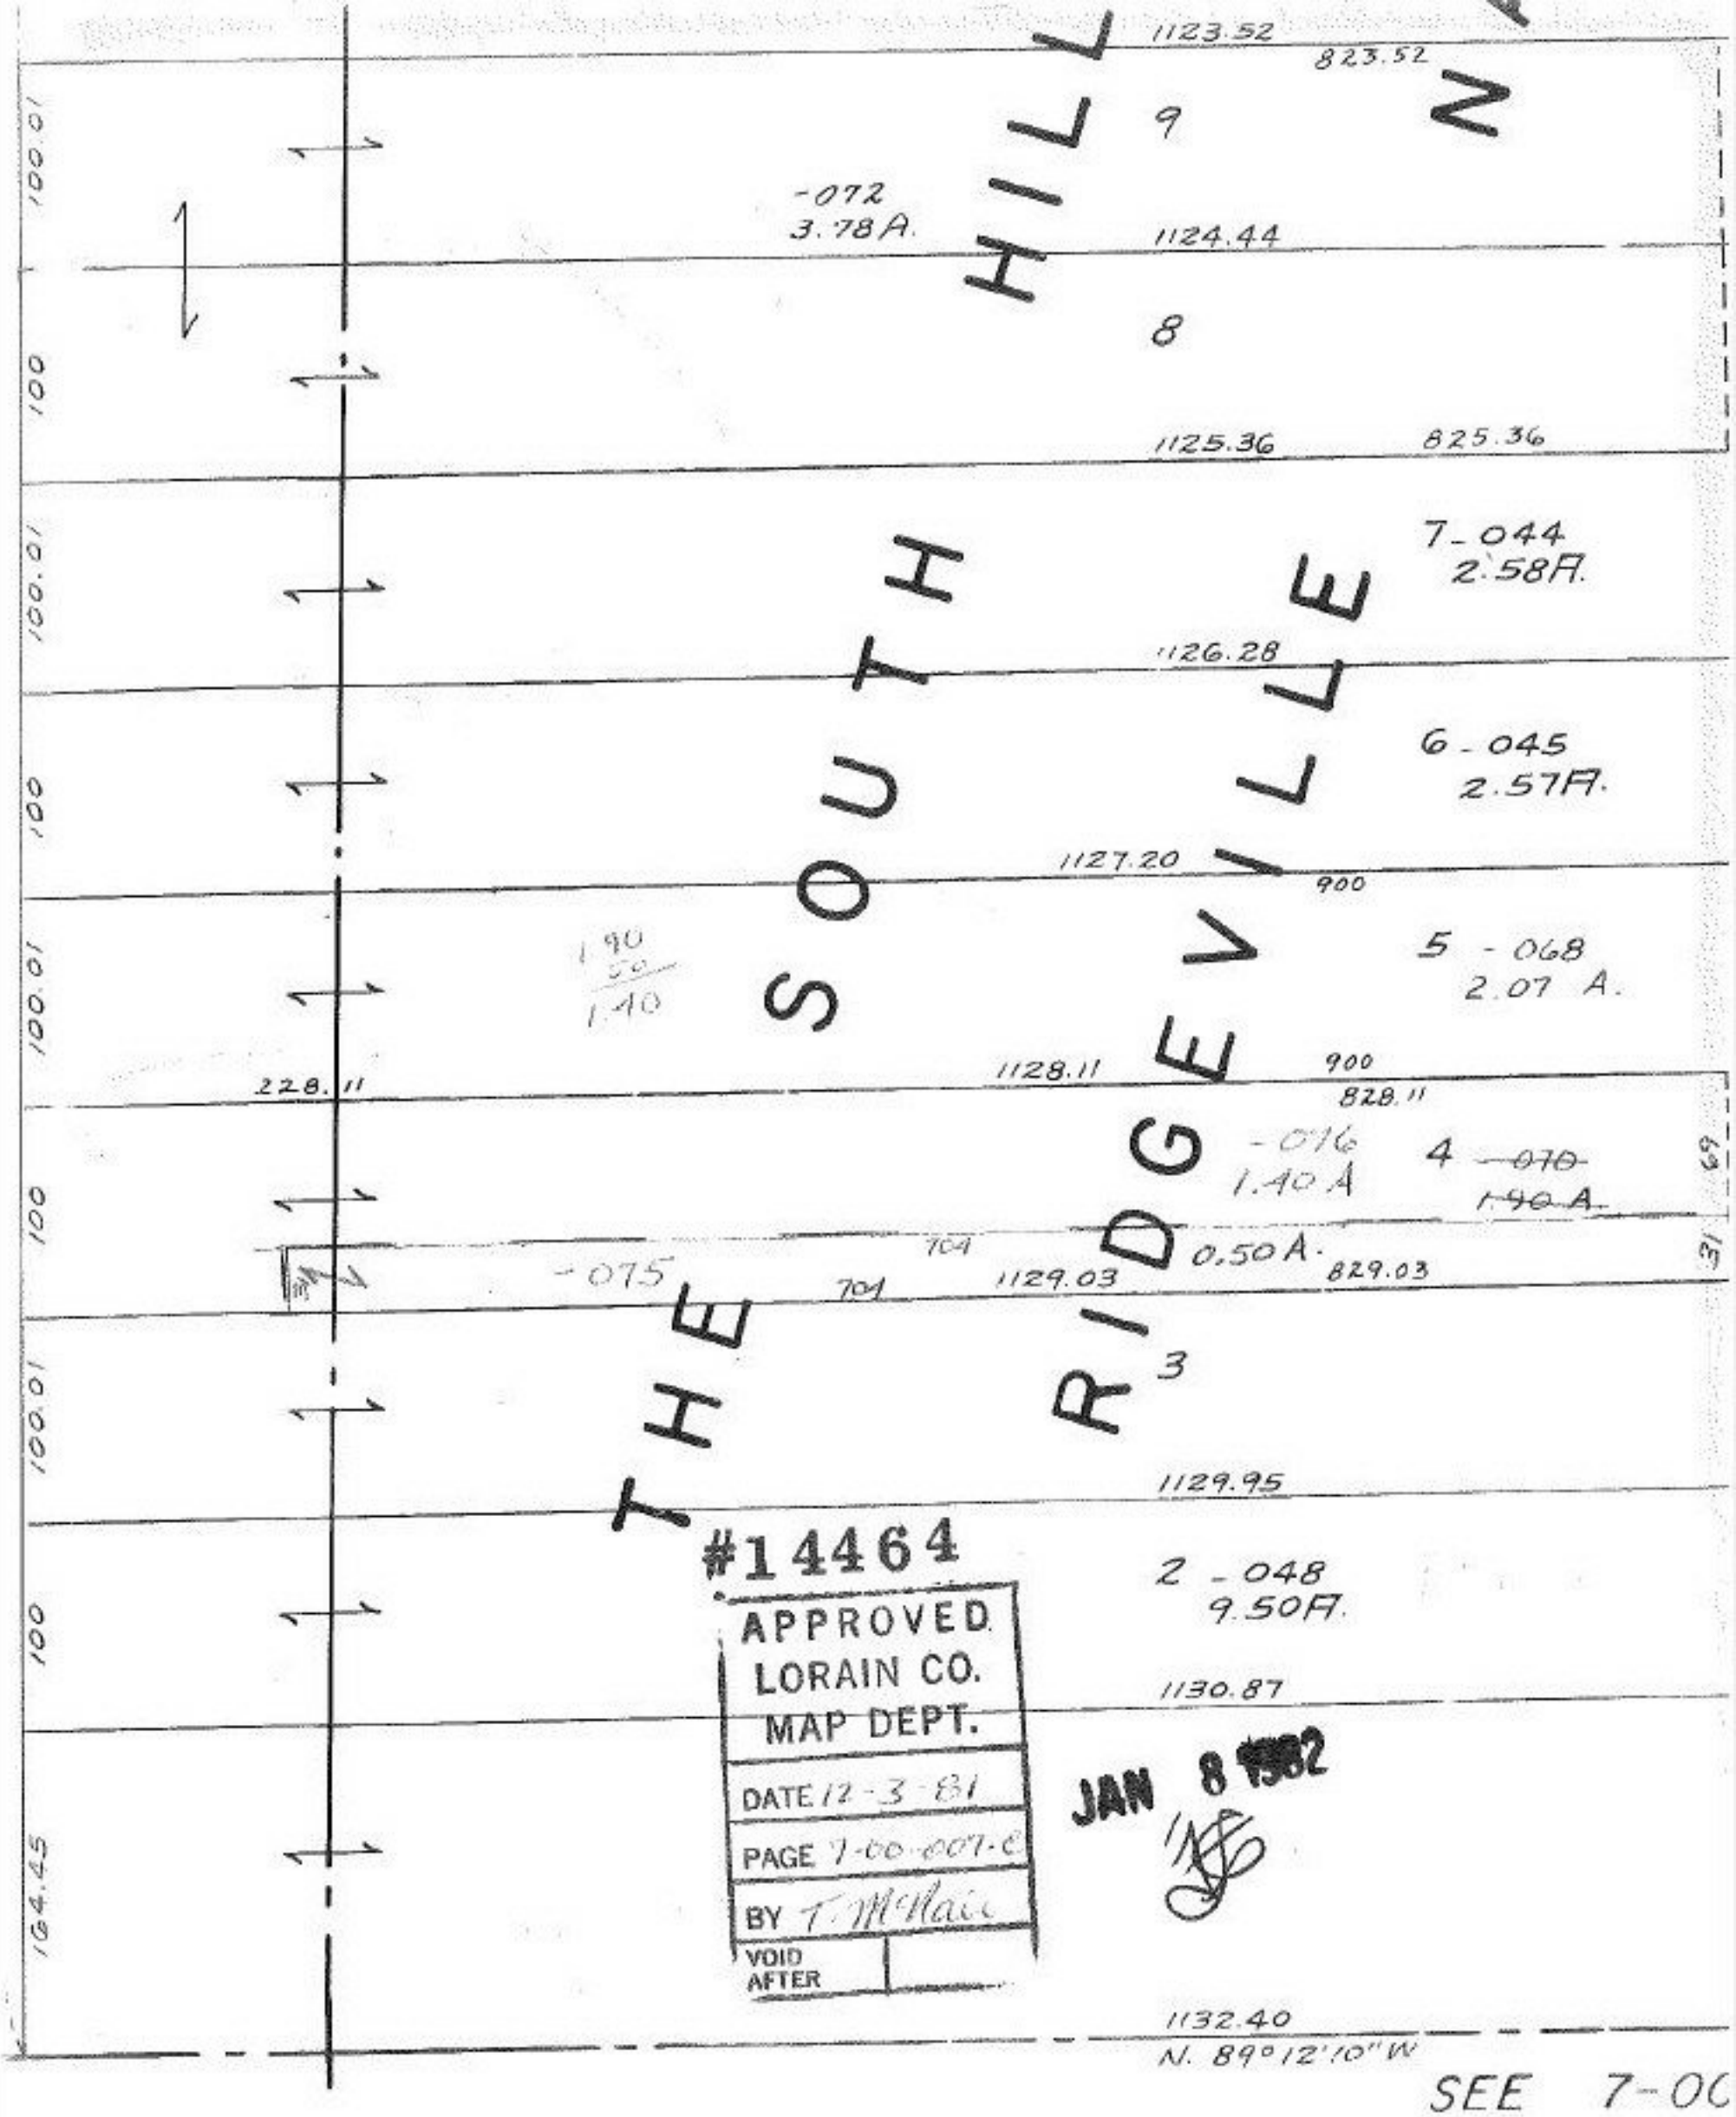

#14464

APPROVED
LORAIN CO.
MAP DEPT.
DATE 12-3-81
PAGE 7-00-007-C
BY T. McNair
VOID AFTER

JAN 8 1982

SEE 7-00