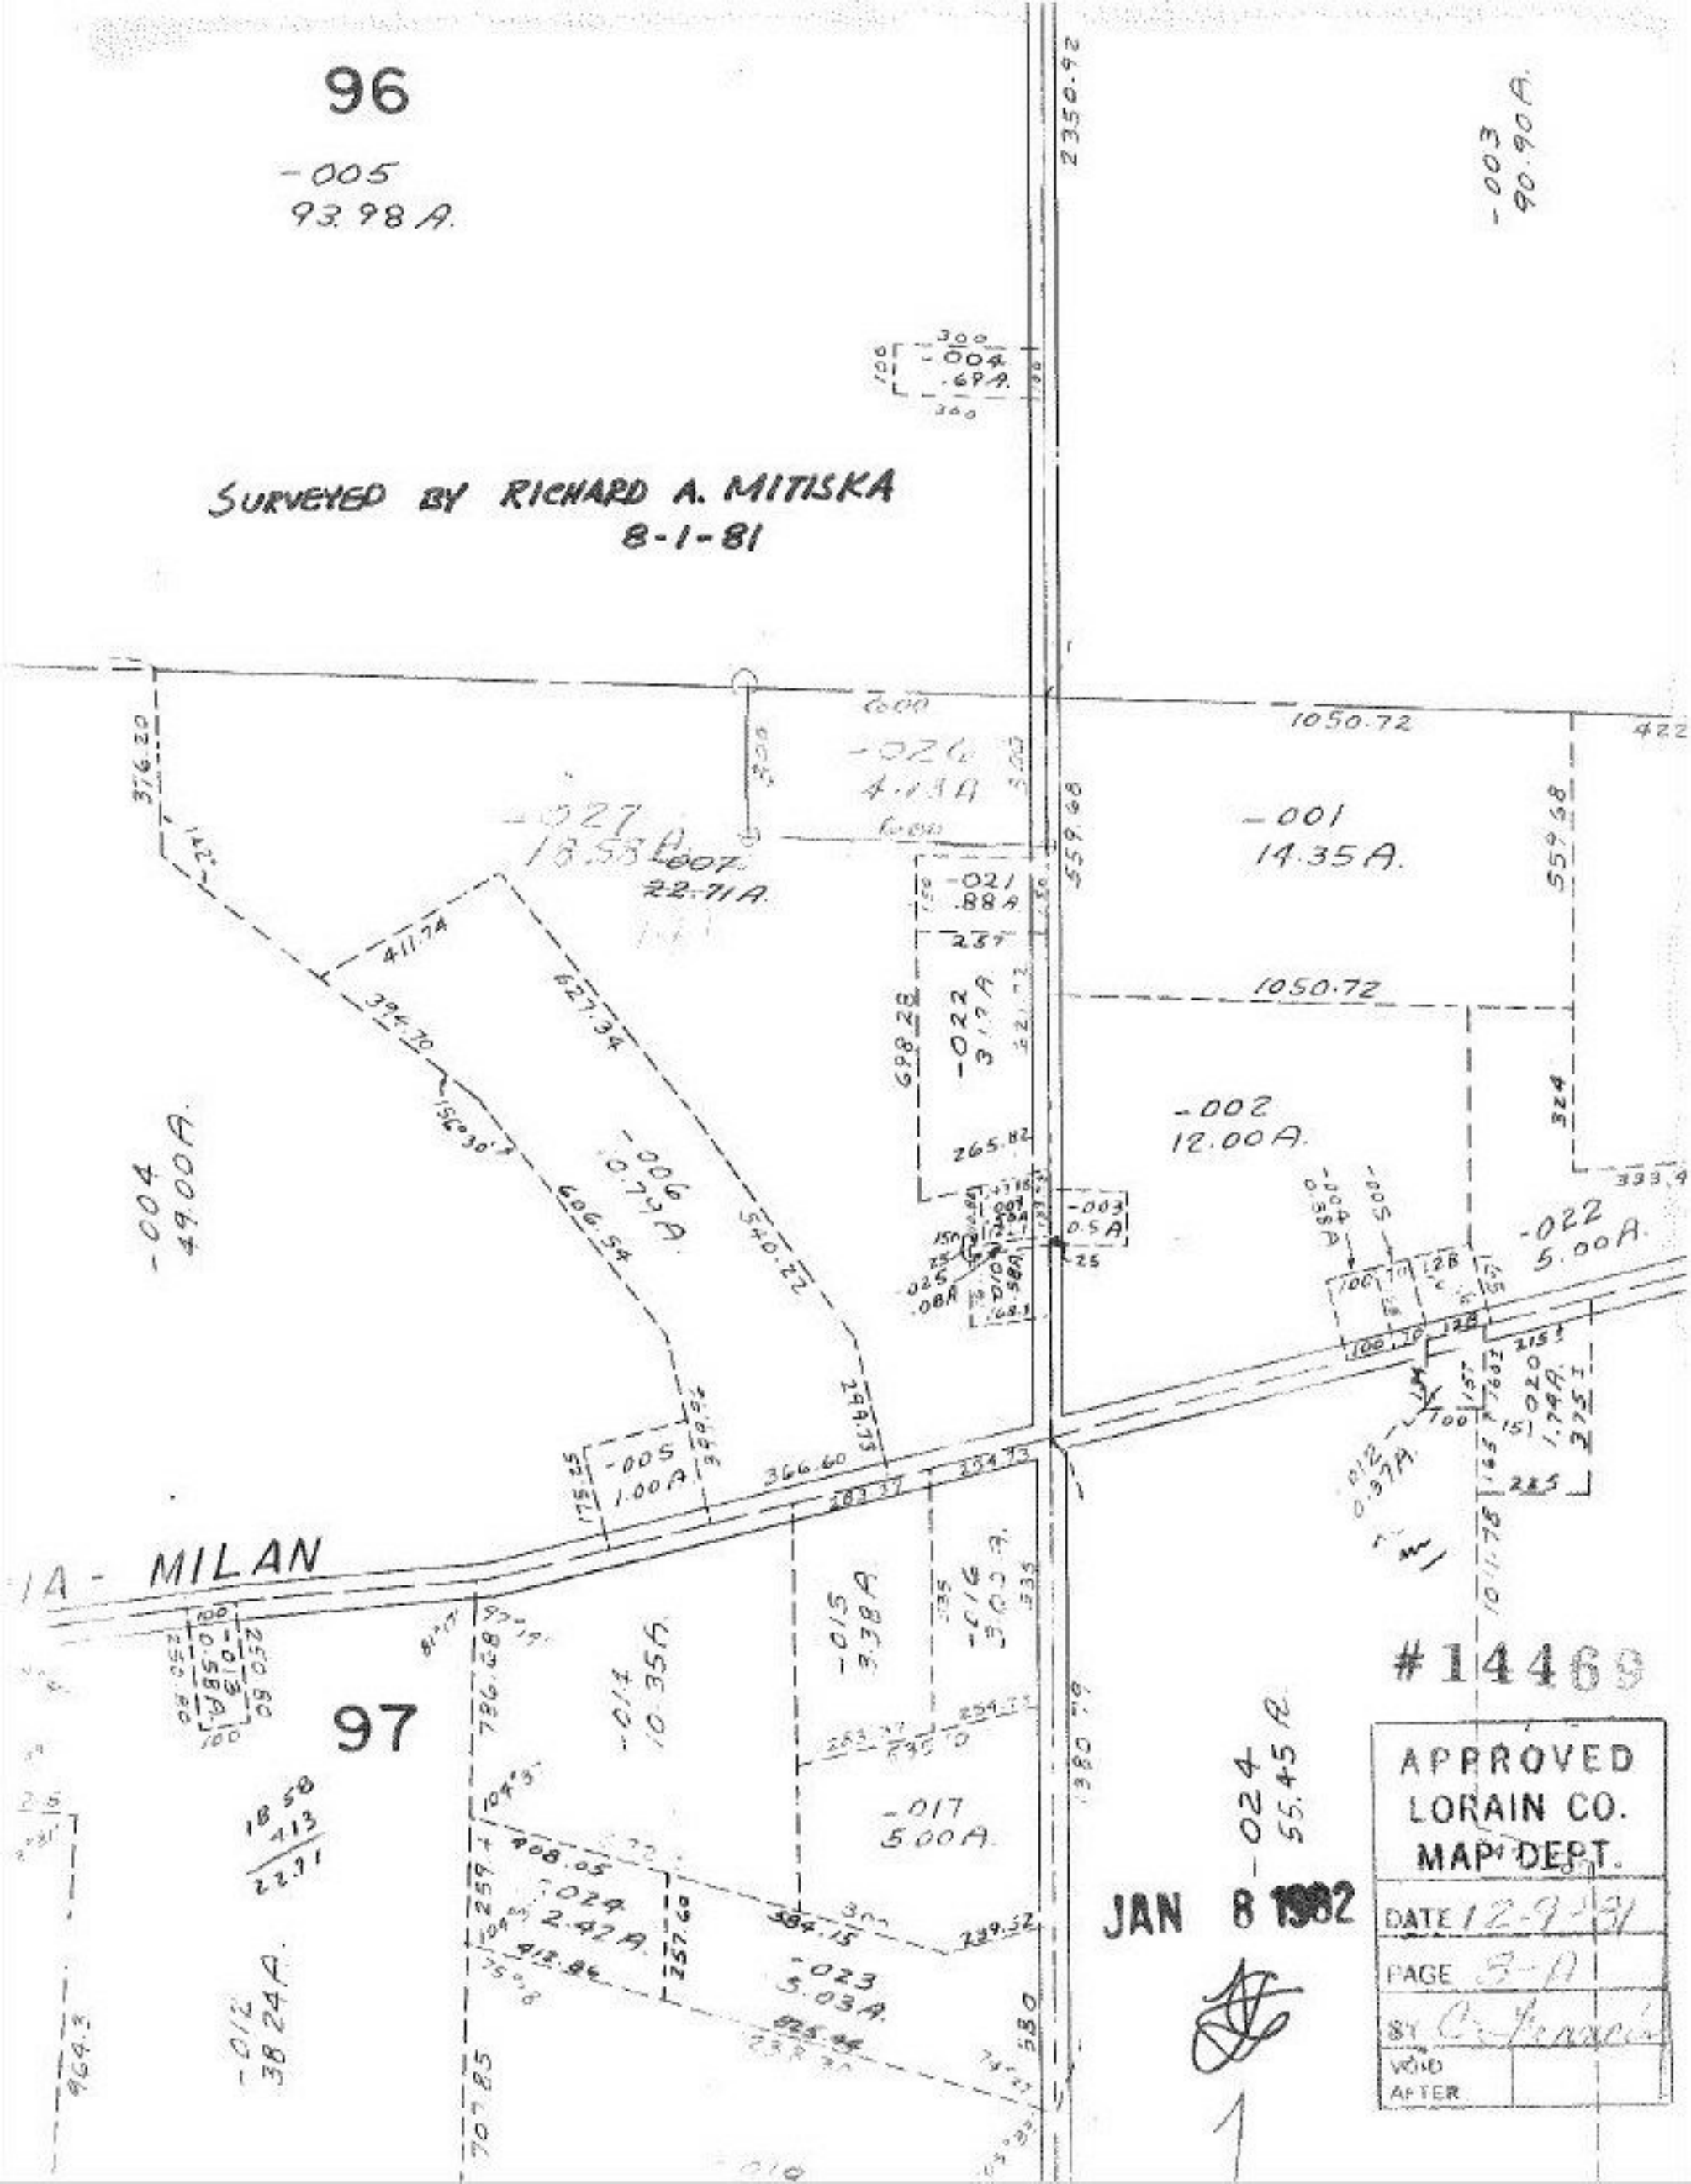
96
-005
93.98 A.
SURVEYED BY RICHARD A. MITISKA
8-1-81
-003
90.90 A.
-004
.69 A.
-026
4.13 A
-027
18.58 A
-007
22.71 A.
-001
14.35 A.
-021
.88 A
-022
3.17 A
-002
12.00 A.
-004
49.00 A.
-006
0.79 A.
-003
0.5 A
-022
5.00 A.
-005
1.00 A
-015
3.38 A
-014
10.35 A
-017
5.00 A.
-024
55.45 A
-024
2.42 A.
-023
5.03 A.
-012
38.24 A.
97
MILAN
#14469
APPROVED
LORAIN CO.
MAP DEPT.
DATE 12-9-81
PAGE 8-A
BY
VOID
AFTER
JAN 8 1982