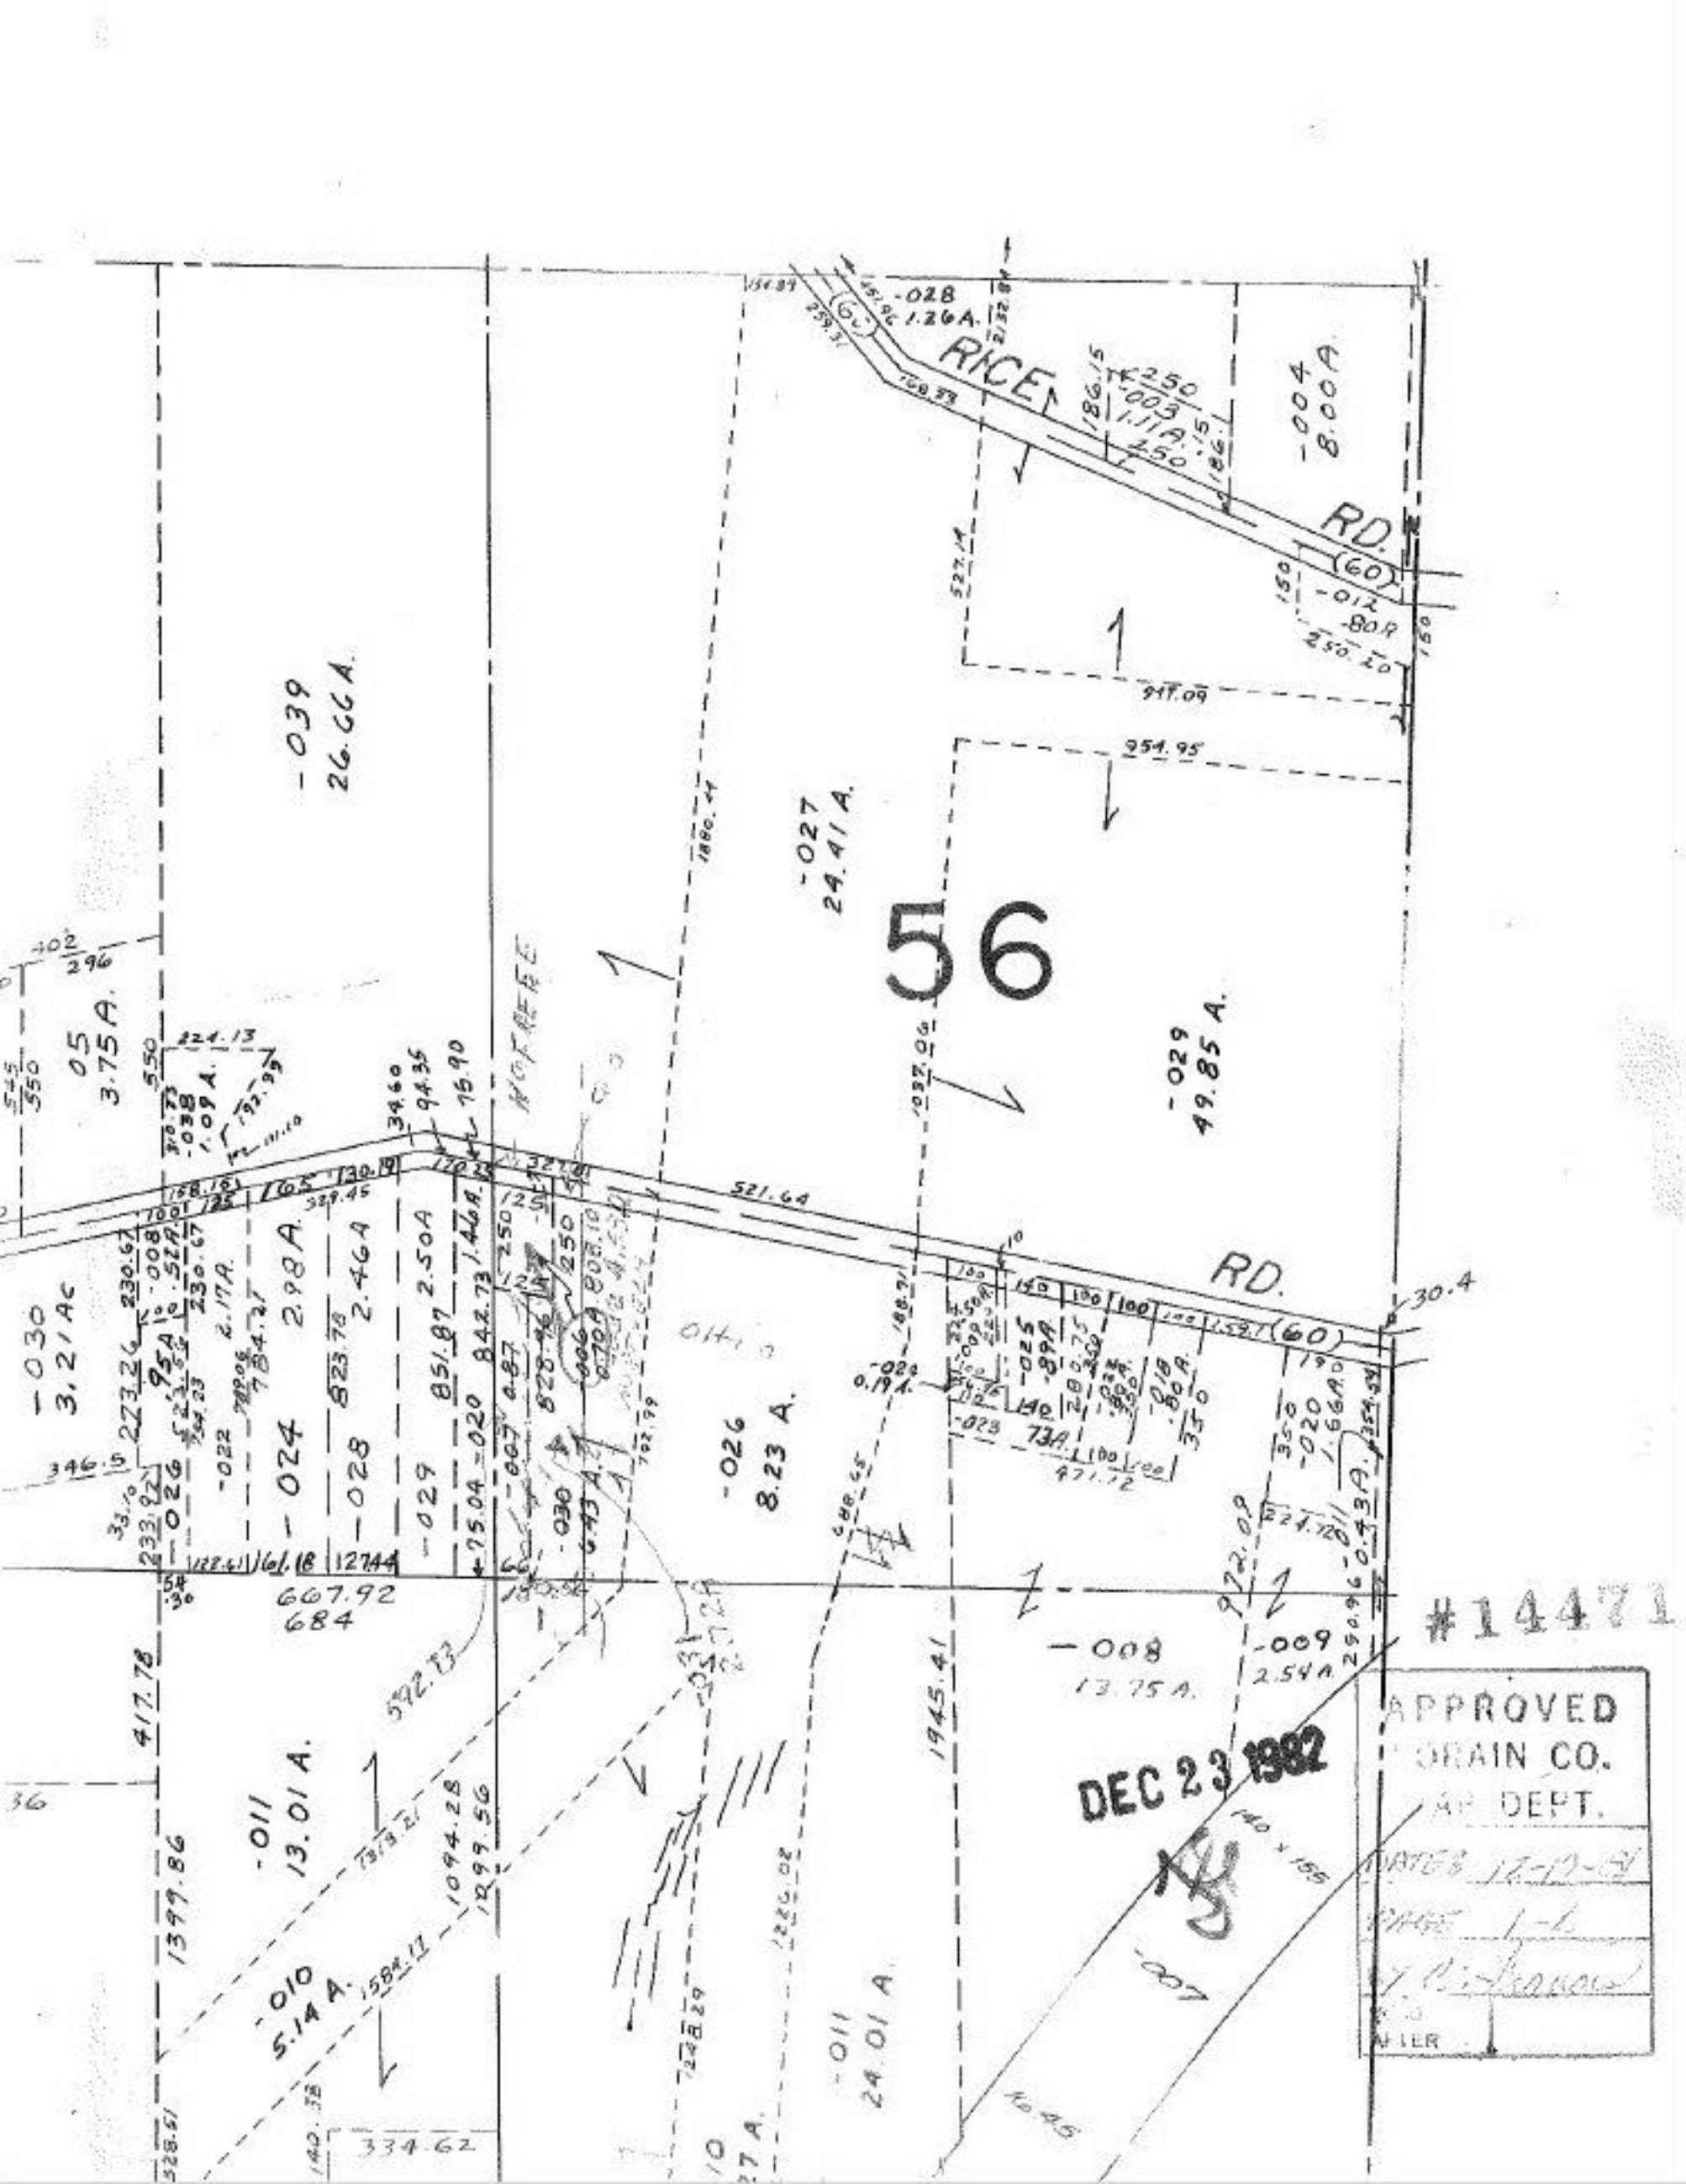
RICE
RD.
RD.
-039
26.66A.
-028
1.26A.
-004
8.00A.
-027
24.41A.
-029
49.85 A.
-030
3.21Ac
-024
2.98A.
-028
2.46A
-029
2.50A
-026
8.23 A.
-011
13.01 A.
-010
5.14 A.
-011
24.01 A.
-008
13.75 A.
-009
2.54A
APPROVED
DRAIN CO.
DEPT.
DATED 12-10-82
DEC 23 1982
#14471