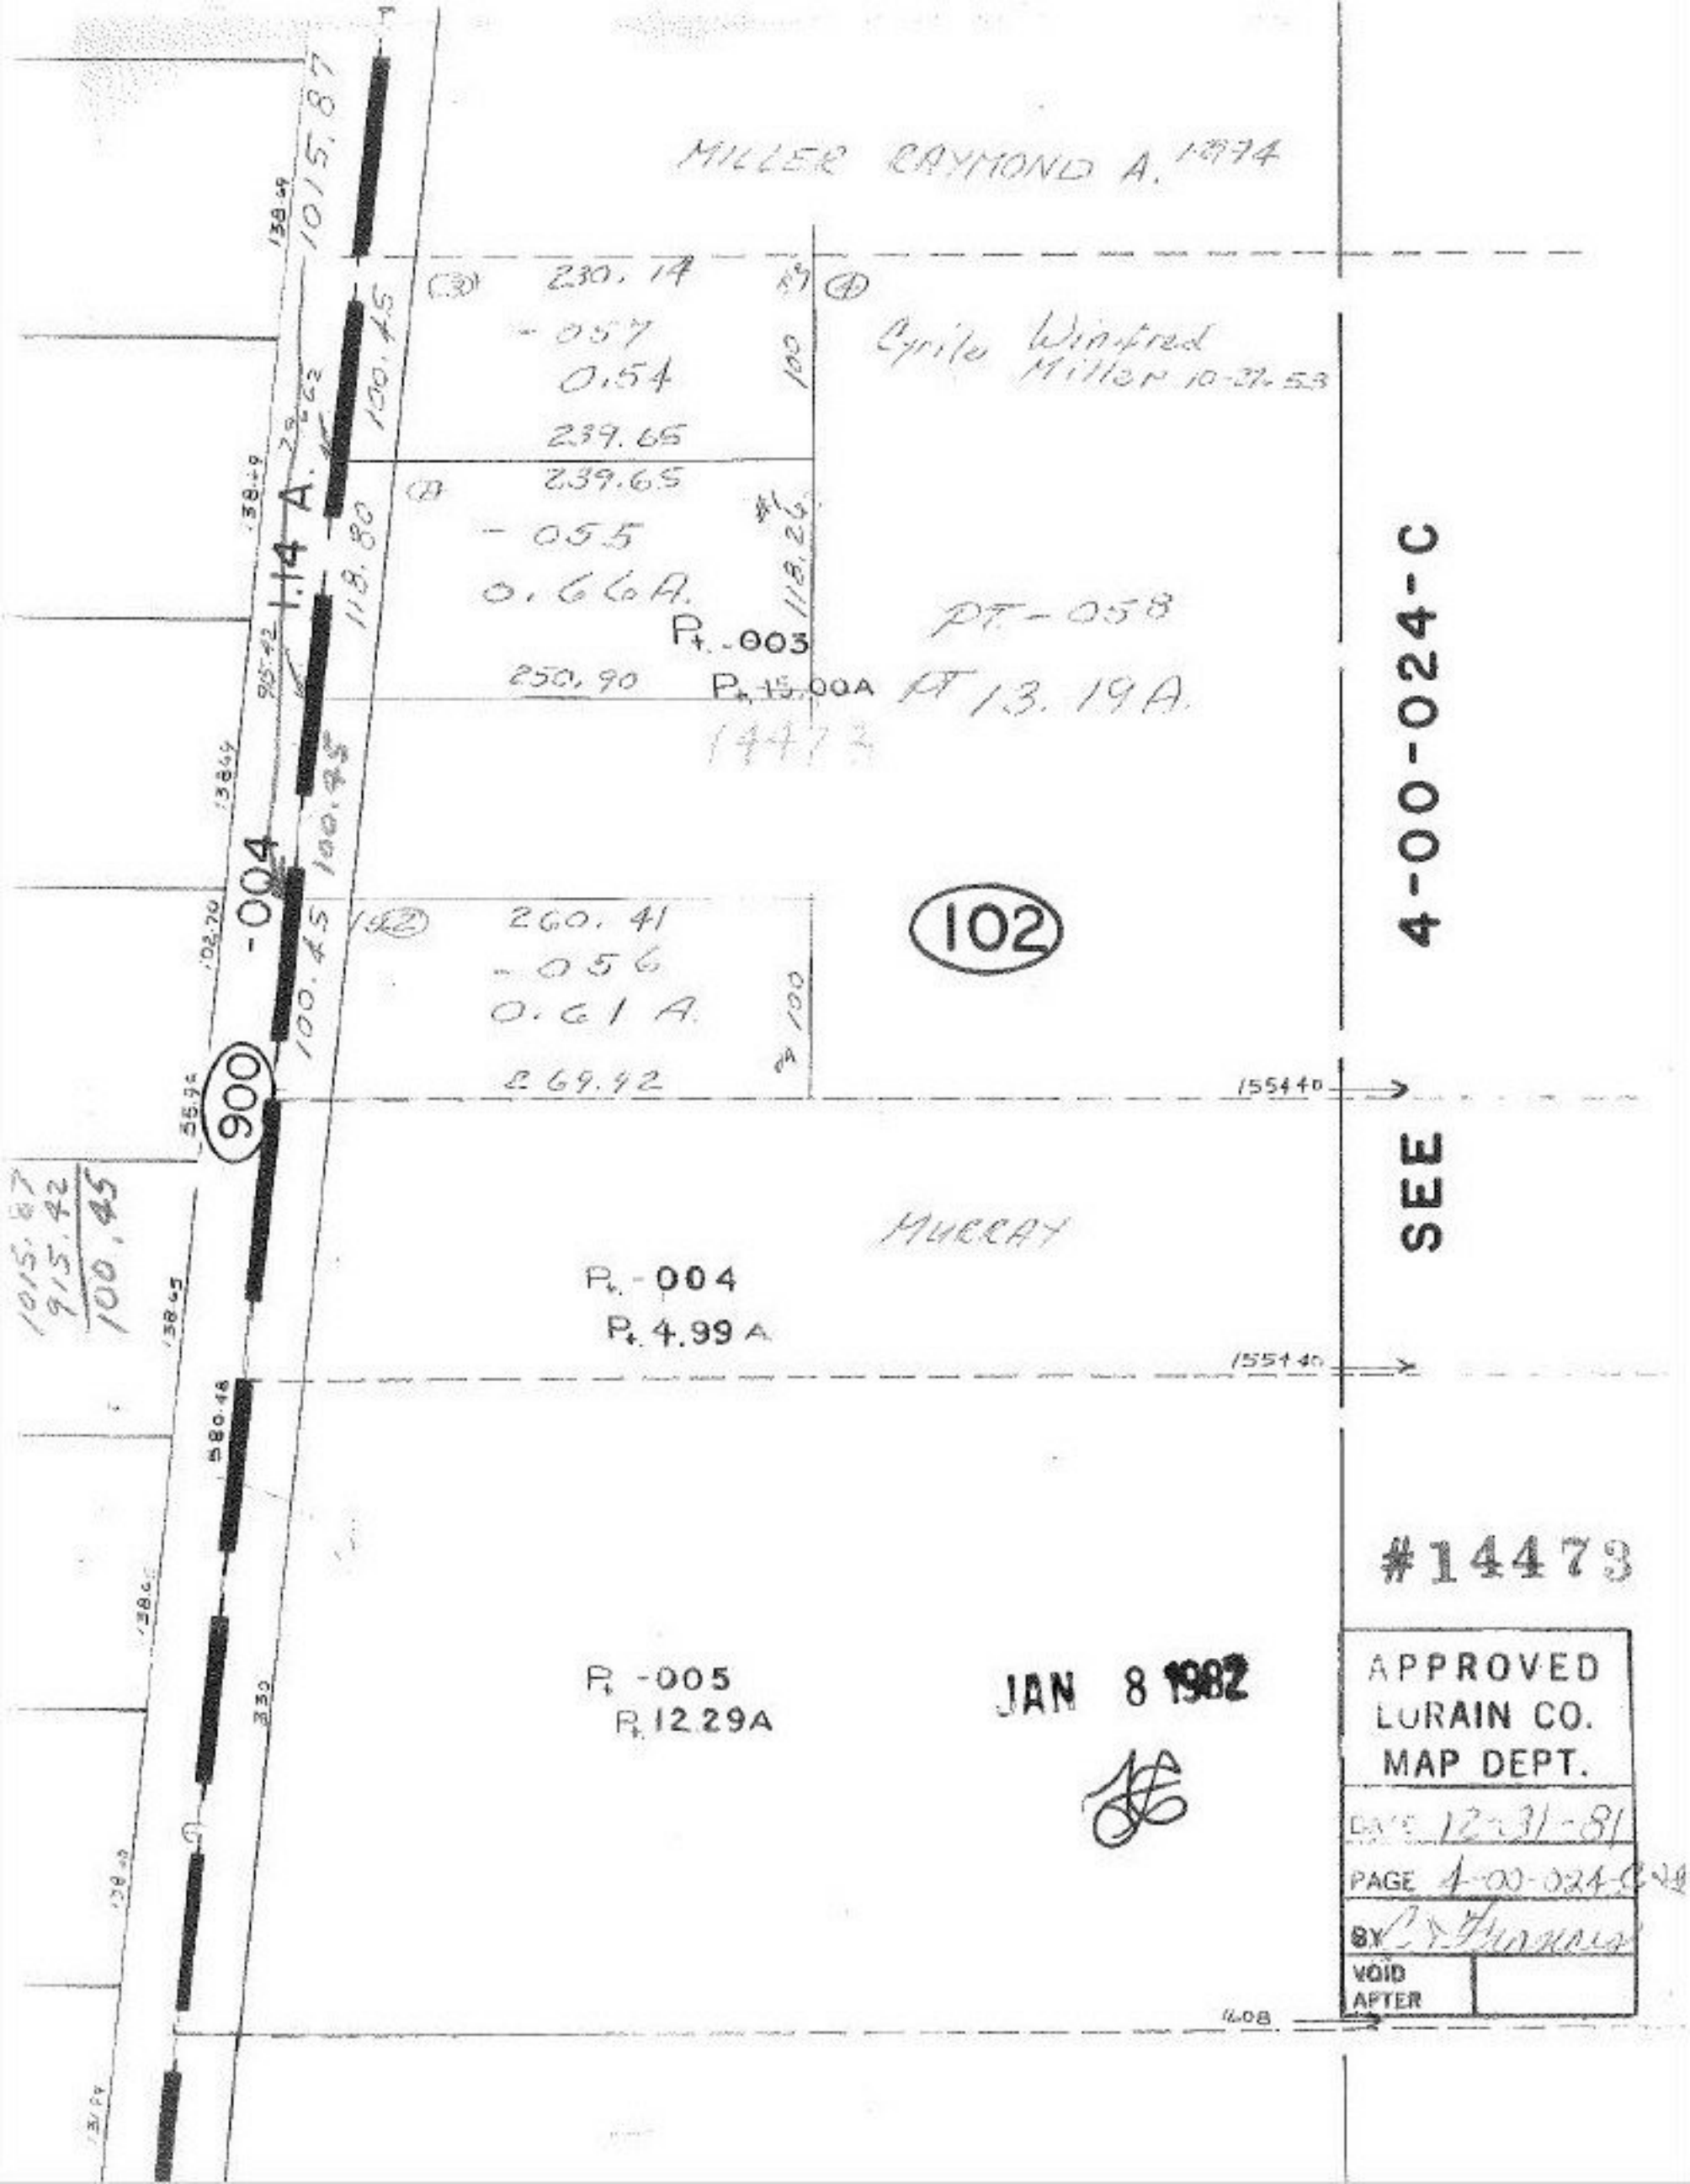
MILLER RAYMOND A. 1974
1015.87
138.49
230.14
-057
0.54
239.65
100
Cyrile Winifred Miller 10-27-53
100.45
1.14 A.
118.80
239.65
-055
0.66A.
118.26
Pt. -003
250.90
Pt. 15.00A
PT -058
PT 13.19A.
14473
-004
100.45
102
260.41
-056
0.61 A.
100
269.42
900
155440
SEE
4-00-024-C
MURRAY
Pt. -004
Pt. 4.99 A
1015.87
915.42
100.45
155440
580.48
#14473
Pt. -005
Pt. 12.29A
JAN 8 1982
APPROVED
LORAIN CO.
MAP DEPT.
DATE 12-31-81
PAGE 4-00-024-C
BY
VOID
AFTER
1608