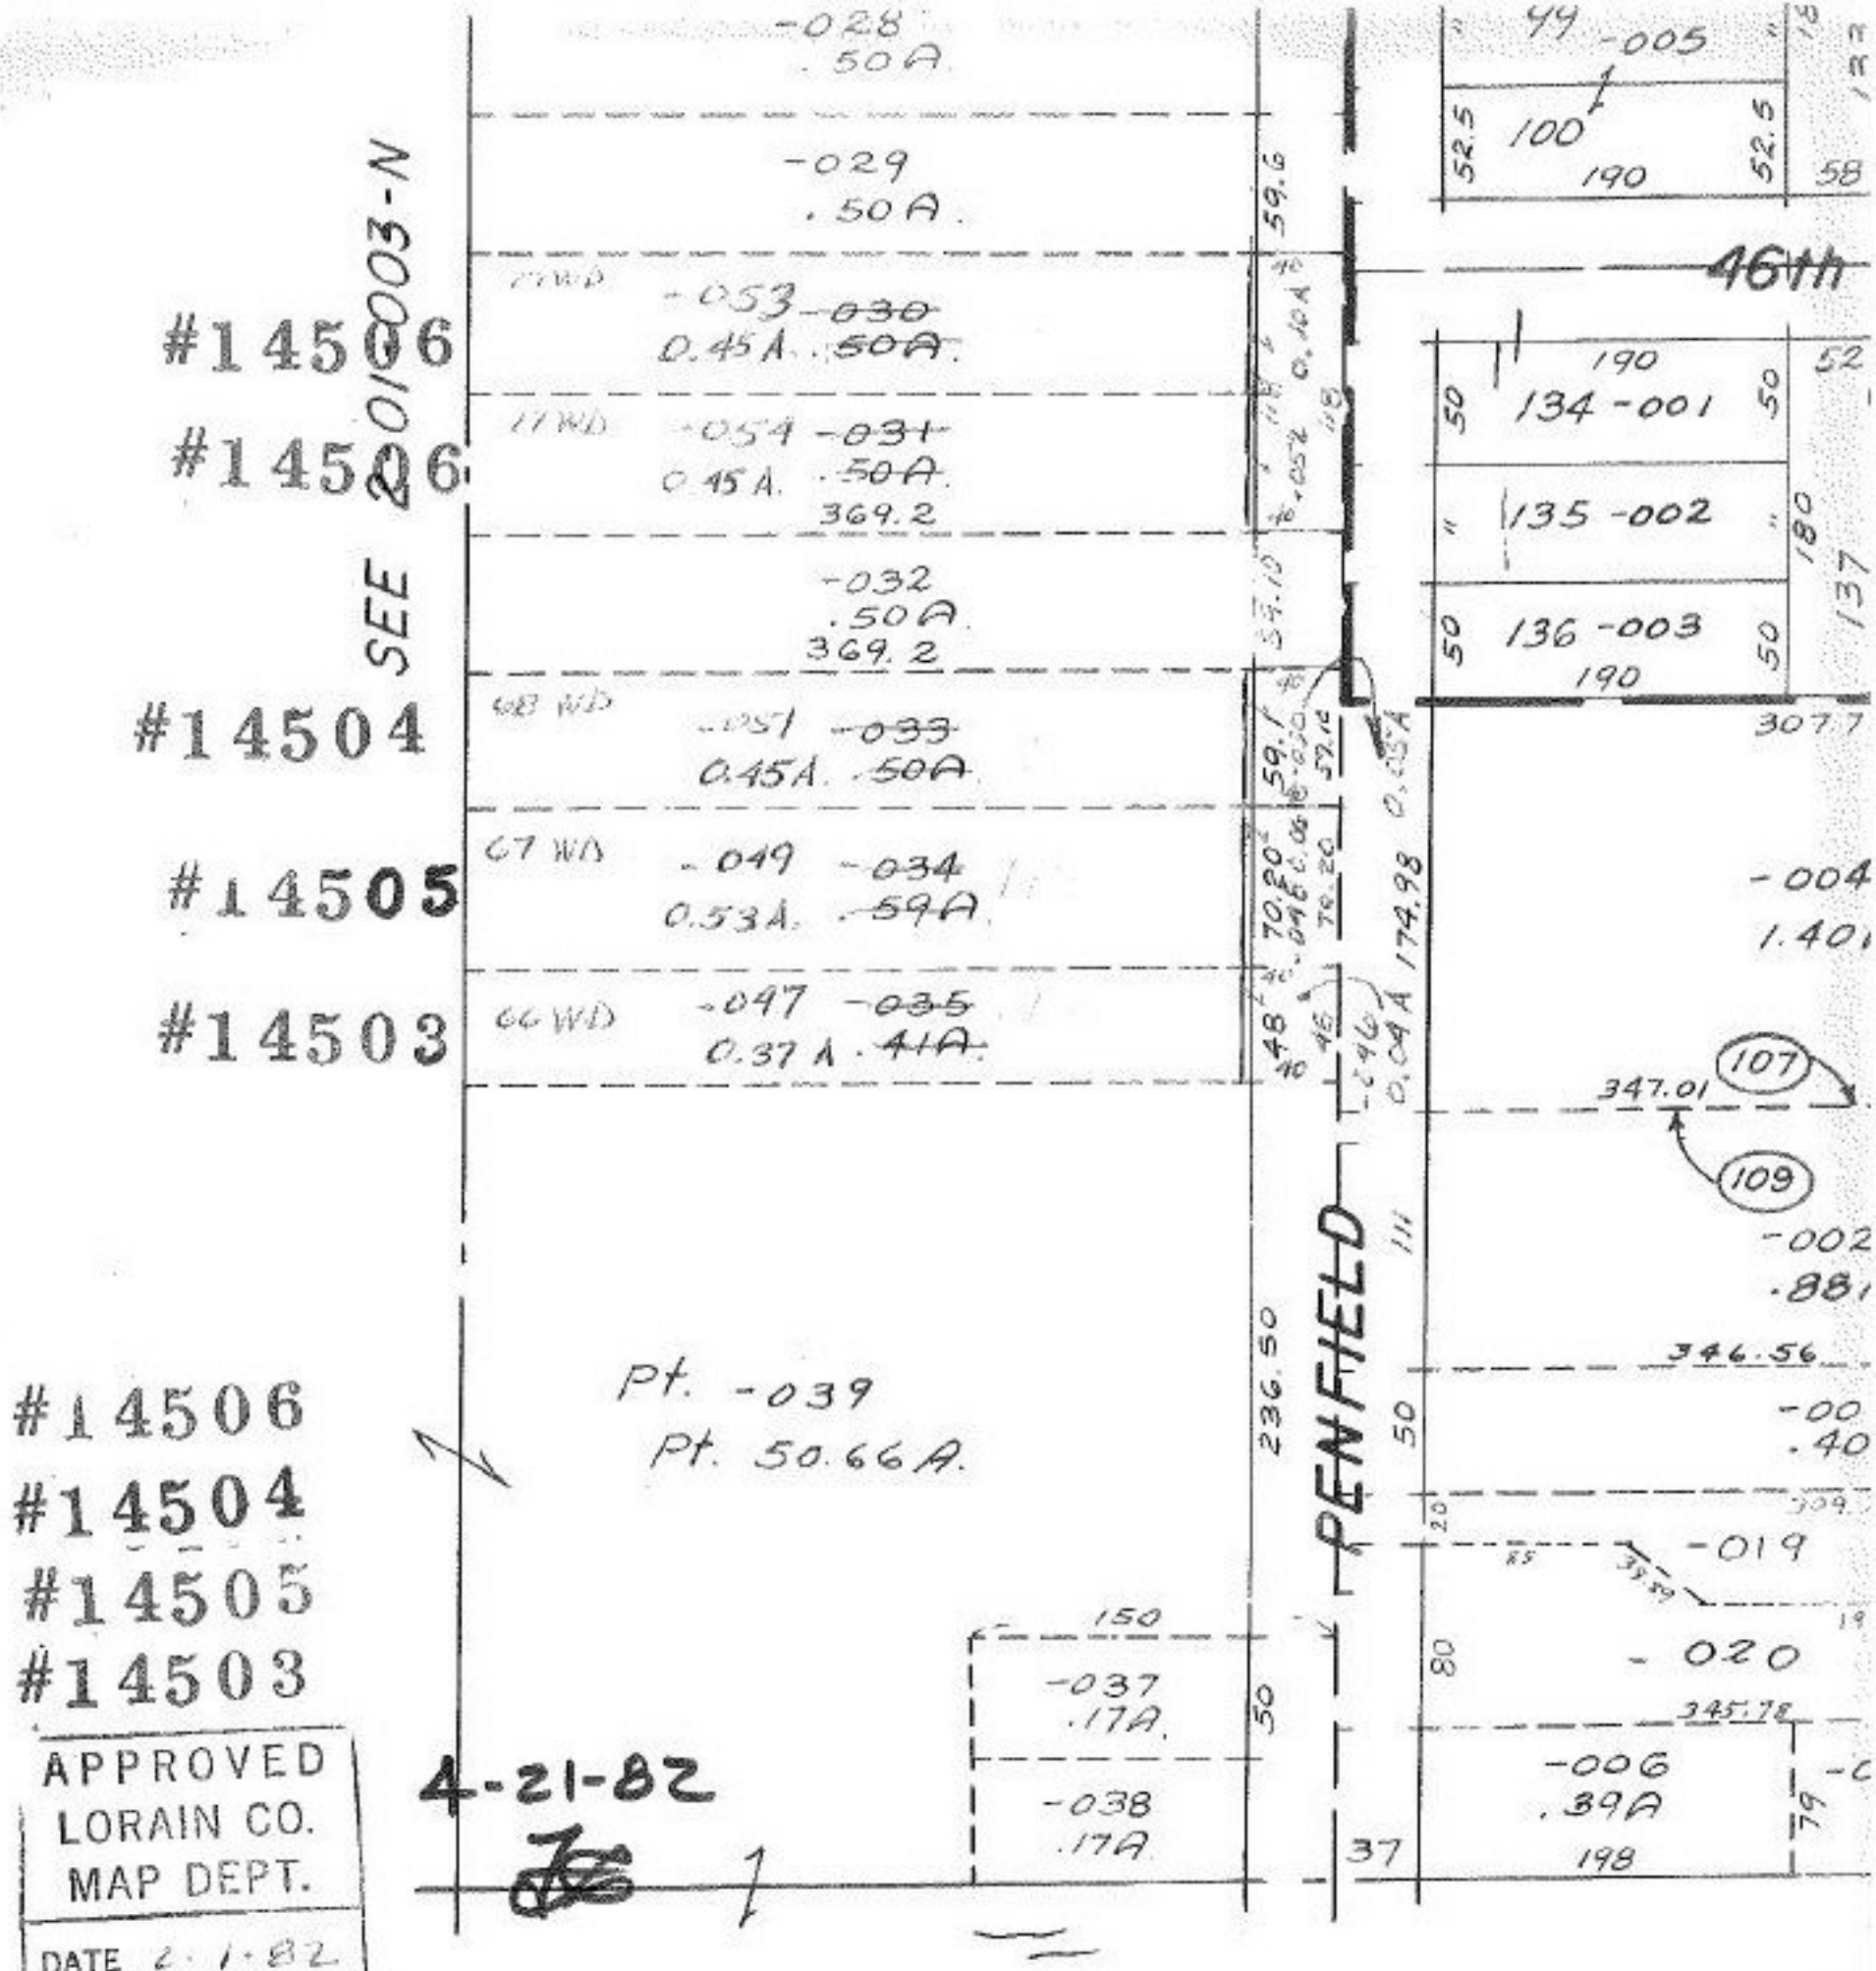

APPROVED
LORAIN CO.
MAP DEPT.
DATE 2-1-82
PAGE 3 00-108-A
BY T. McNair
VOID AFTER

Copyright 1964

3-00-108-A

SHEFFIEL

SCALE: 1" = 100'