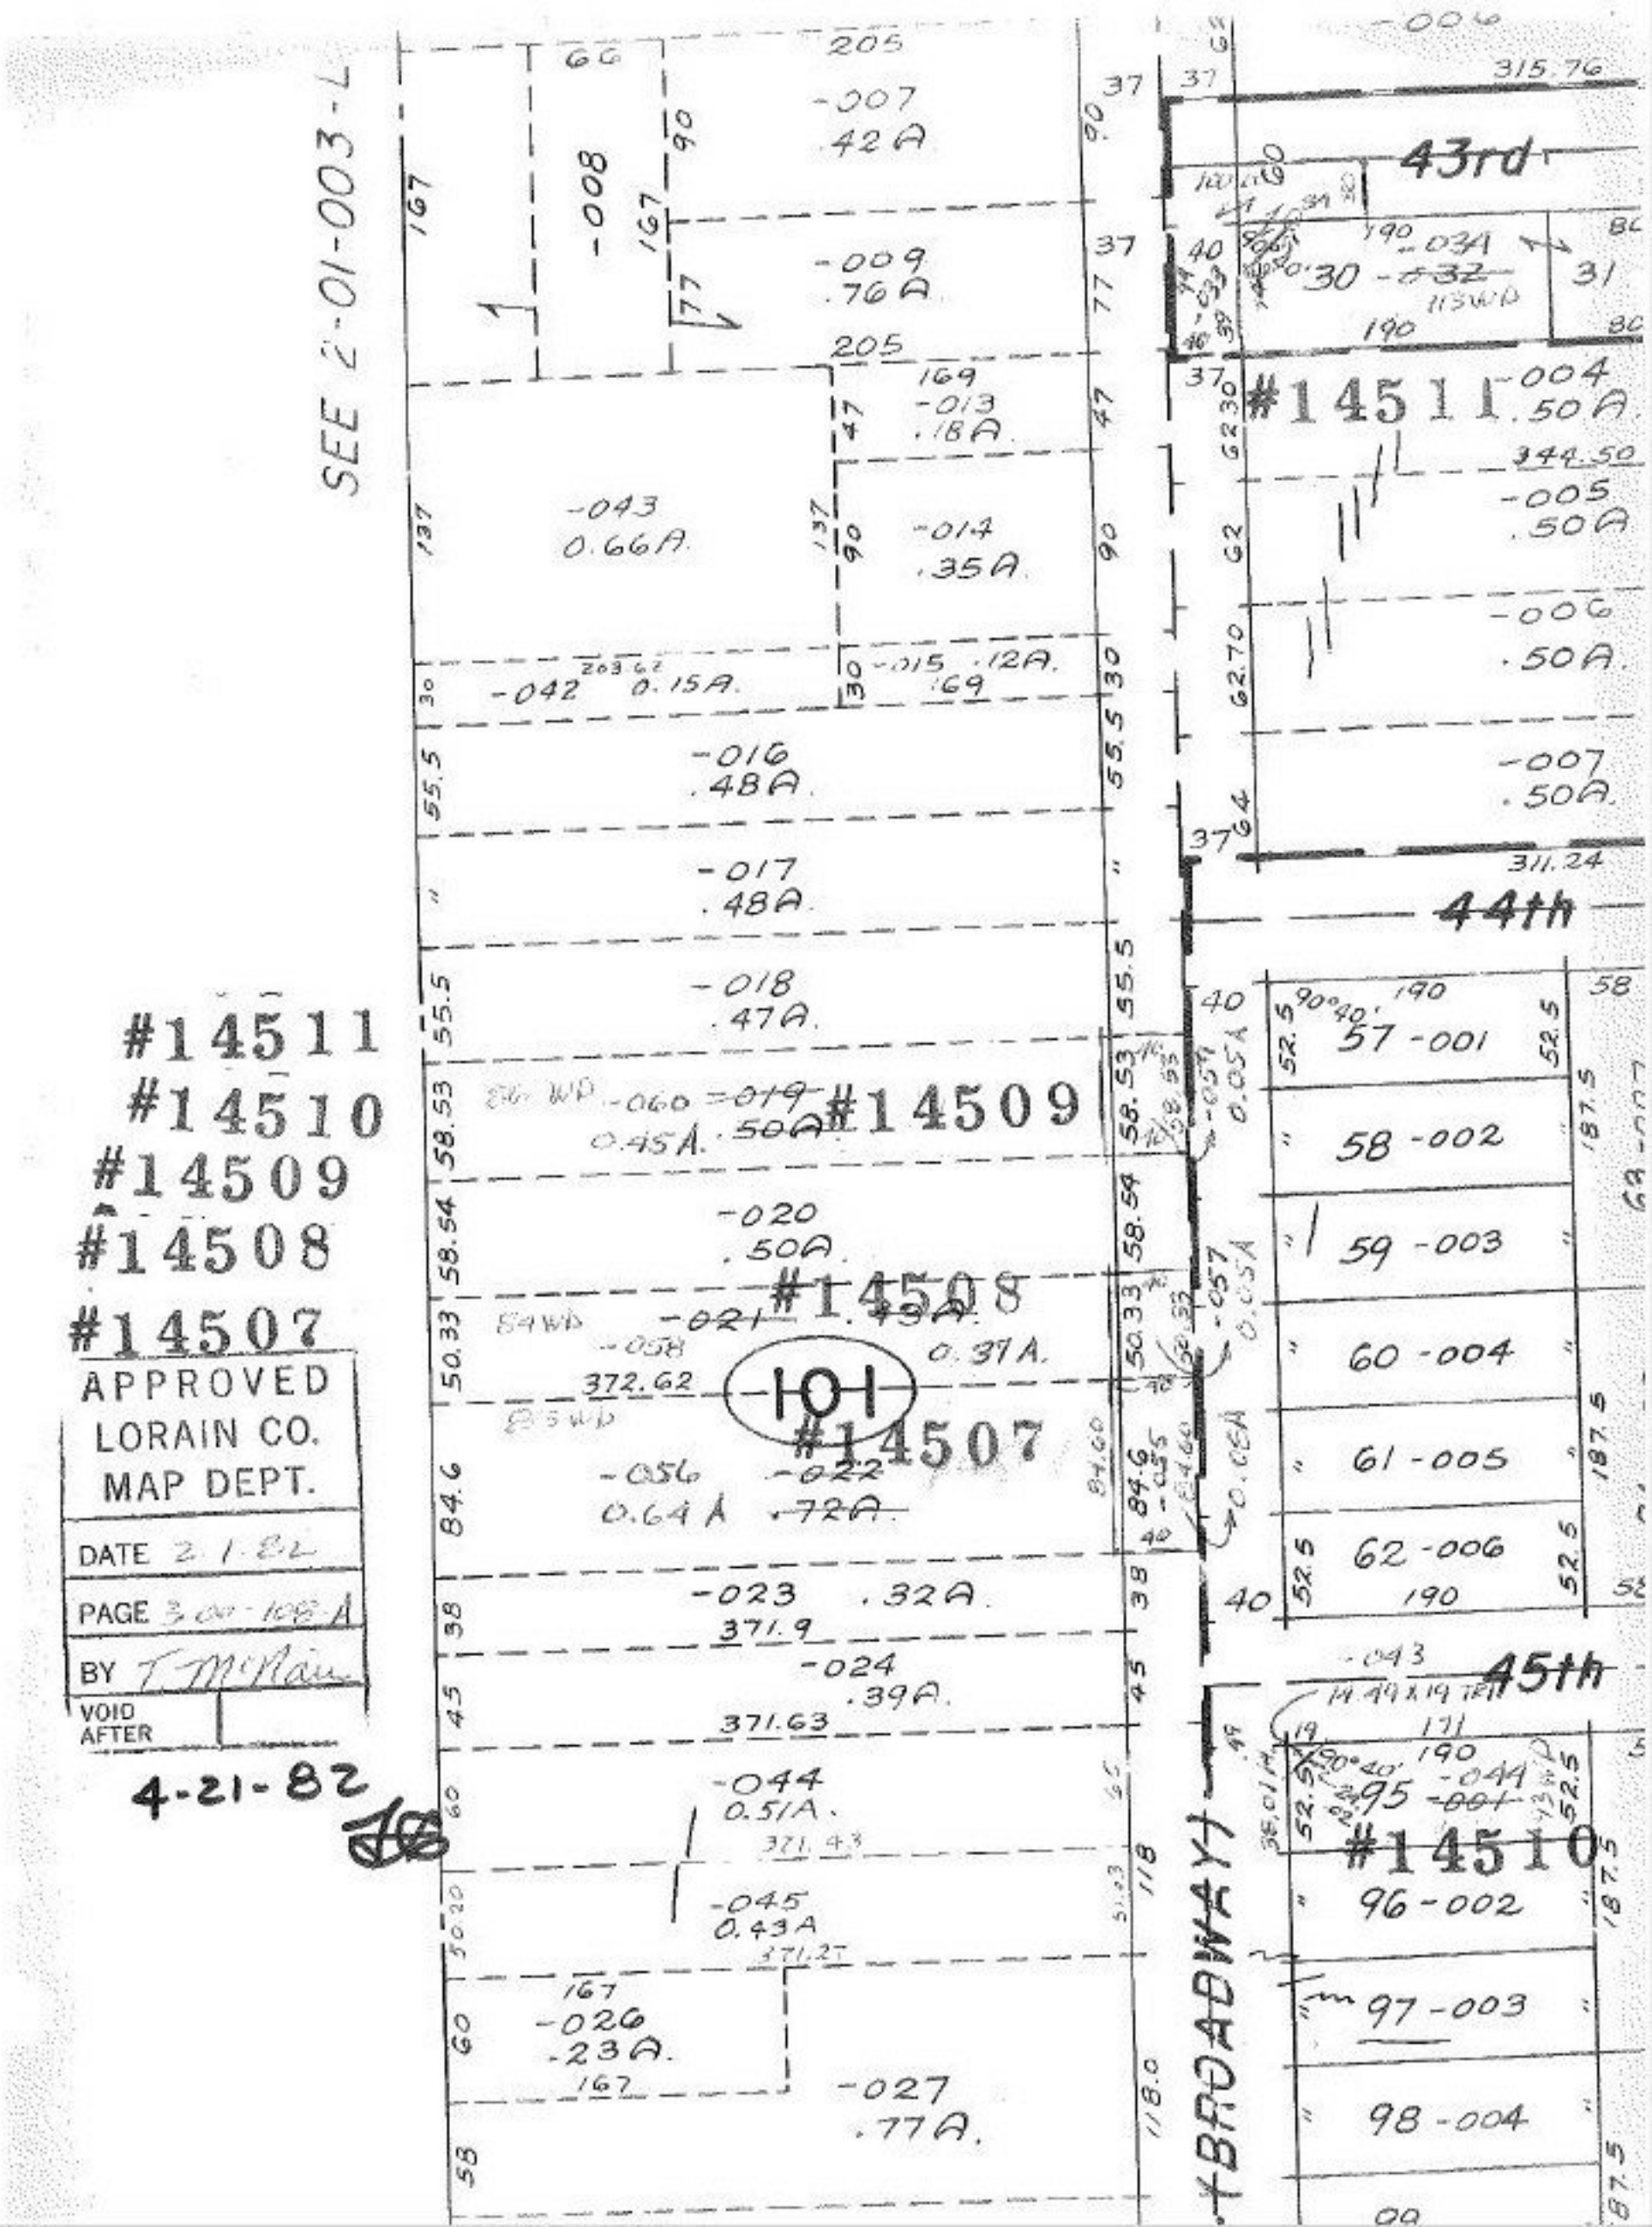

SEE 2-01-003-L
#14511
#14510
#14509
#14508
#14507
APPROVED
LORAIN CO.
MAP DEPT.
DATE 2-1-82
PAGE 3-00-108-A
BY T. McNair
VOID AFTER
4-21-82
101
43rd
44th
45th
BROADWAY
#14511
#14509
#14508
#14507
#14510
-007 .42A
-008
-009 .76A
-013 .18A
-043 0.66A
-014 .35A
-042 0.15A
-015 .12A
-016 .48A
-017 .48A
-018 .47A
-060 -019 0.45A .50A
-020 .50A
-021 .43A 0.37A
-058 372.62
-056 -022 0.64A .72A
-023 .32A 371.9
-024 .39A 371.63
-044 0.51A 371.43
-045 0.43A 371.27
-026 .23A
-027 .77A
-004 .50A
-005 .50A
-006 .50A
-007 .50A
57-001
58-002
59-003
60-004
61-005
62-006
96-002
97-003
98-004