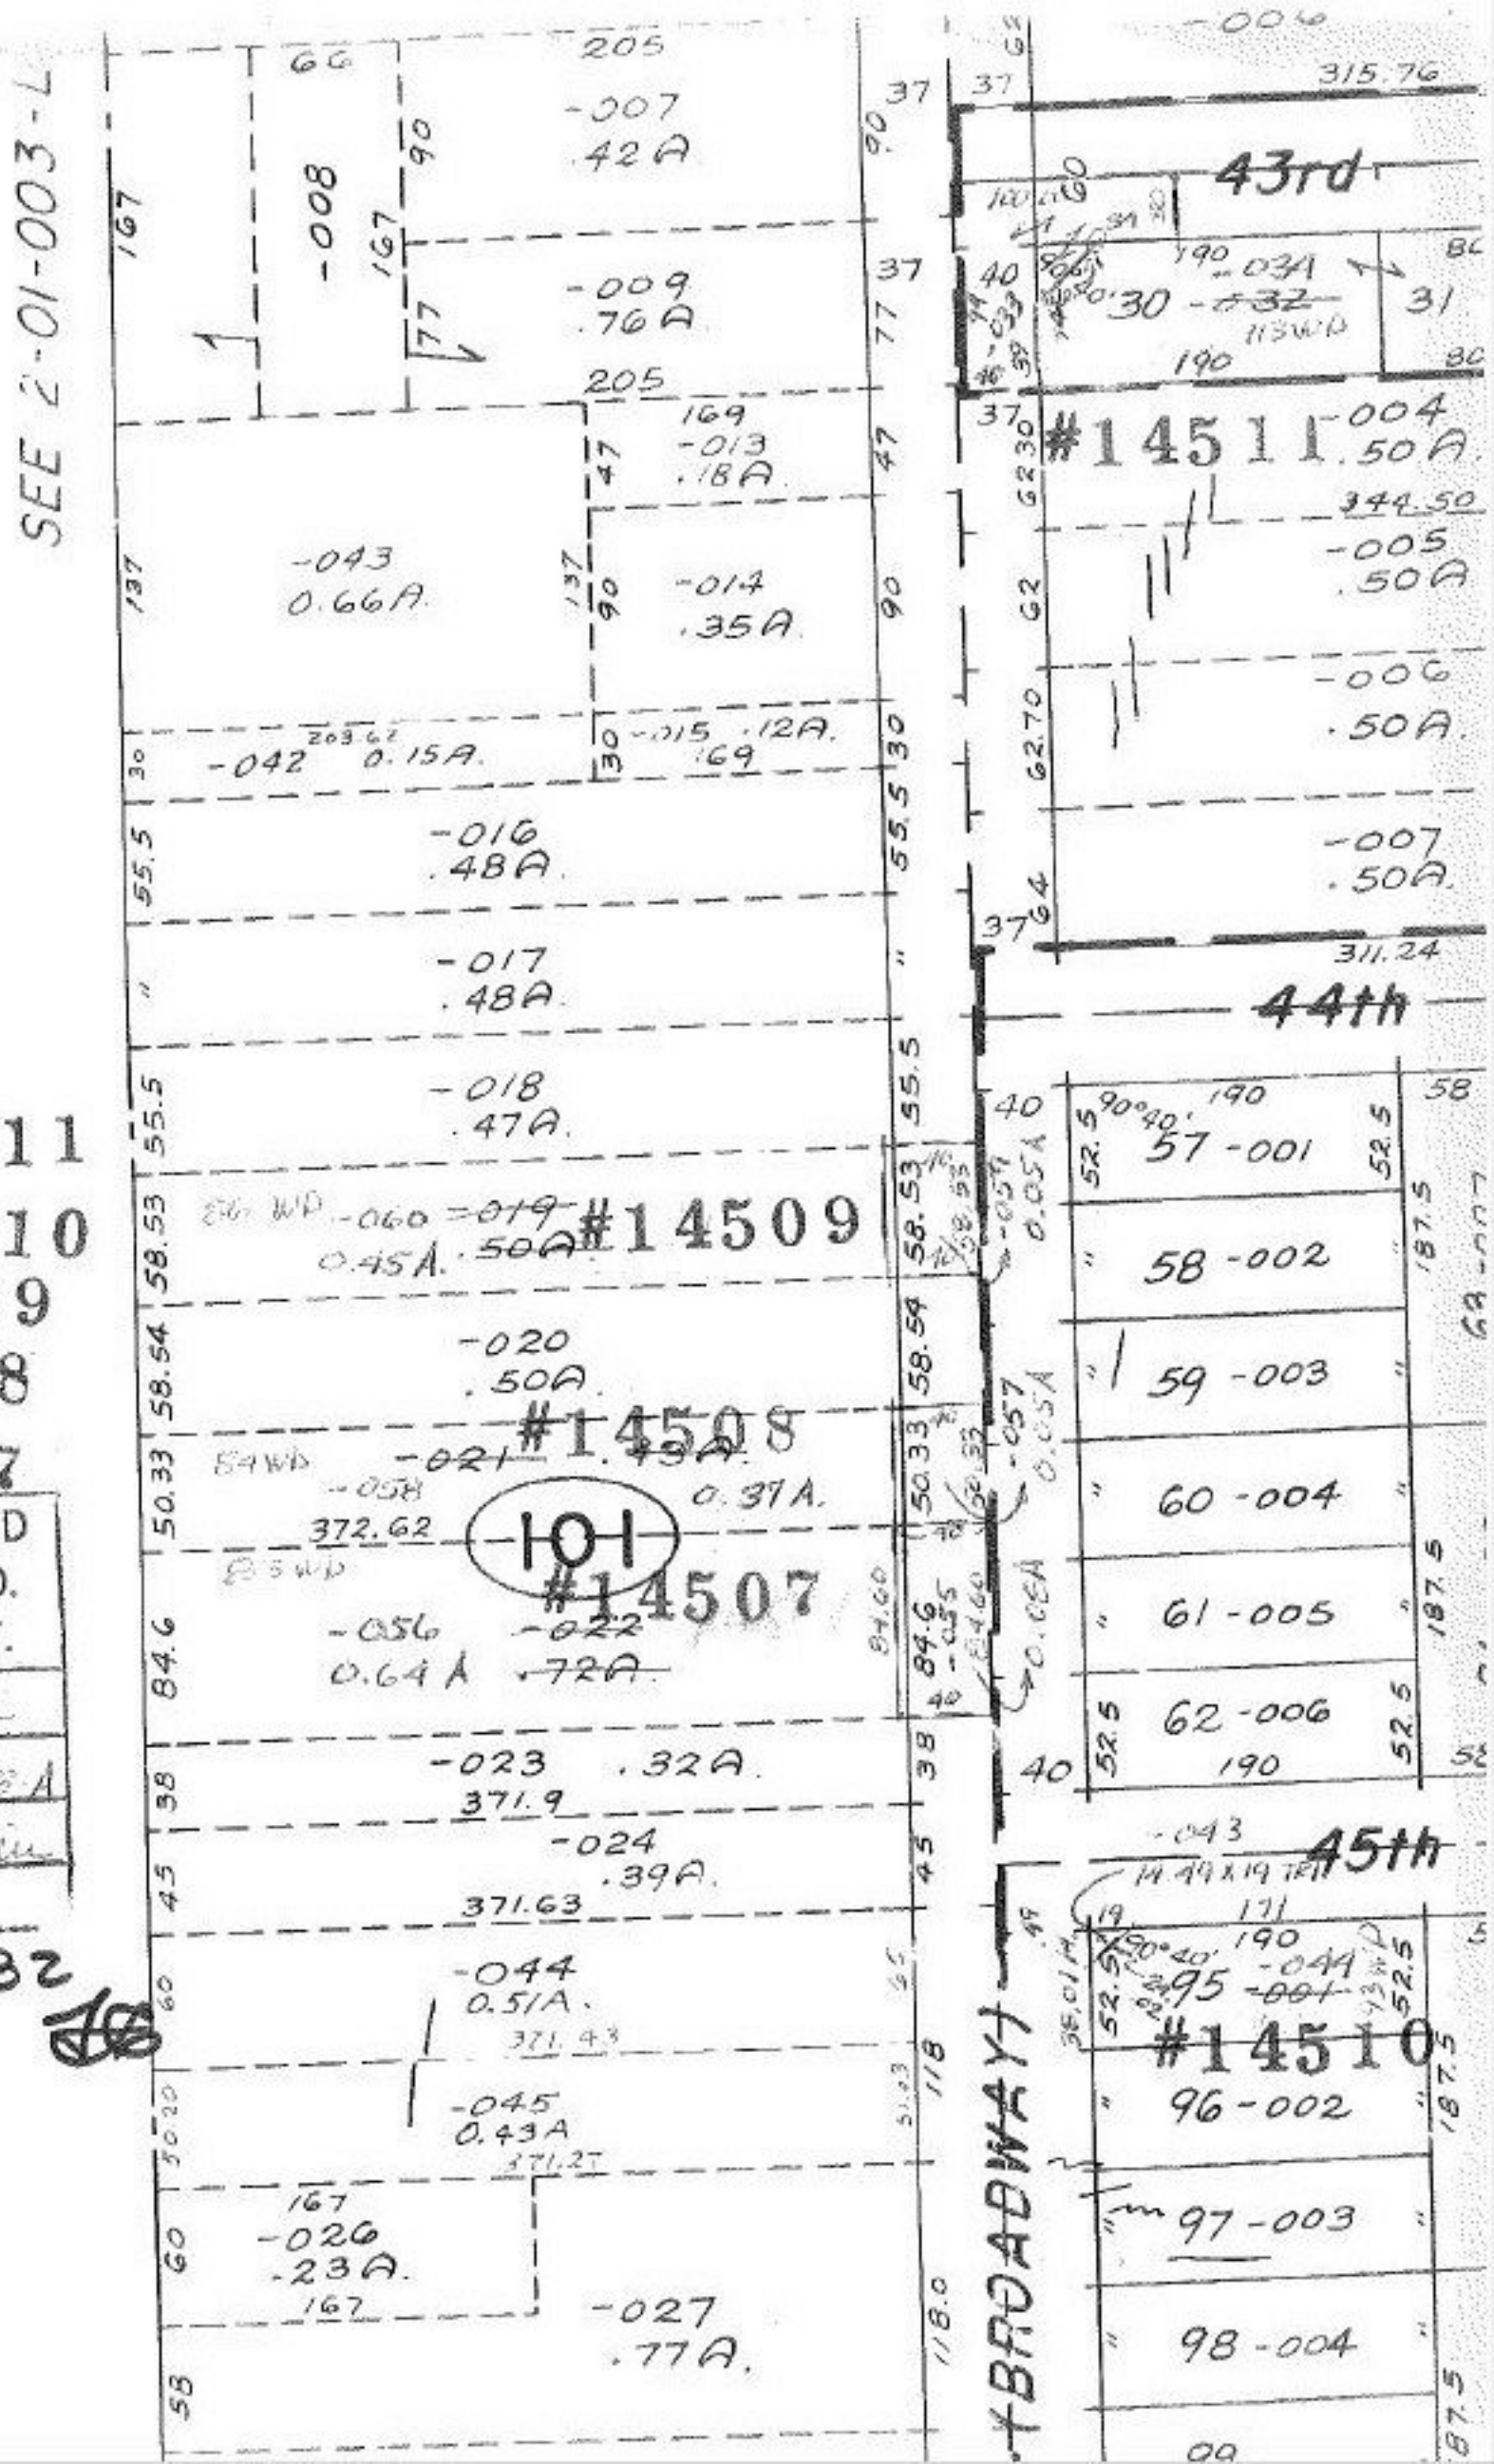

APPROVED
LORAIN CO.
MAP DEPT.

DATE 2-1-82

PAGE 3-00-108-A

BY T. McNair

VOID AFTER

4-21-82