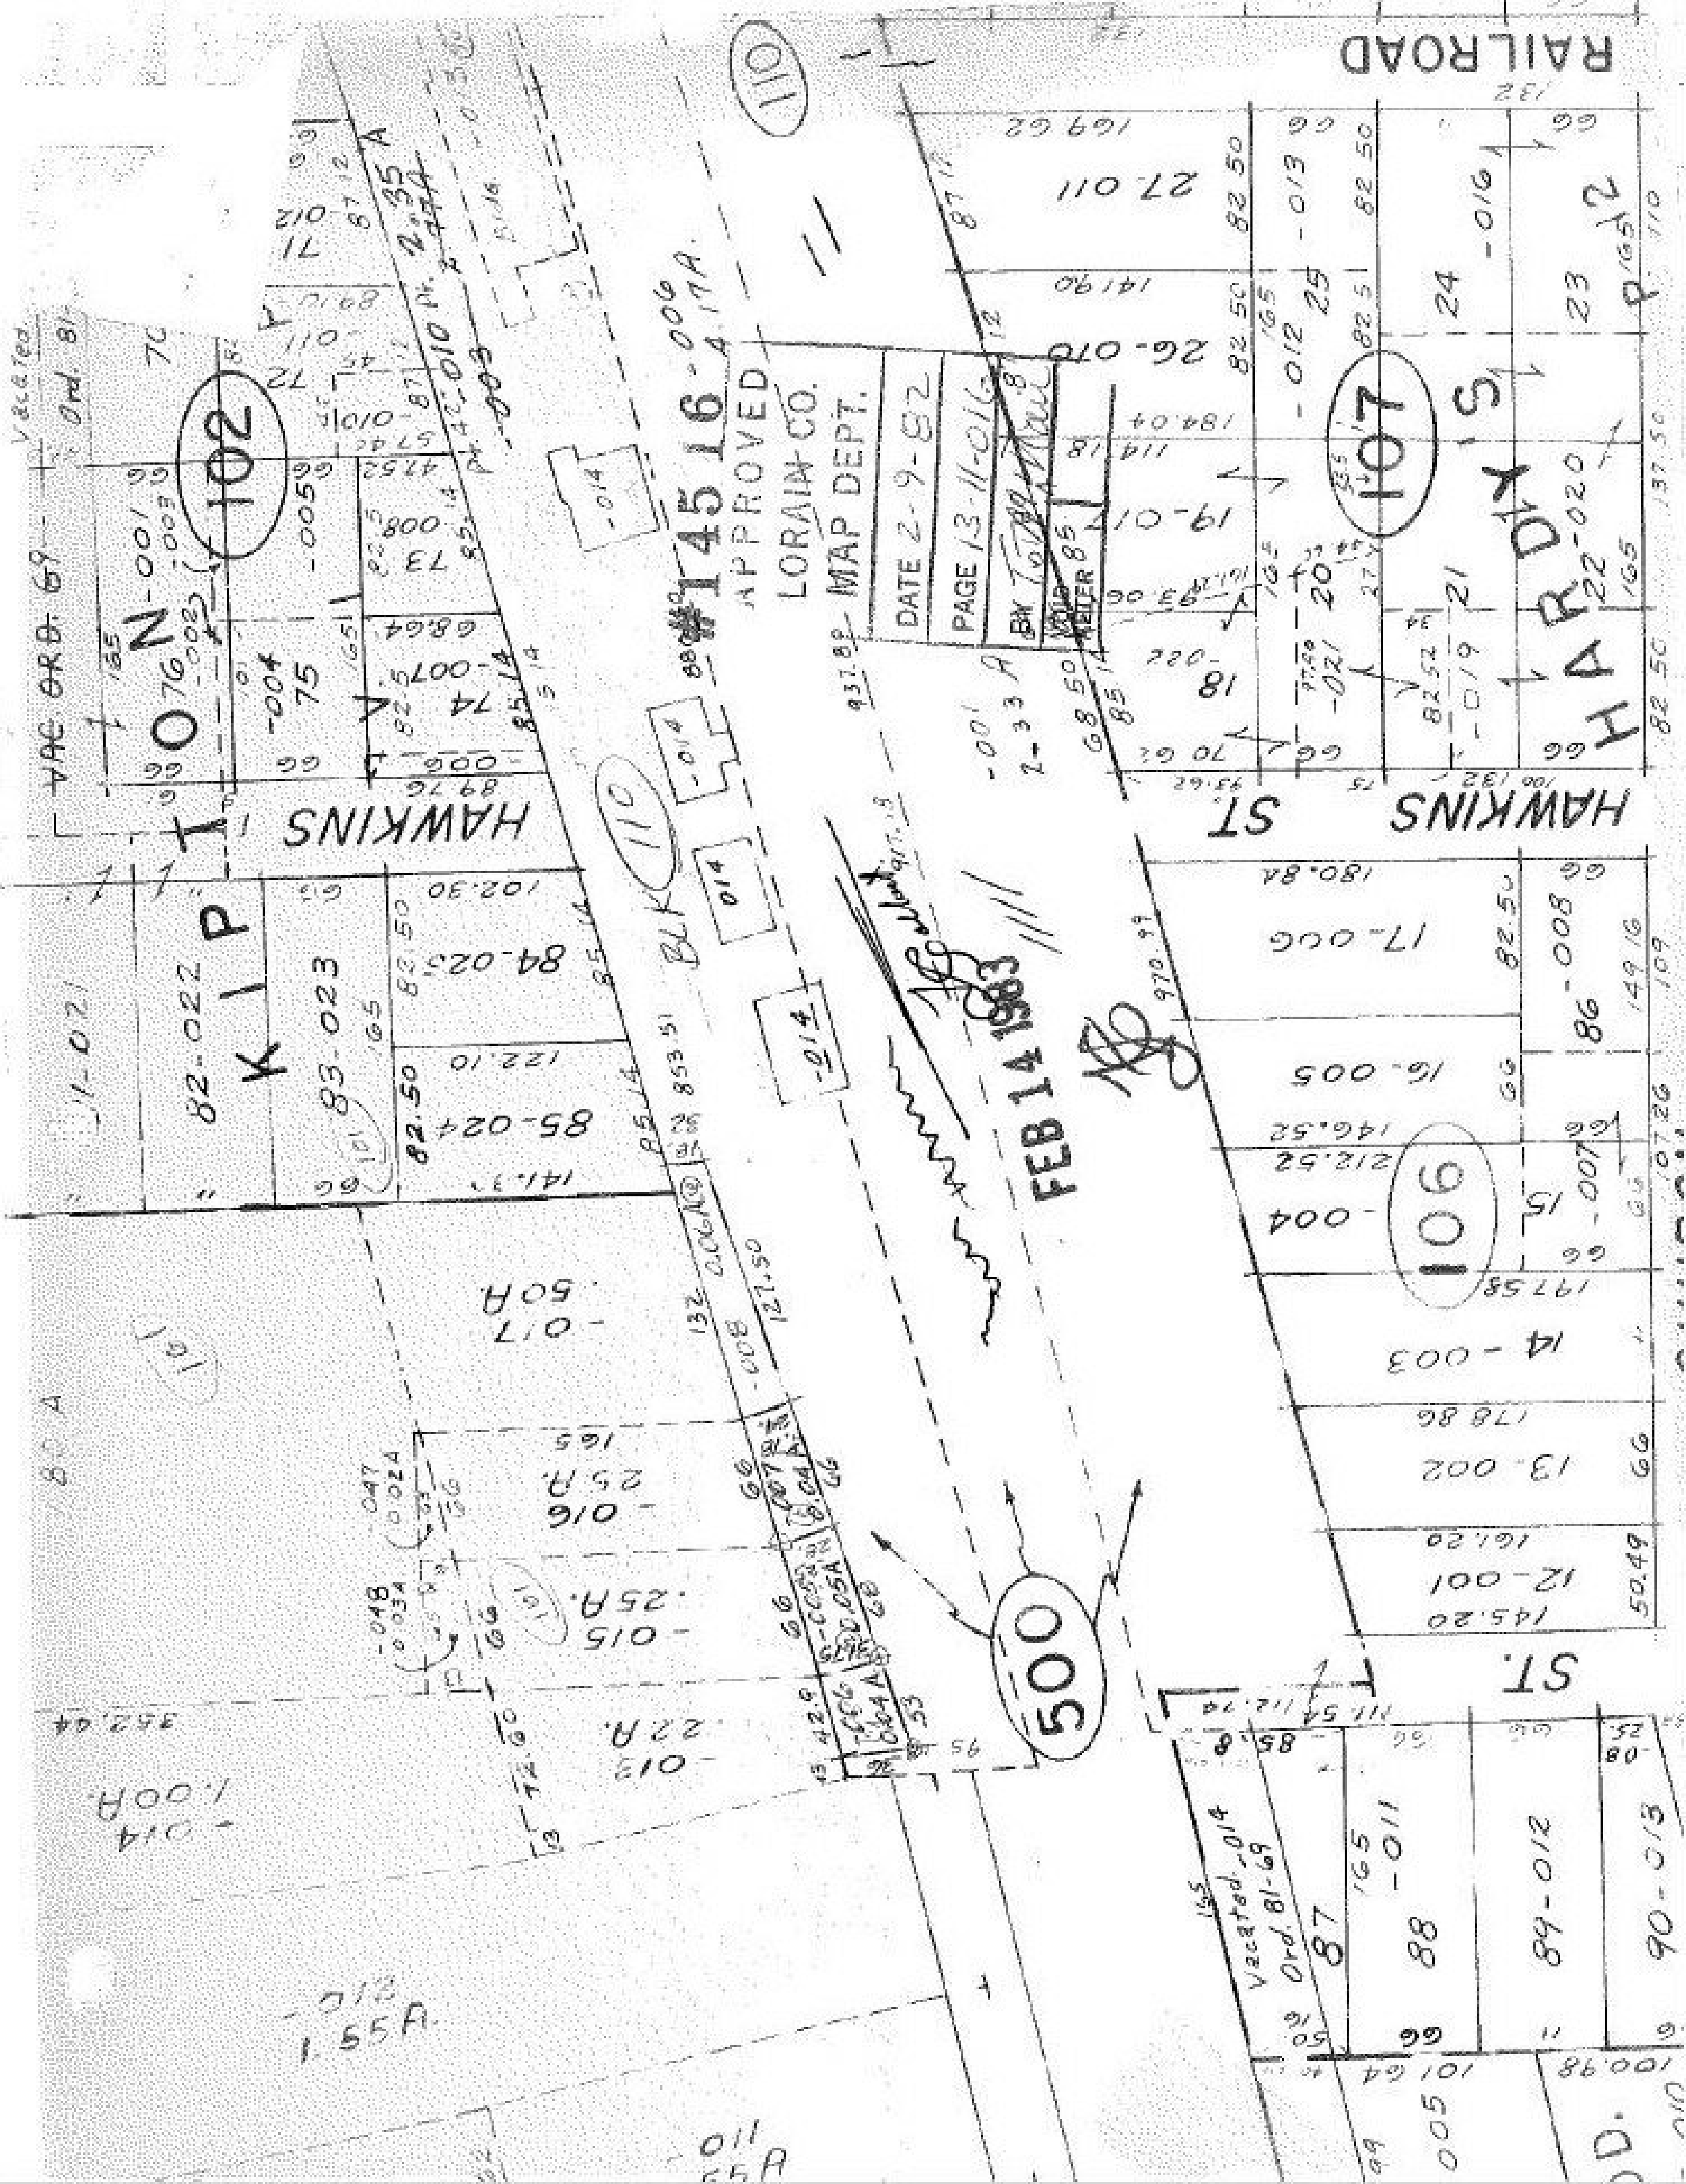
RAILROAD
HAWKINS ST
HAWKINS
KIPTON
HARDY S
ST.
#14516
APPROVED
LORAIN CO.
MAP DEPT.
DATE 2-9-82
PAGE 13-11-016
FEB 14 1983
102
107
106
110
500
Vacated Ord. 81-69