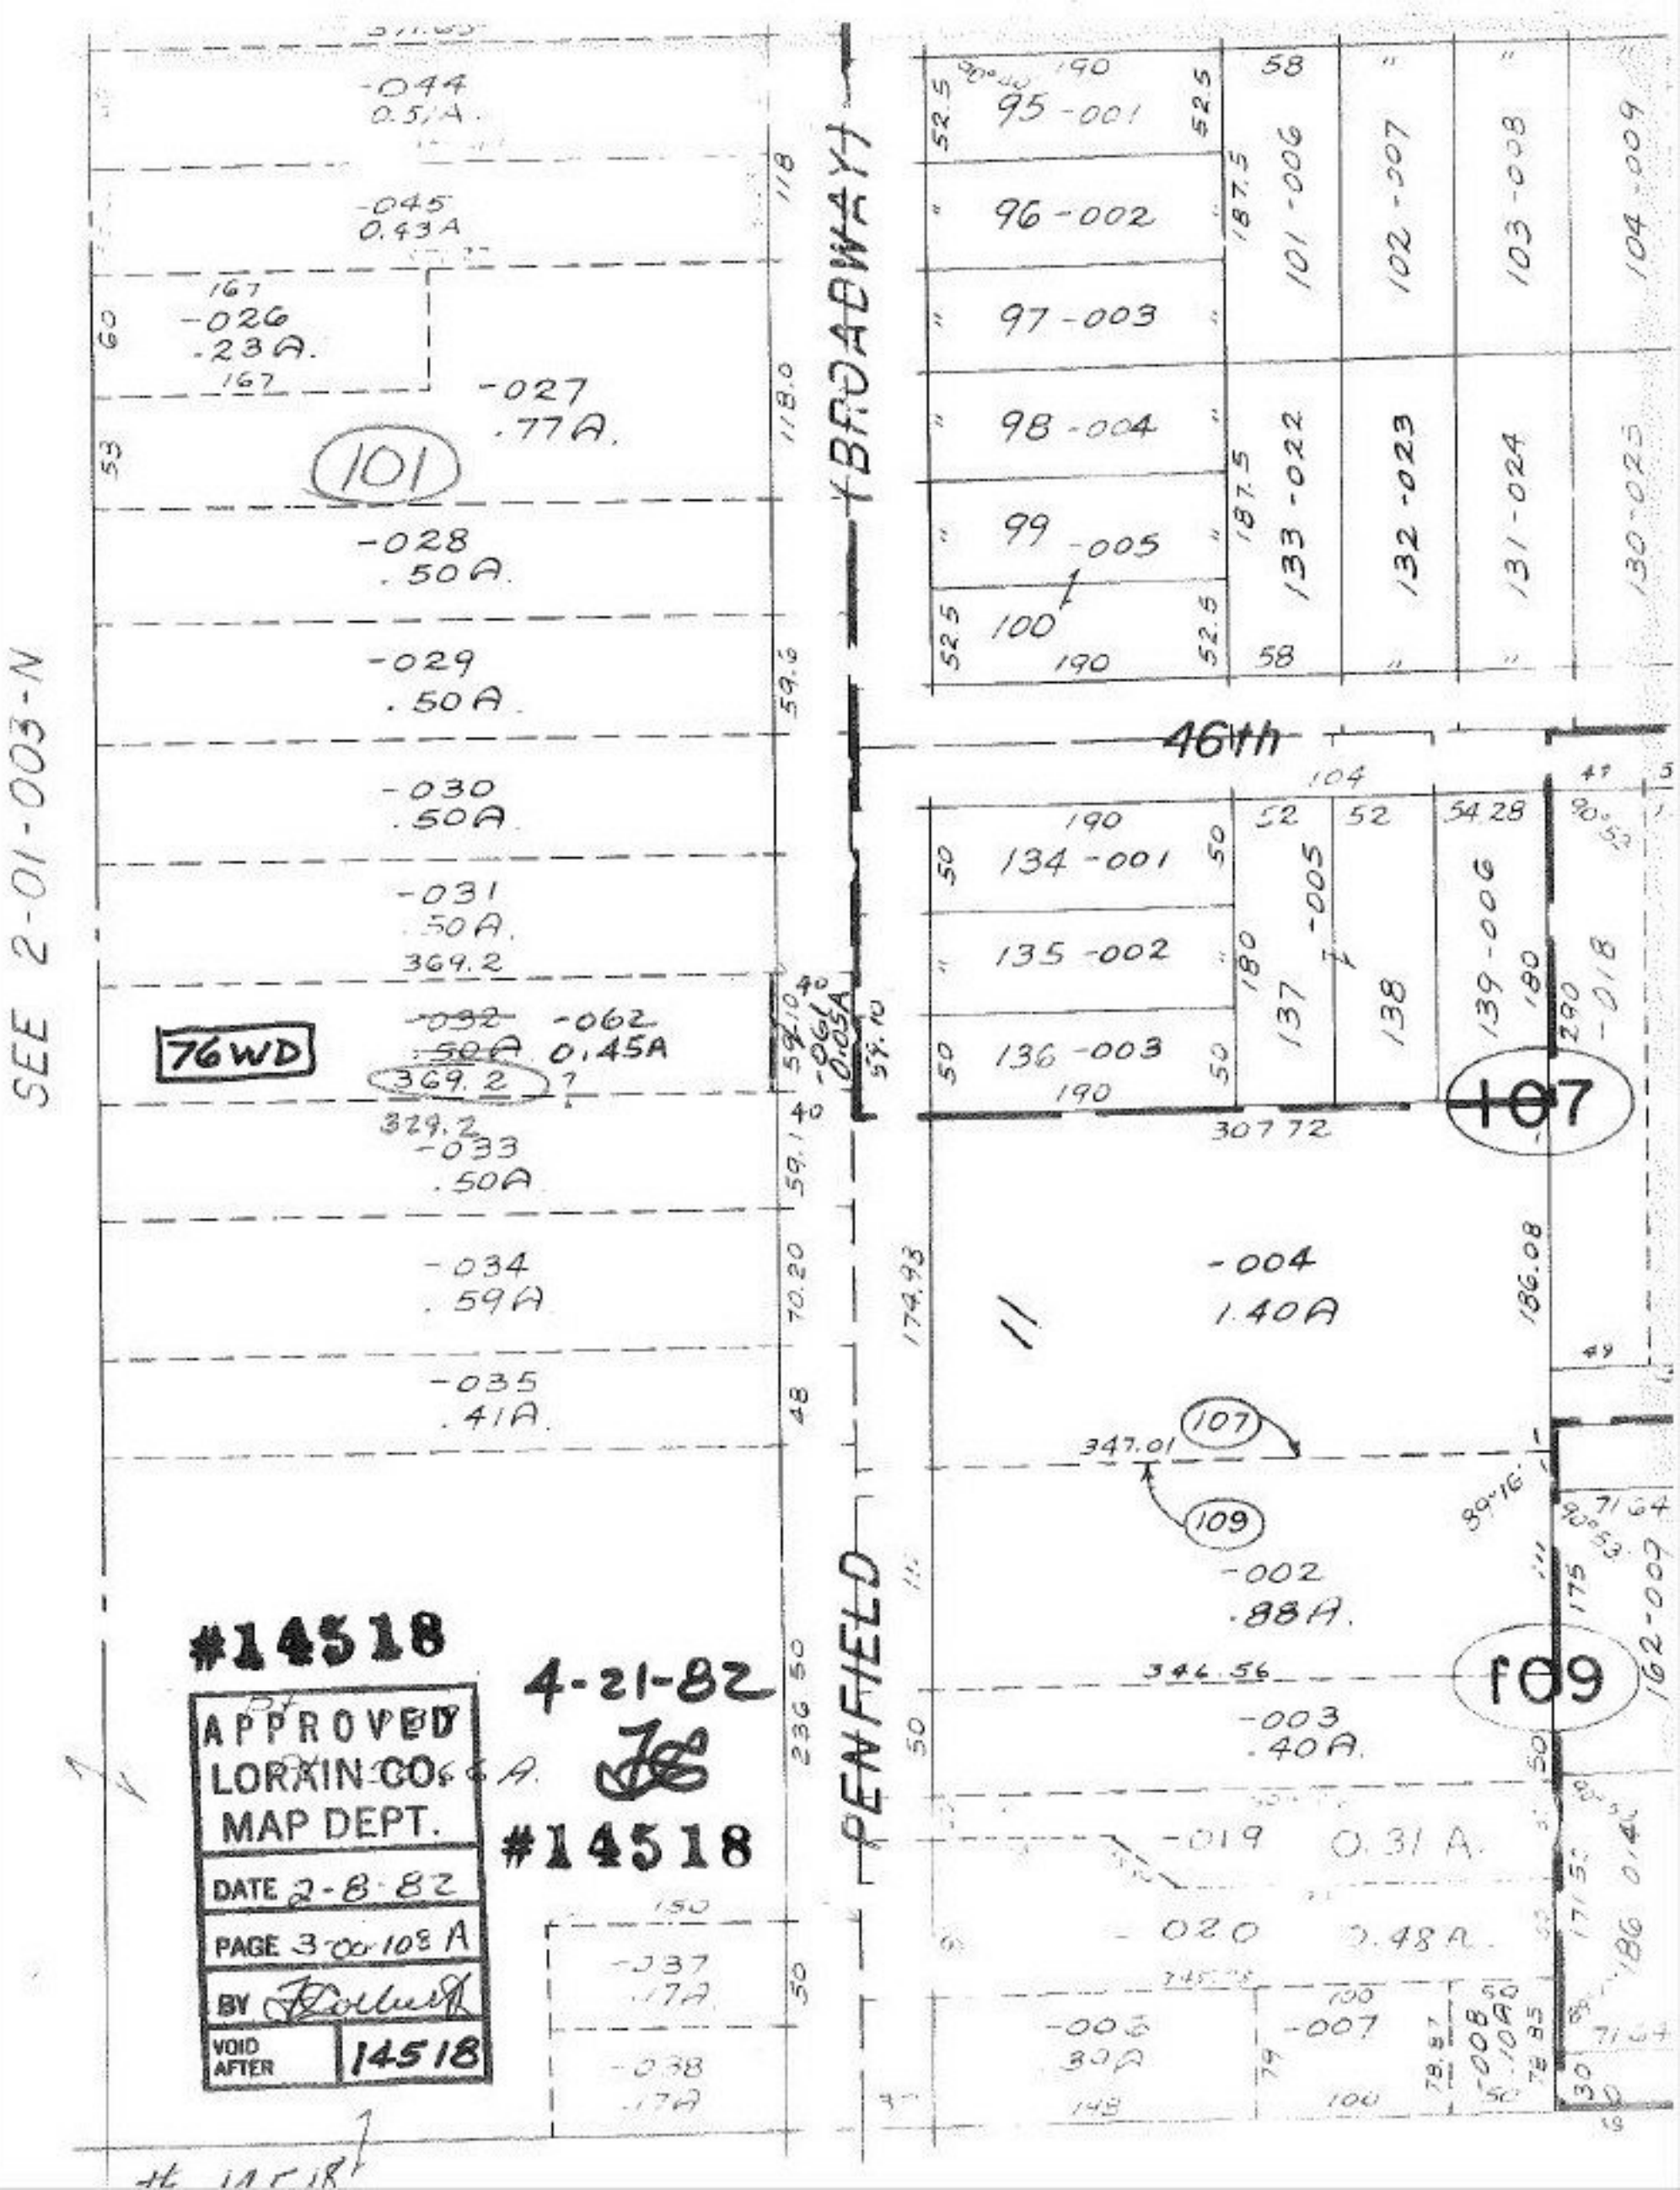

SEE 2-01-003-N
BROADWAY
PENFIELD
46th
-044
0.51A.
-045
0.43A
-026
.23A.
-027
.77A.
101
-028
.50A.
-029
.50A.
-030
.50A.
-031
.50A.
369.2
76WD
-062
0.45A
369.2
329.2
-033
.50A
-034
.59A
-035
.41A.
95-001
96-002
97-003
98-004
99-005
100
101-006
102-007
103-008
104-009
133-022
132-023
131-024
130-025
134-001
135-002
136-003
137-005
138
139-006
-018
107
307.72
-004
1.40A
347.01
109
-002
.88A.
346.56
-003
.40A.
-019
0.31A.
-020
0.48A.
-007
-008
162-009
#14518
APPROVED
LORAIN CO.
MAP DEPT.
DATE 2-8-82
PAGE 3-00-108 A
BY
VOID AFTER 14518
4-21-82
#14518