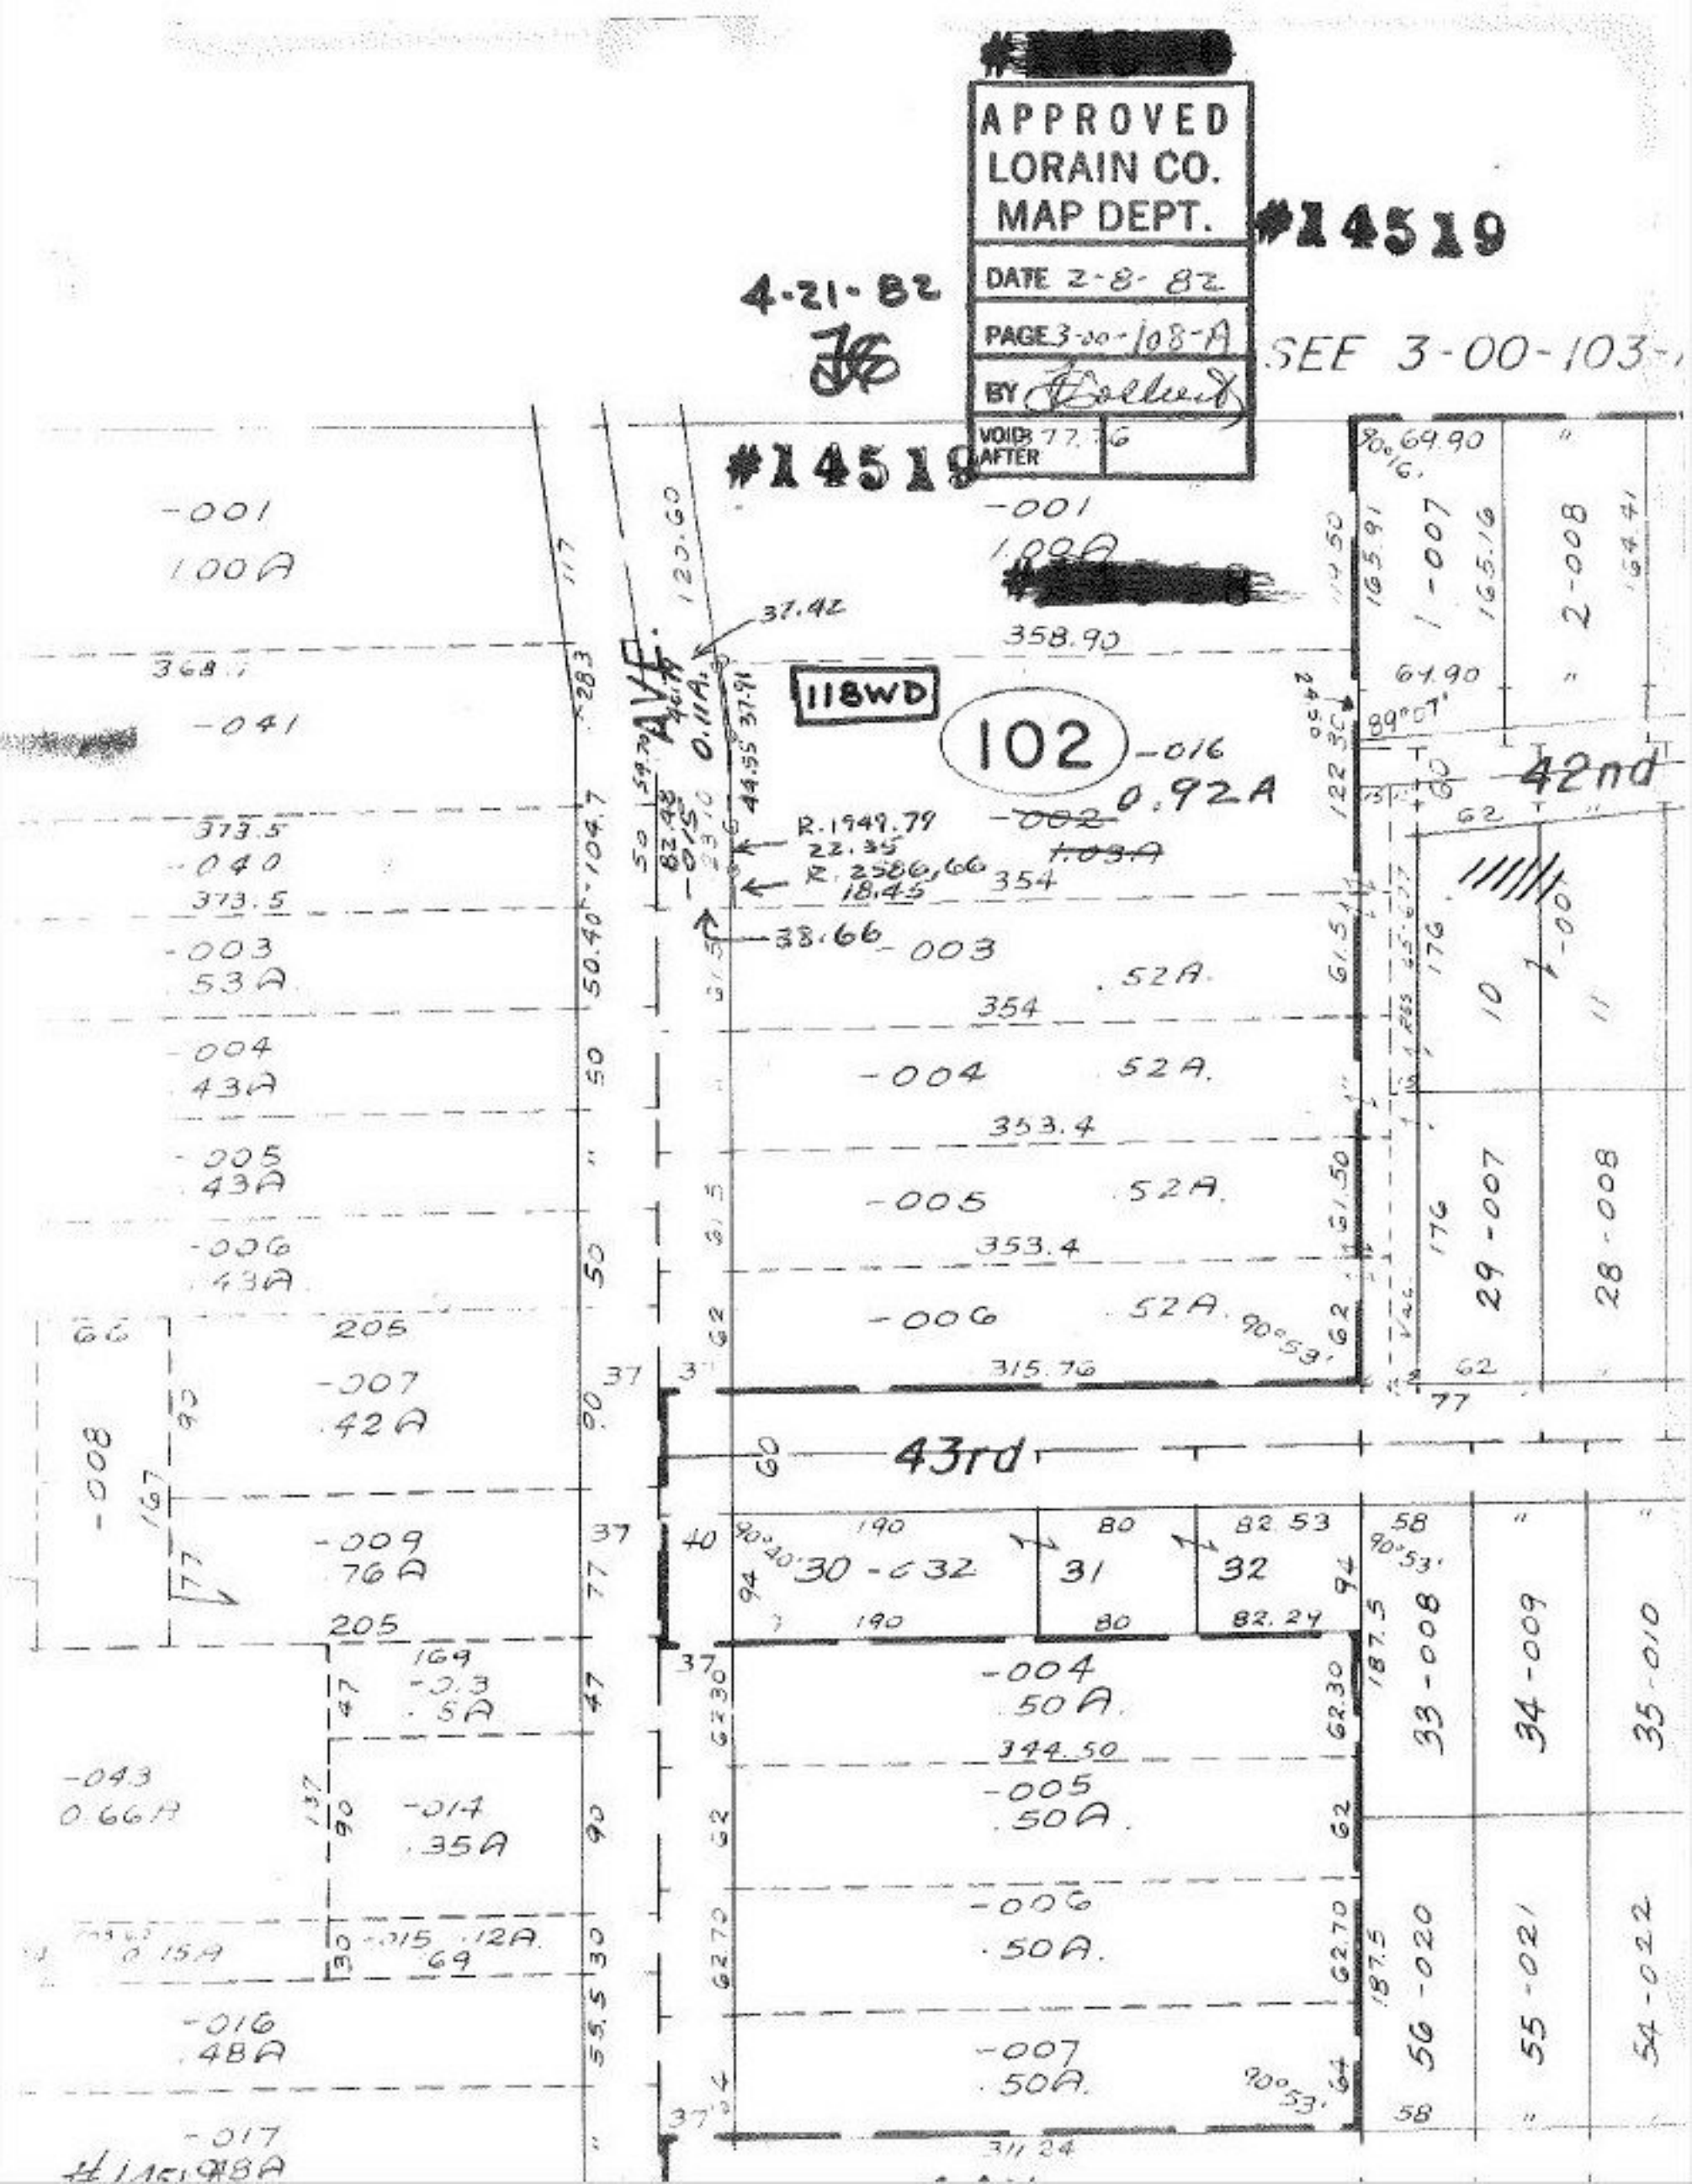

#[redacted]
APPROVED
LORAIN CO.
MAP DEPT.
DATE 2-8-82
PAGE 3-00-108-A
BY
VOID AFTER 77.76
#14519
4-21-82
SEE 3-00-103-
#14519
-001
1.00A
-001
1.00A
[redacted]
358.90
118WD
102
-016
0.92A
-002
1.03A
AVE.
37.42
0.11A
R.1949.79
22.35
R.2586.66
18.45
38.66
-003
.52A
354
-004
.52A
353.4
-005
.52A
353.4
-006
.52A
315.76
42nd
43rd
1-007
2-008
29-007
28-008
30-032
31
32
33-008
34-009
35-010
56-020
55-021
54-022
-004
.50A
344.50
-005
.50A
-006
.50A
-007
.50A
311.24
-001
1.00A
368.7
-041
373.5
-040
373.5
-003
.53A
-004
.43A
-005
.43A
-006
.43A
205
-007
.42A
-008
-009
.76A
205
-043
0.66A
-014
.35A
-016
.48A
-017