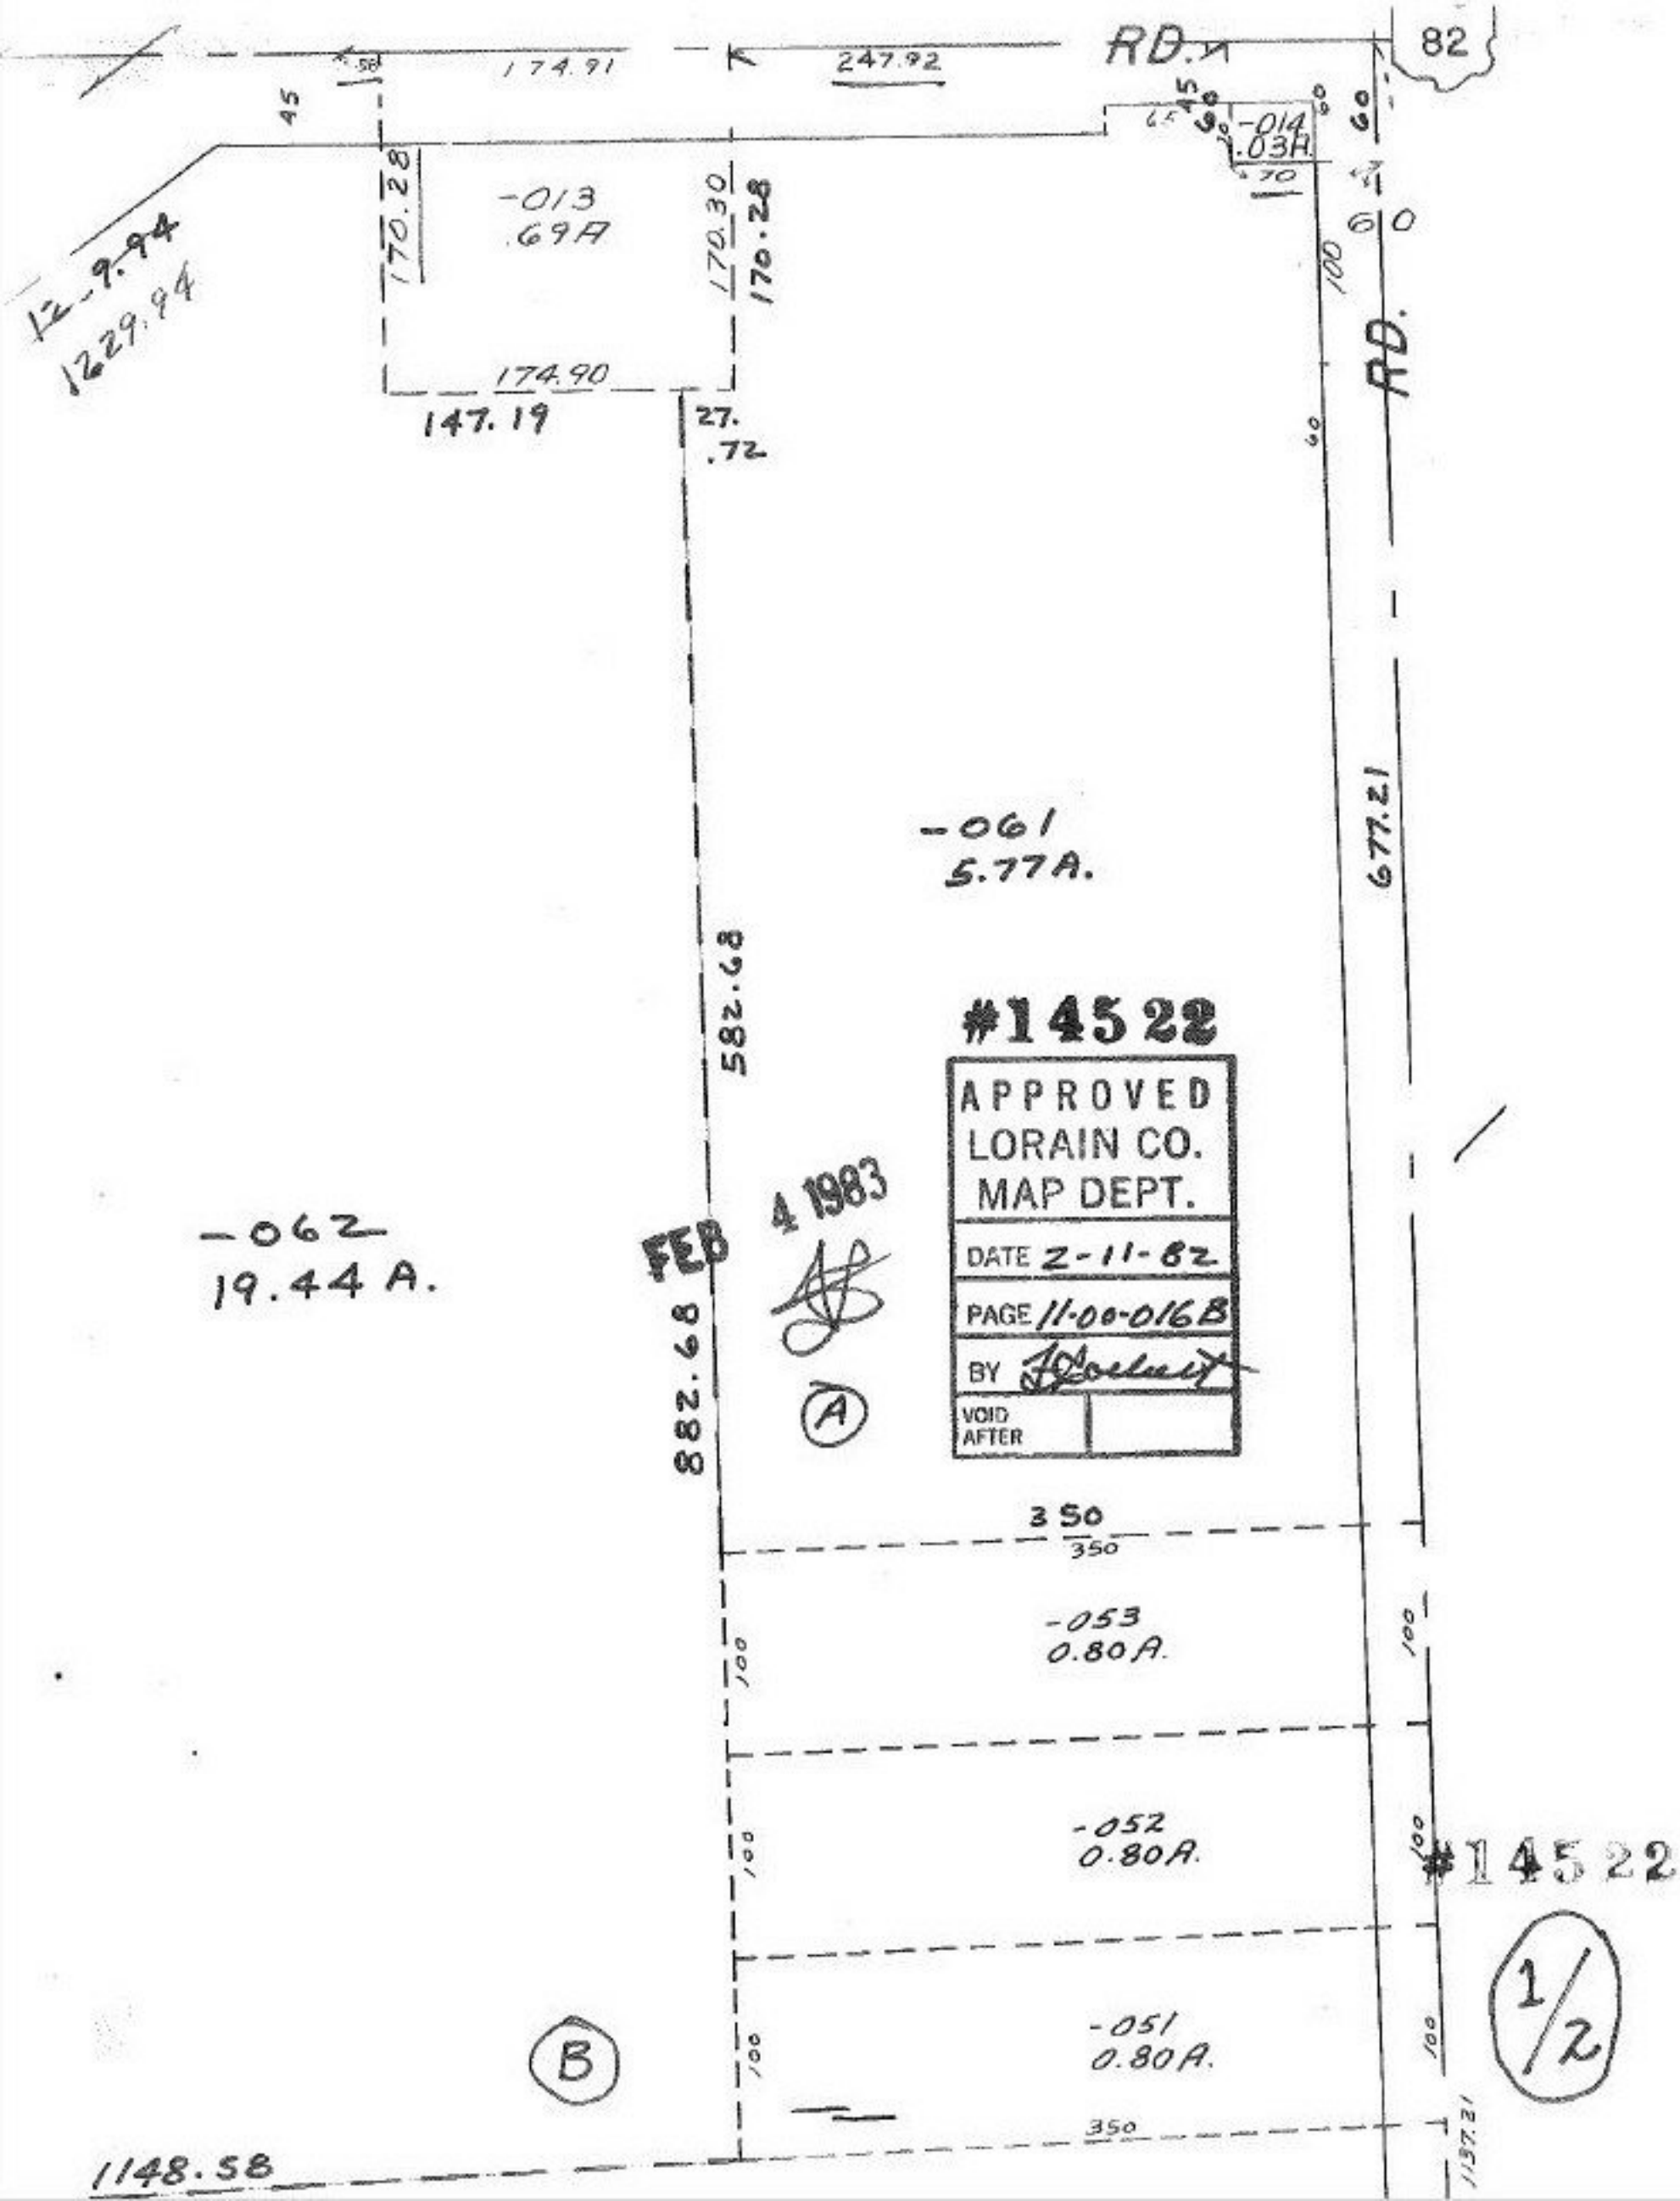
82
RD.
174.91
247.92
45
-014
.03A
60
-013
.69A
170.28
170.30
170.28
12-9.94
1229.94
174.90
147.19
27.
.72
RD.
-061
5.77A.
677.21
582.68
#14522
APPROVED
LORAIN CO.
MAP DEPT.
DATE 2-11-82
PAGE 11-00-016B
BY
VOID AFTER
FEB 4 1983
-062
19.44 A.
882.68
A
350
350
-053
0.80A.
100
-052
0.80A.
#14522
1/2
-051
0.80A.
B
350
1148.58
1137.21