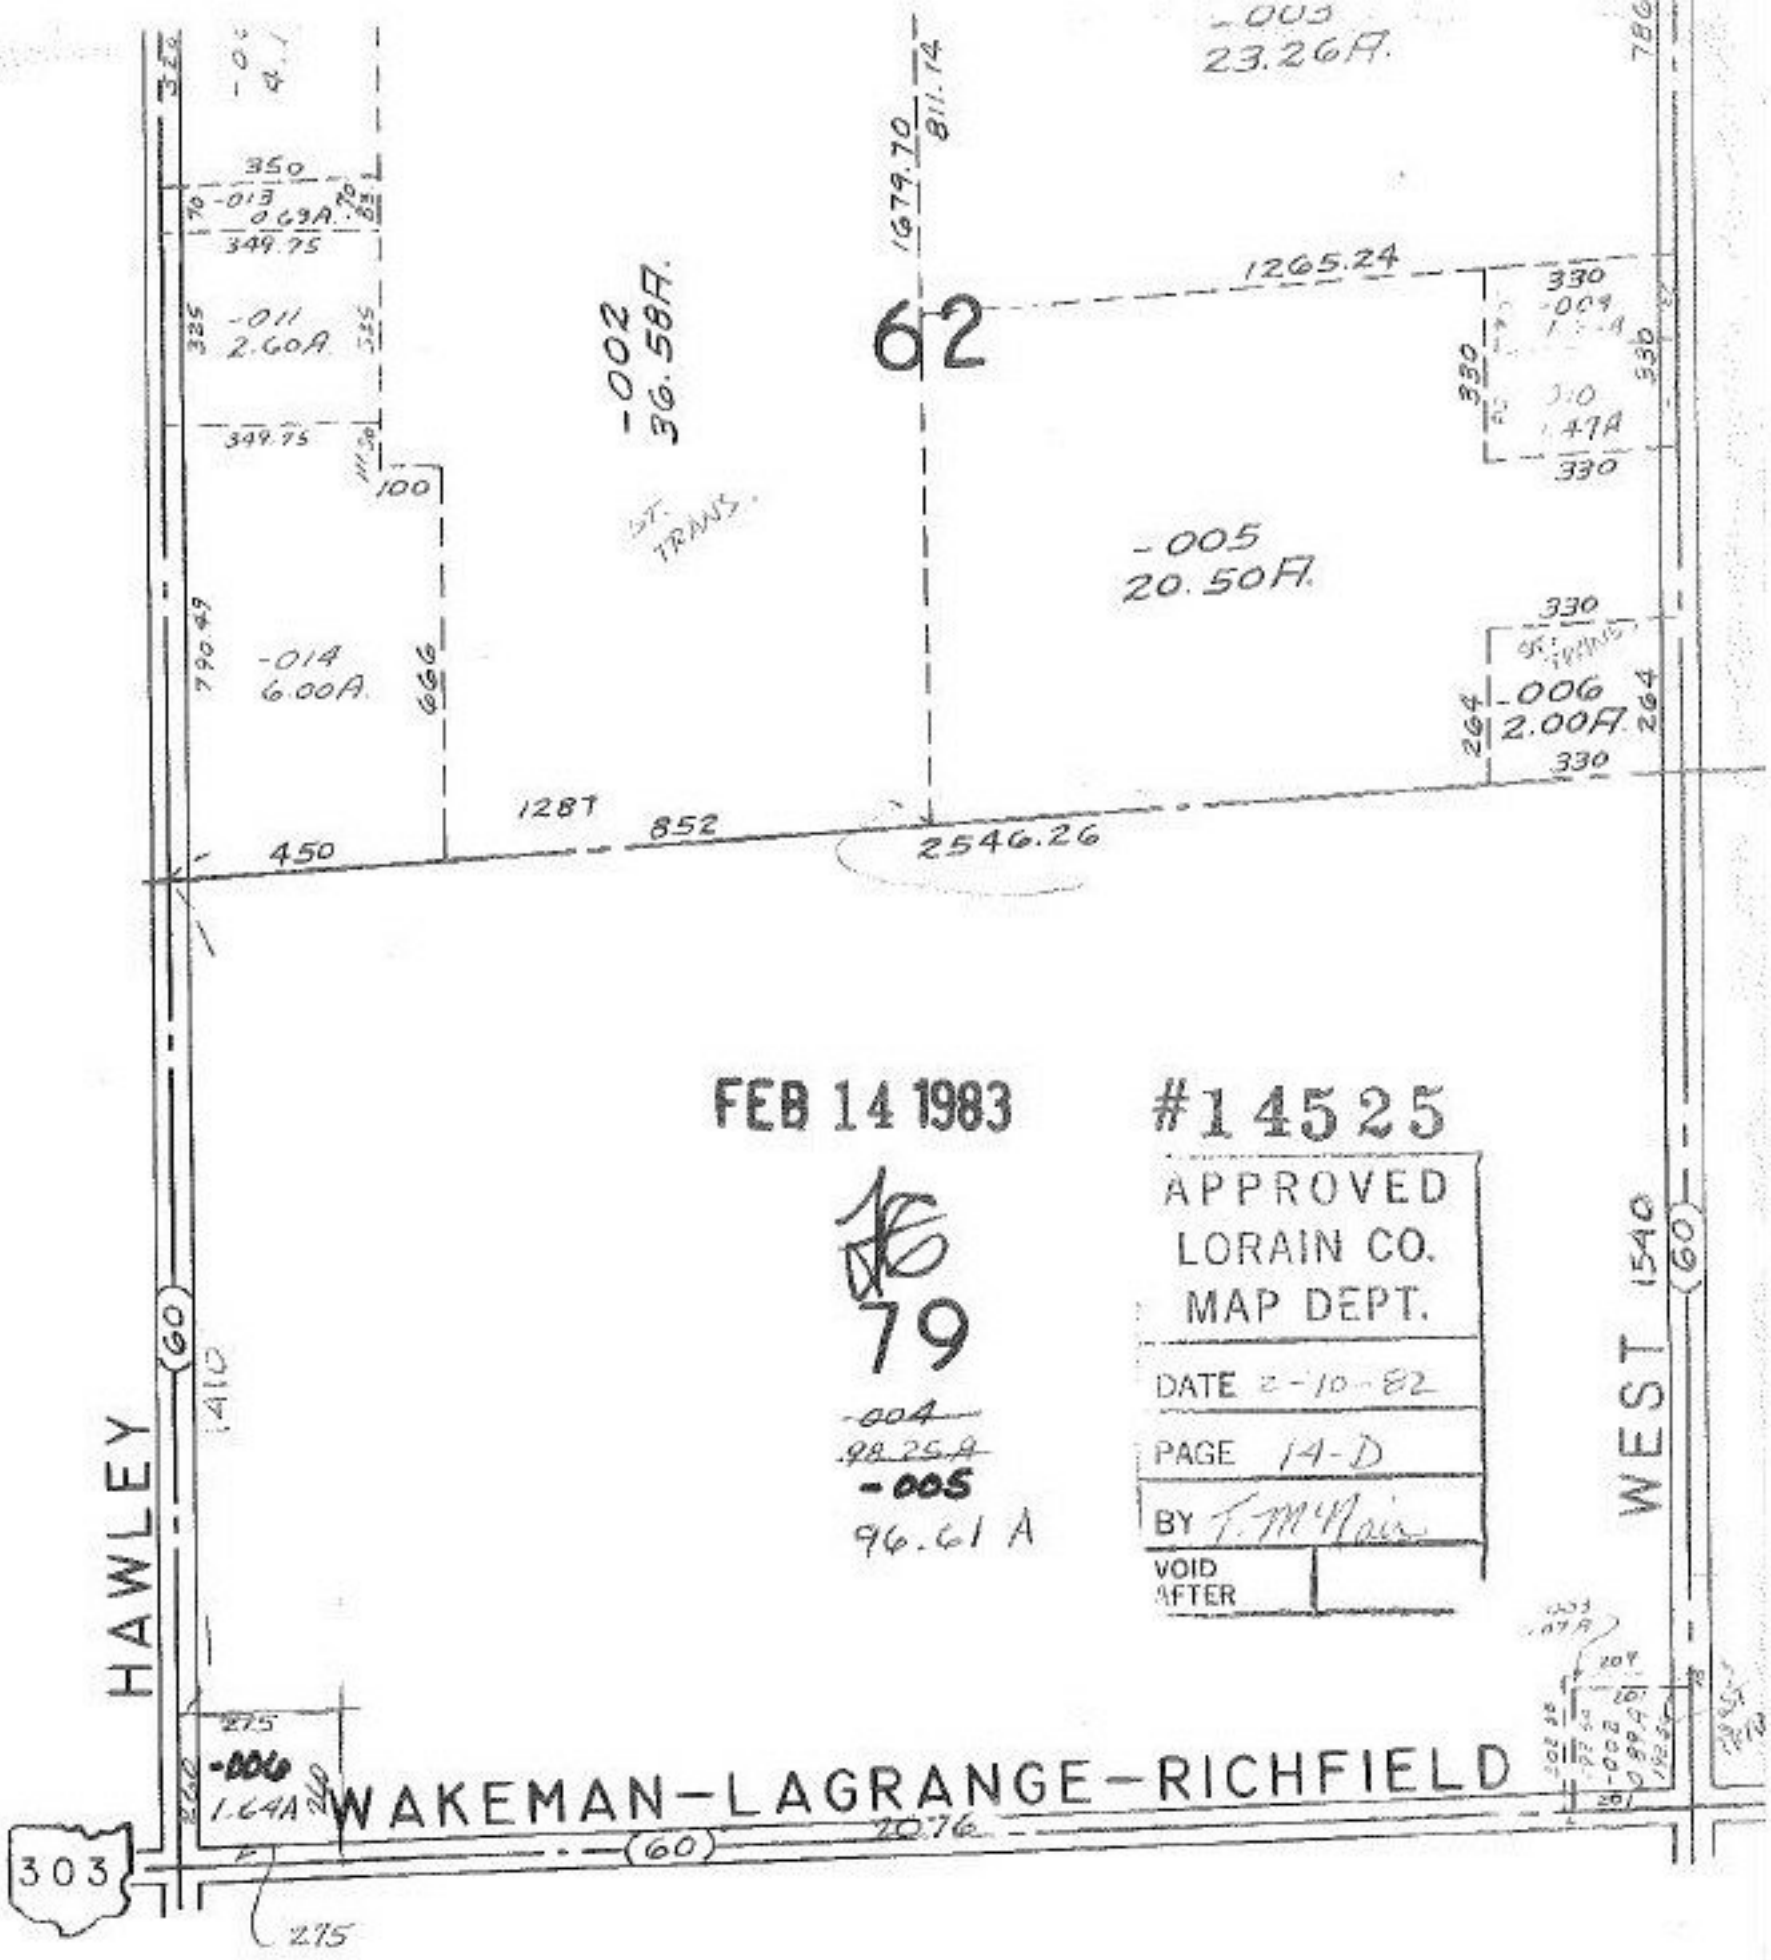

PITTSFIELD TWP

SCALE: 1" = 400'