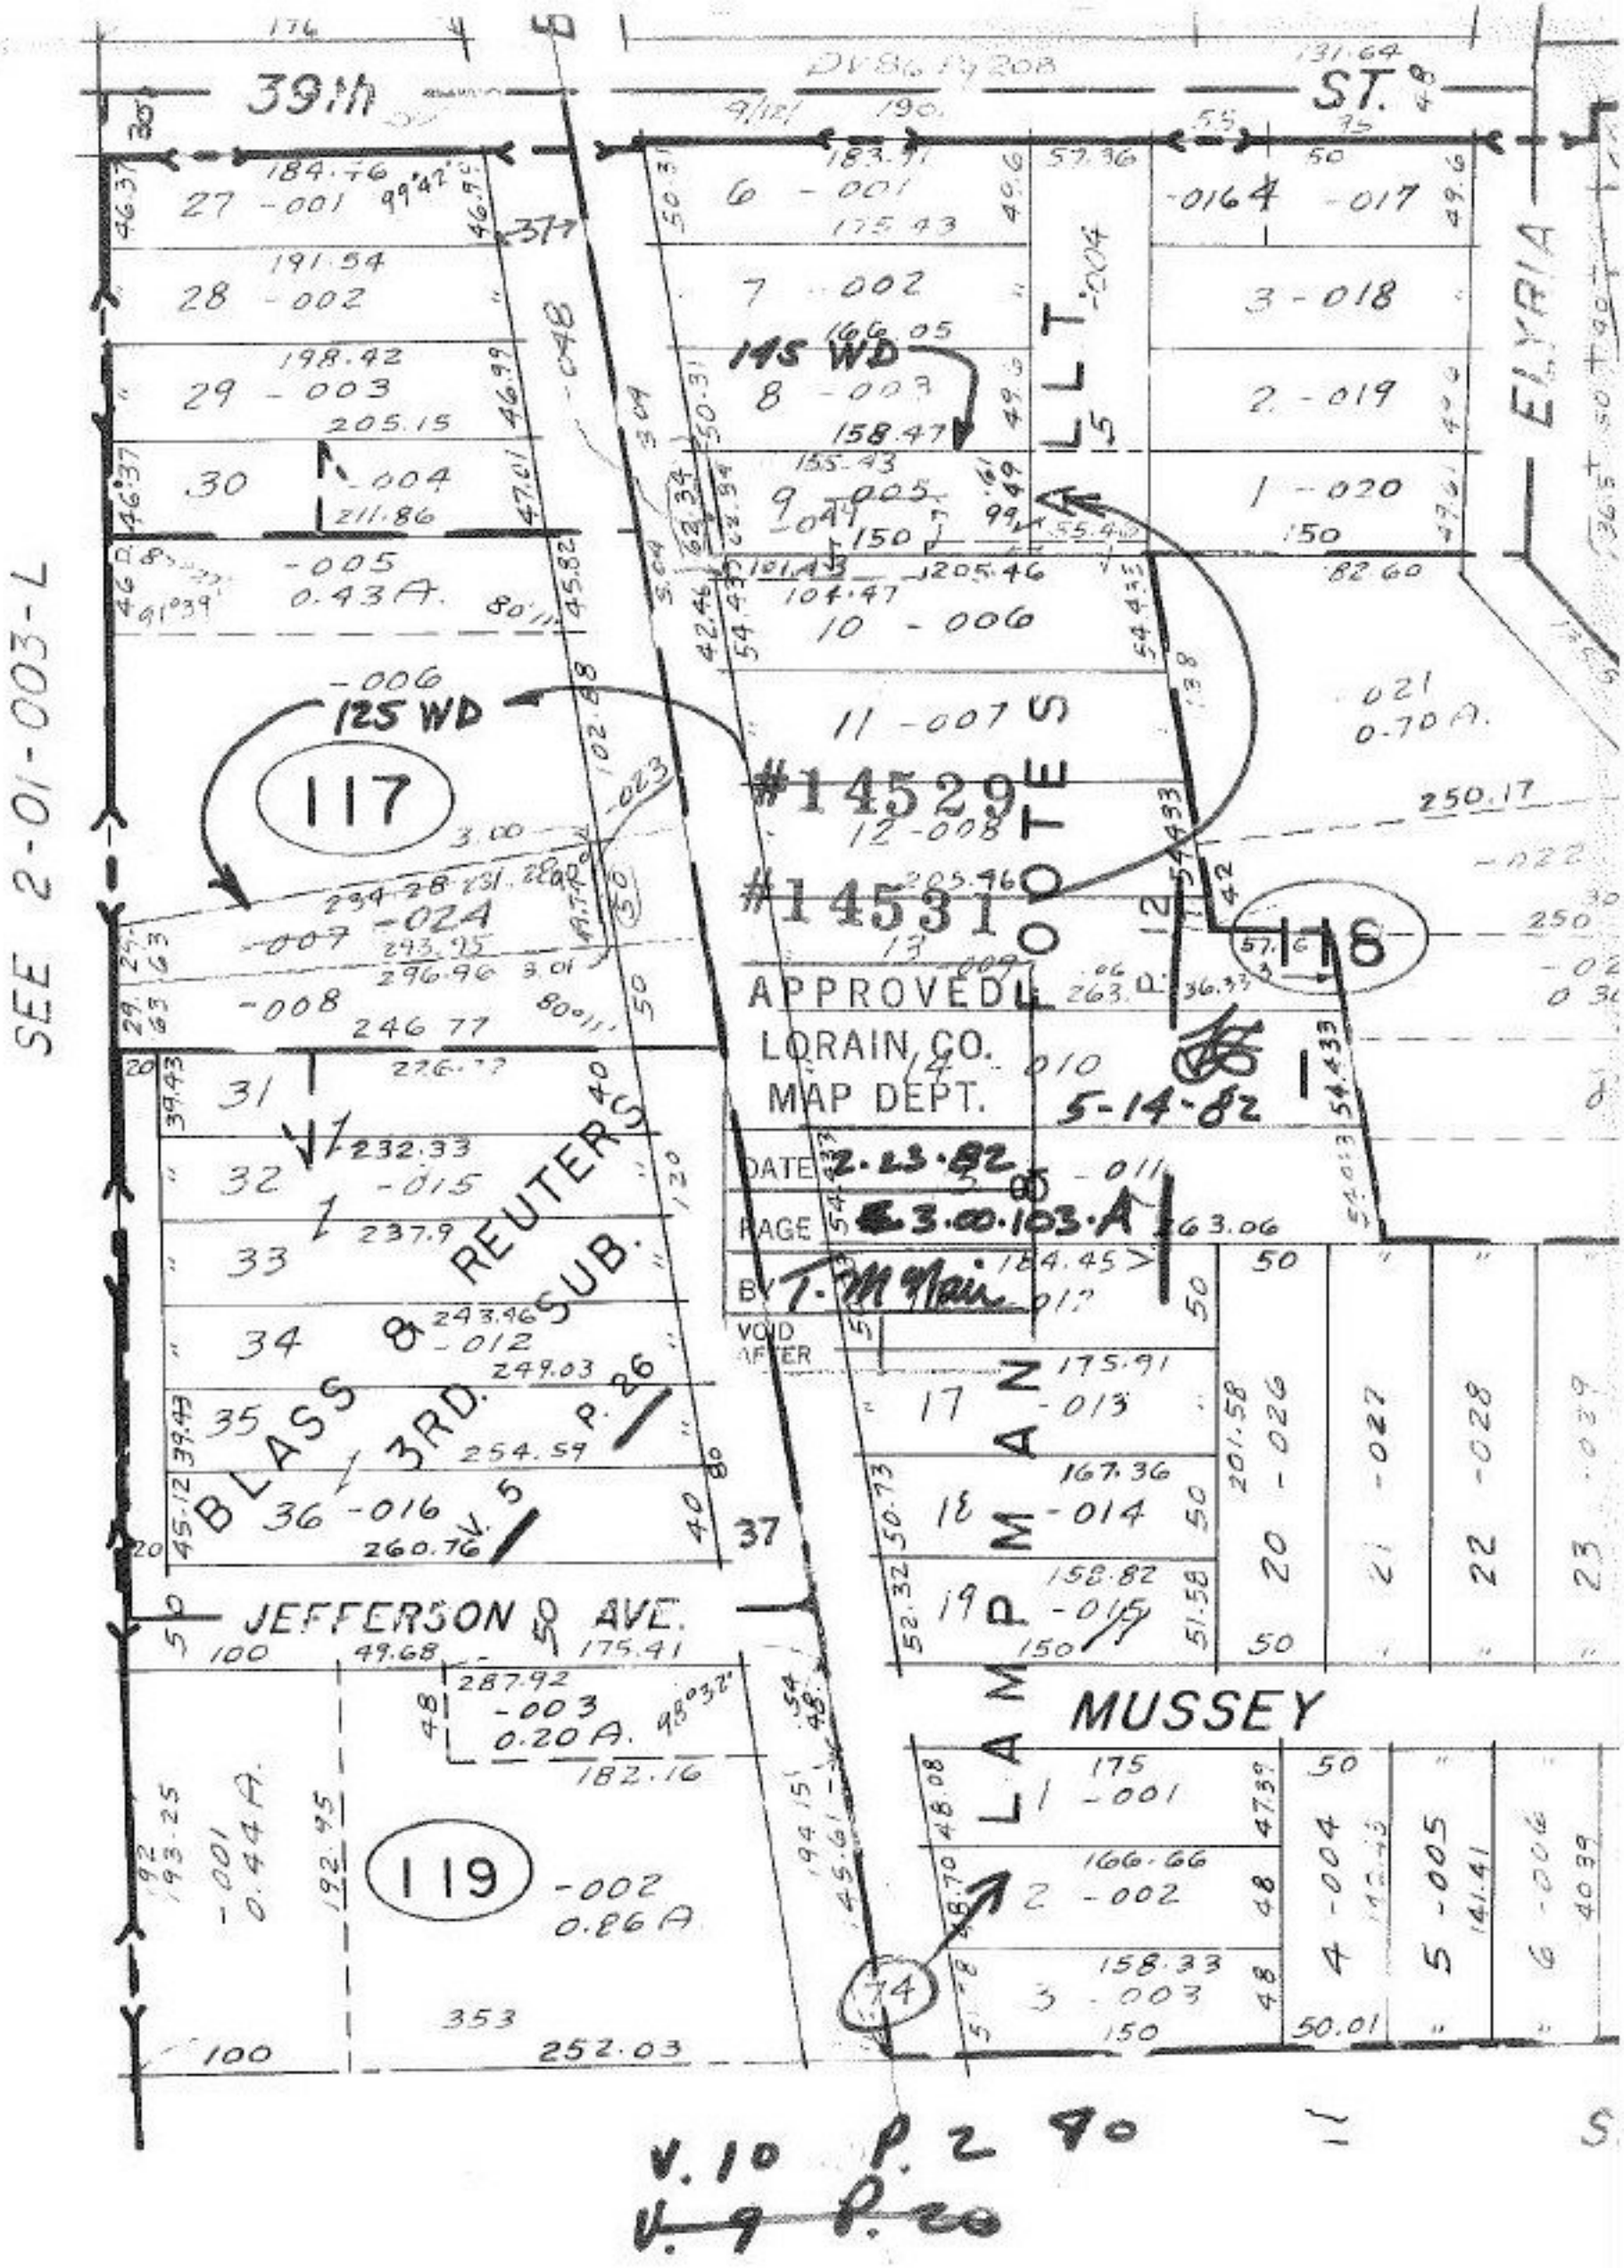

39th
ST.
ELYRIA
SEE 2-01-003-L
145 WD
125 WD
117
118
119
#14529
#14531
APPROVED
LORAIN CO.
MAP DEPT.
DATE 2-23-82
PAGE 3.00.103-A
BY T. McNair
VOID AFTER
5-14-82
BLASS & REUTERS 3RD. SUB.
V. 5 P. 26
JEFFERSON AVE.
MUSSEY
LAMPMAN
FOOTES ALLT.
V. 10 P. 2 90
V. 9 P. 20