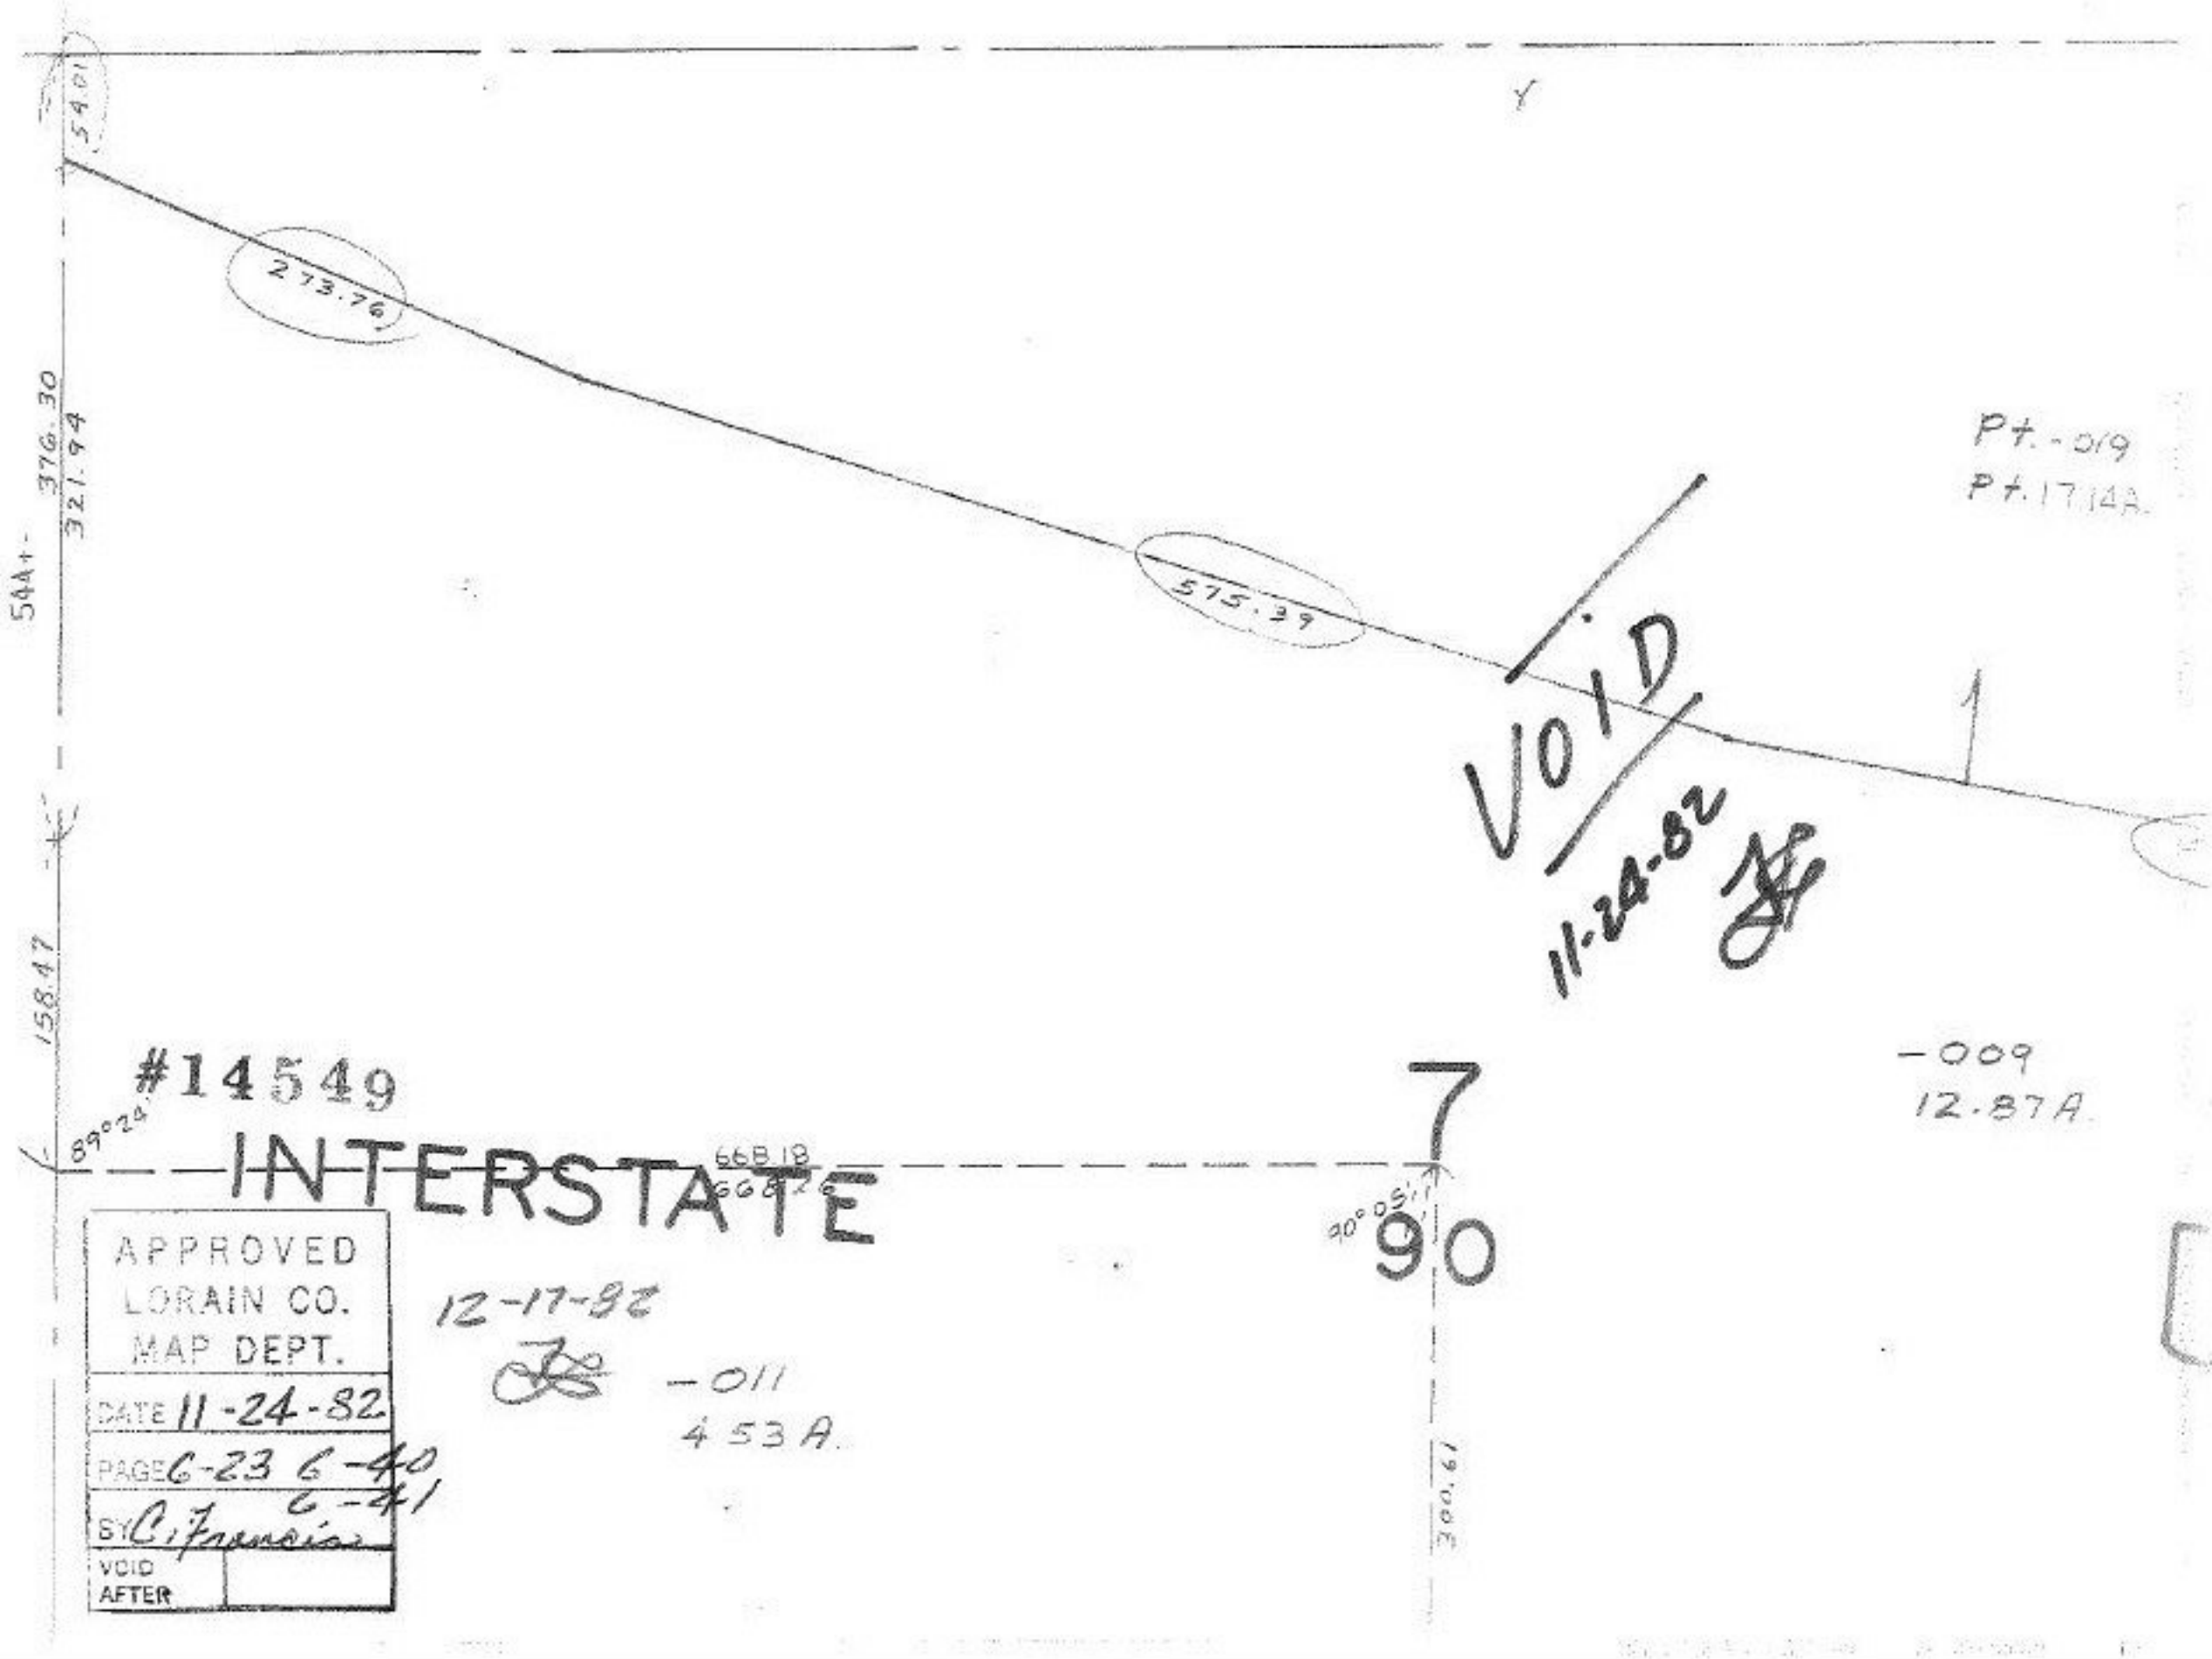
54.01
273.76
575.39
54A+-
376.30
321.94
158.47
89°24'
Pt.-019
Pt.1714A.
VOID
11-24-82
-009
12.87A.
#14549
INTERSTATE
7
90
668.18
668.26
90°05'
300.61
12-17-82
-011
4.53A.
APPROVED
LORAIN CO.
MAP DEPT.
DATE 11-24-82
PAGE 6-23 6-40
6-41
BY C. Francis
VOID
AFTER