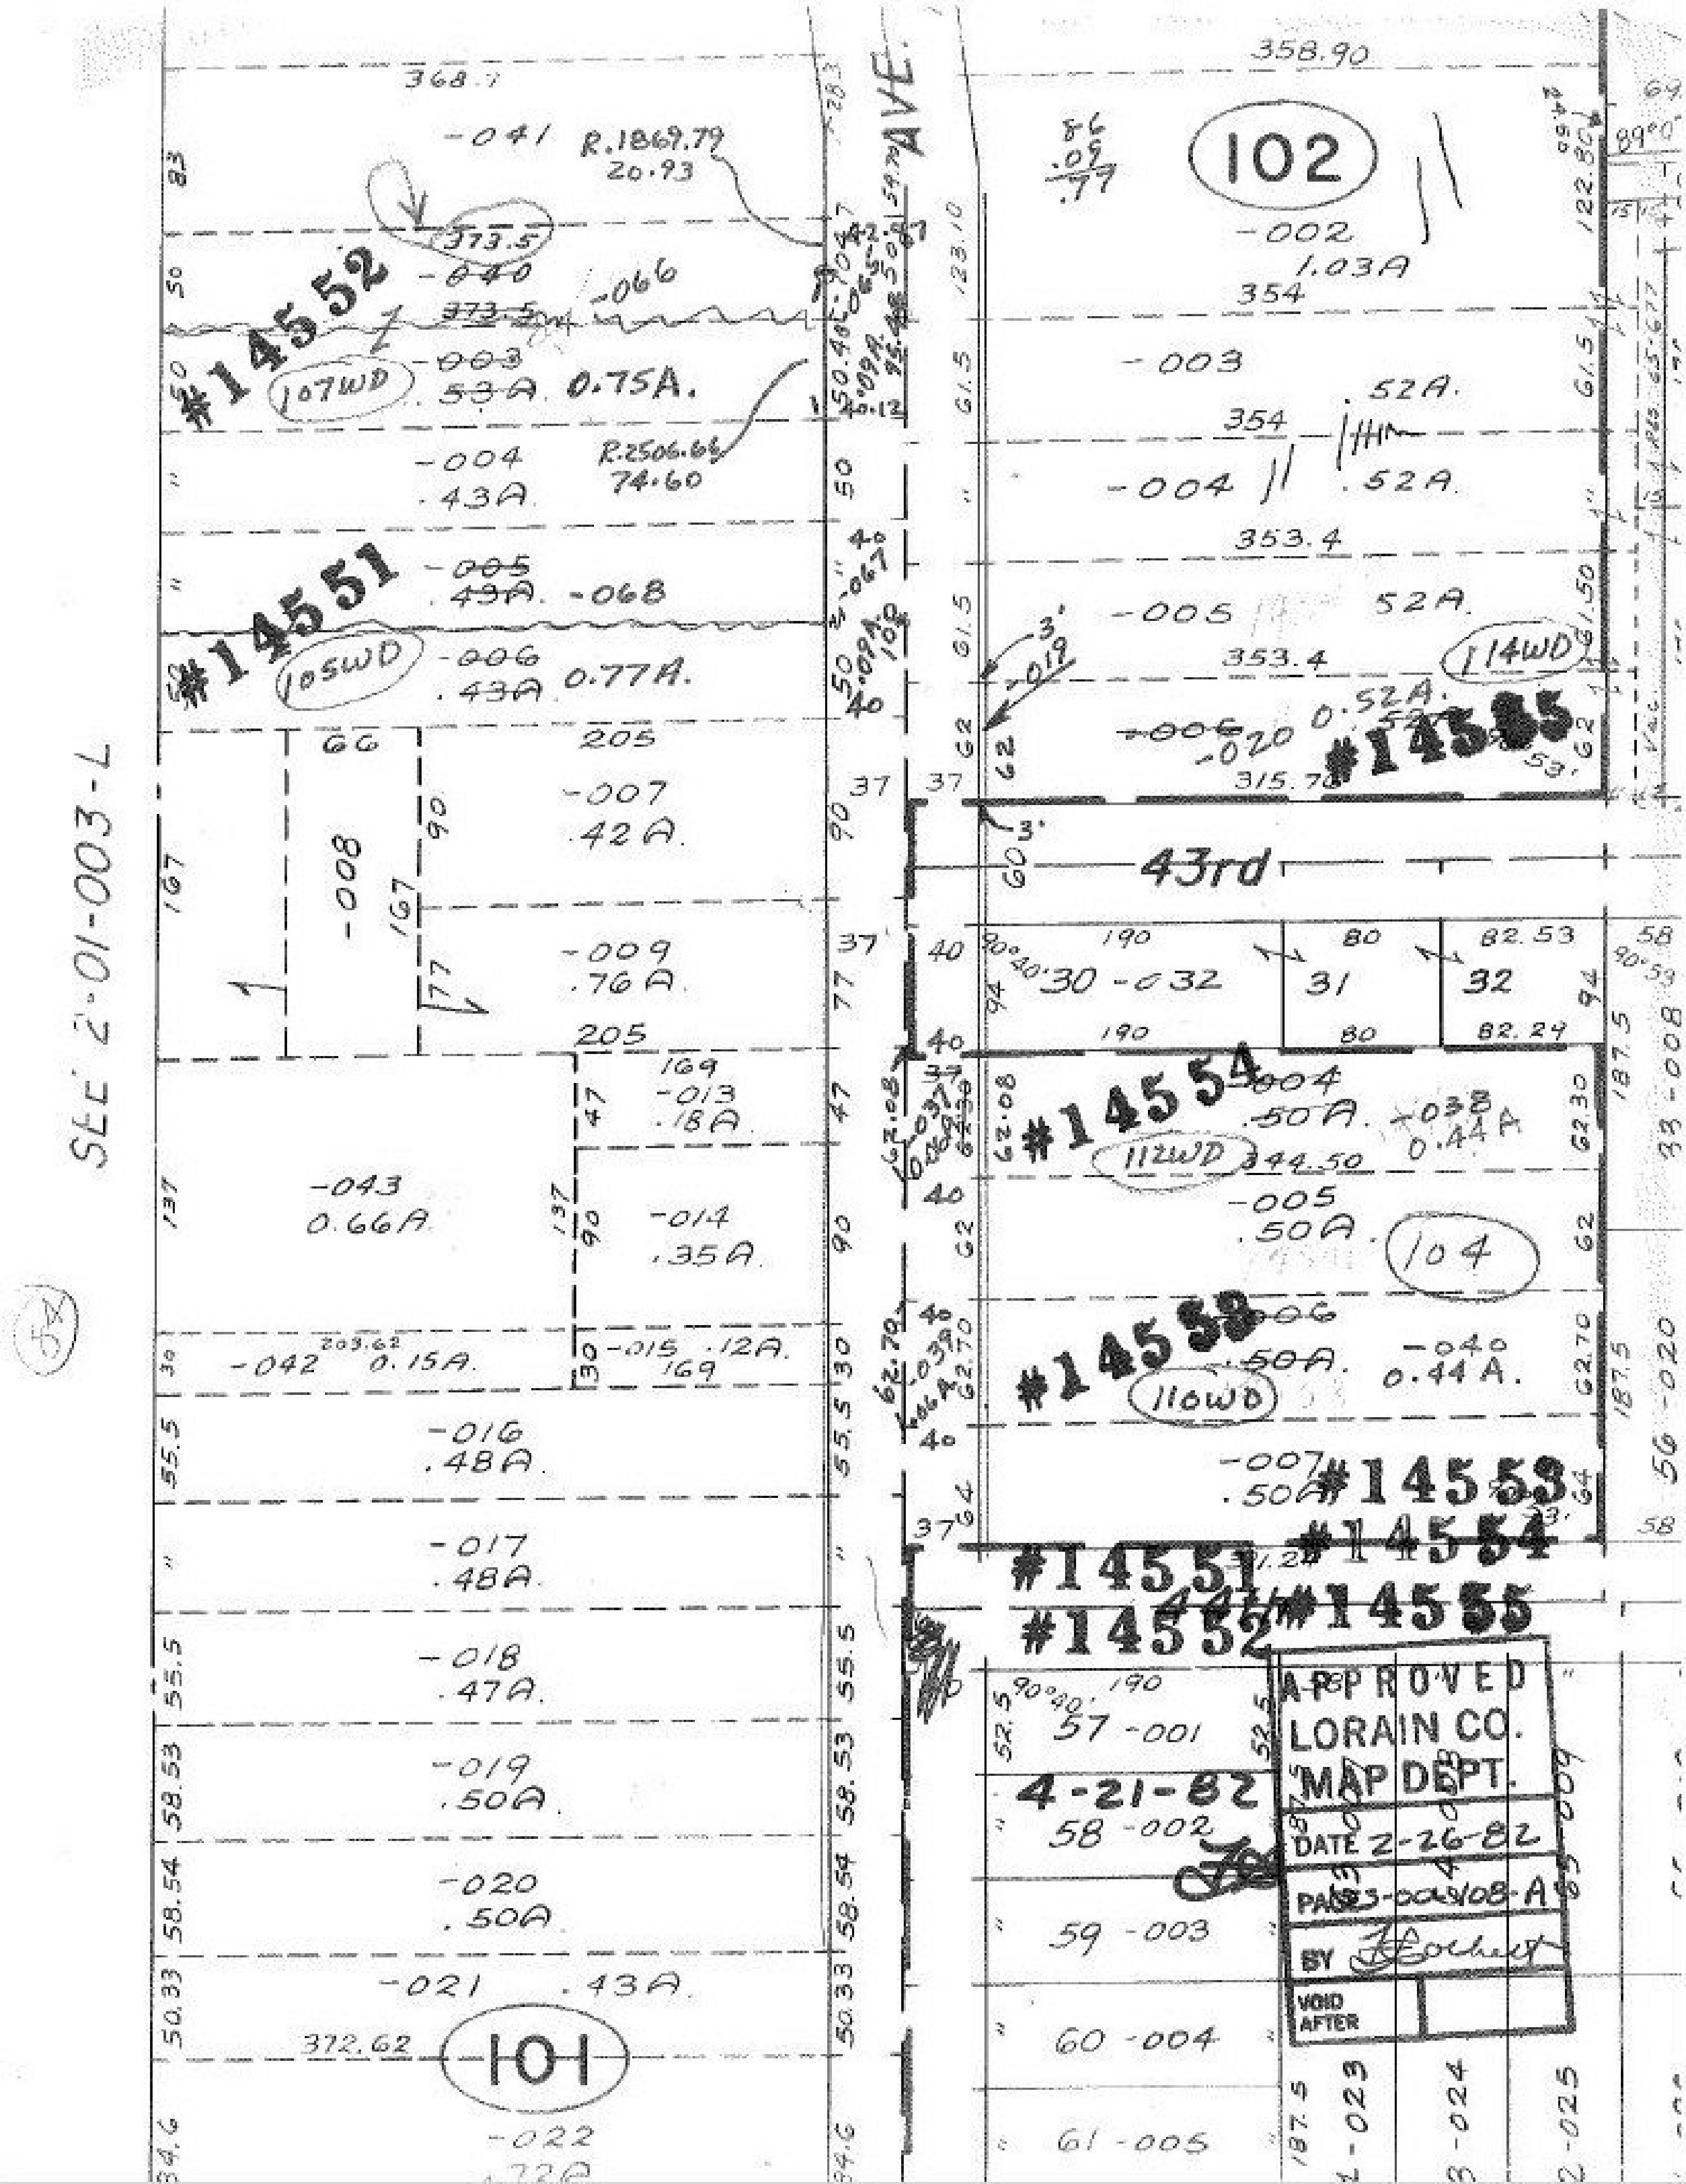
SEC 2-01-003-L
AVE.
102
101
104
43rd
44th
#14552
#14551
#14585
#14554
#14558
#14553
#14555
107WD
105WD
114WD
112WD
110WD
-041 R.1869.79 20.93
-040 -066
-003 .53A 0.75A.
-004 .43A R.2506.66 74.60
-005 .43A. -068
-006 .43A 0.77A.
-007 .42A.
-008
-009 .76A.
-013 .18A
-043 0.66A.
-014 .35A.
-042 0.15A.
-015 .12A.
-016 .48A.
-017 .48A.
-018 .47A.
-019 .50A.
-020 .50A
-021 .43A.
-022
-002 1.03A
-003 .52A.
-004 .52A.
-005 52A.
-006 -020 0.52A.
-019
30 -032
31
32
-004 .50A. -038 0.44A
-005 .50A.
-006 .50A. -040 0.44 A.
-007 .50A
57 -001
58 -002
59 -003
60 -004
61 -005
-023
-024
-025
33-008
56-020
4-21-82
APPROVED
LORAIN CO.
MAP DEPT.
DATE 2-26-82
PAGE 3-00408-A
BY
VOID AFTER