-010 SIZE CORRECTED PER 972/664

-038 -039 > PARCELS SWITCHED PER 1103/419

SPLIT WAS DRAWN INCORRECTLY WHEN IT WAS FIRST CUT OUT.

CORRECTS SPLIT #7983 DONE 5-24-74

MAP (ONLY) CORRECTION SEE 15-00-045-B

303

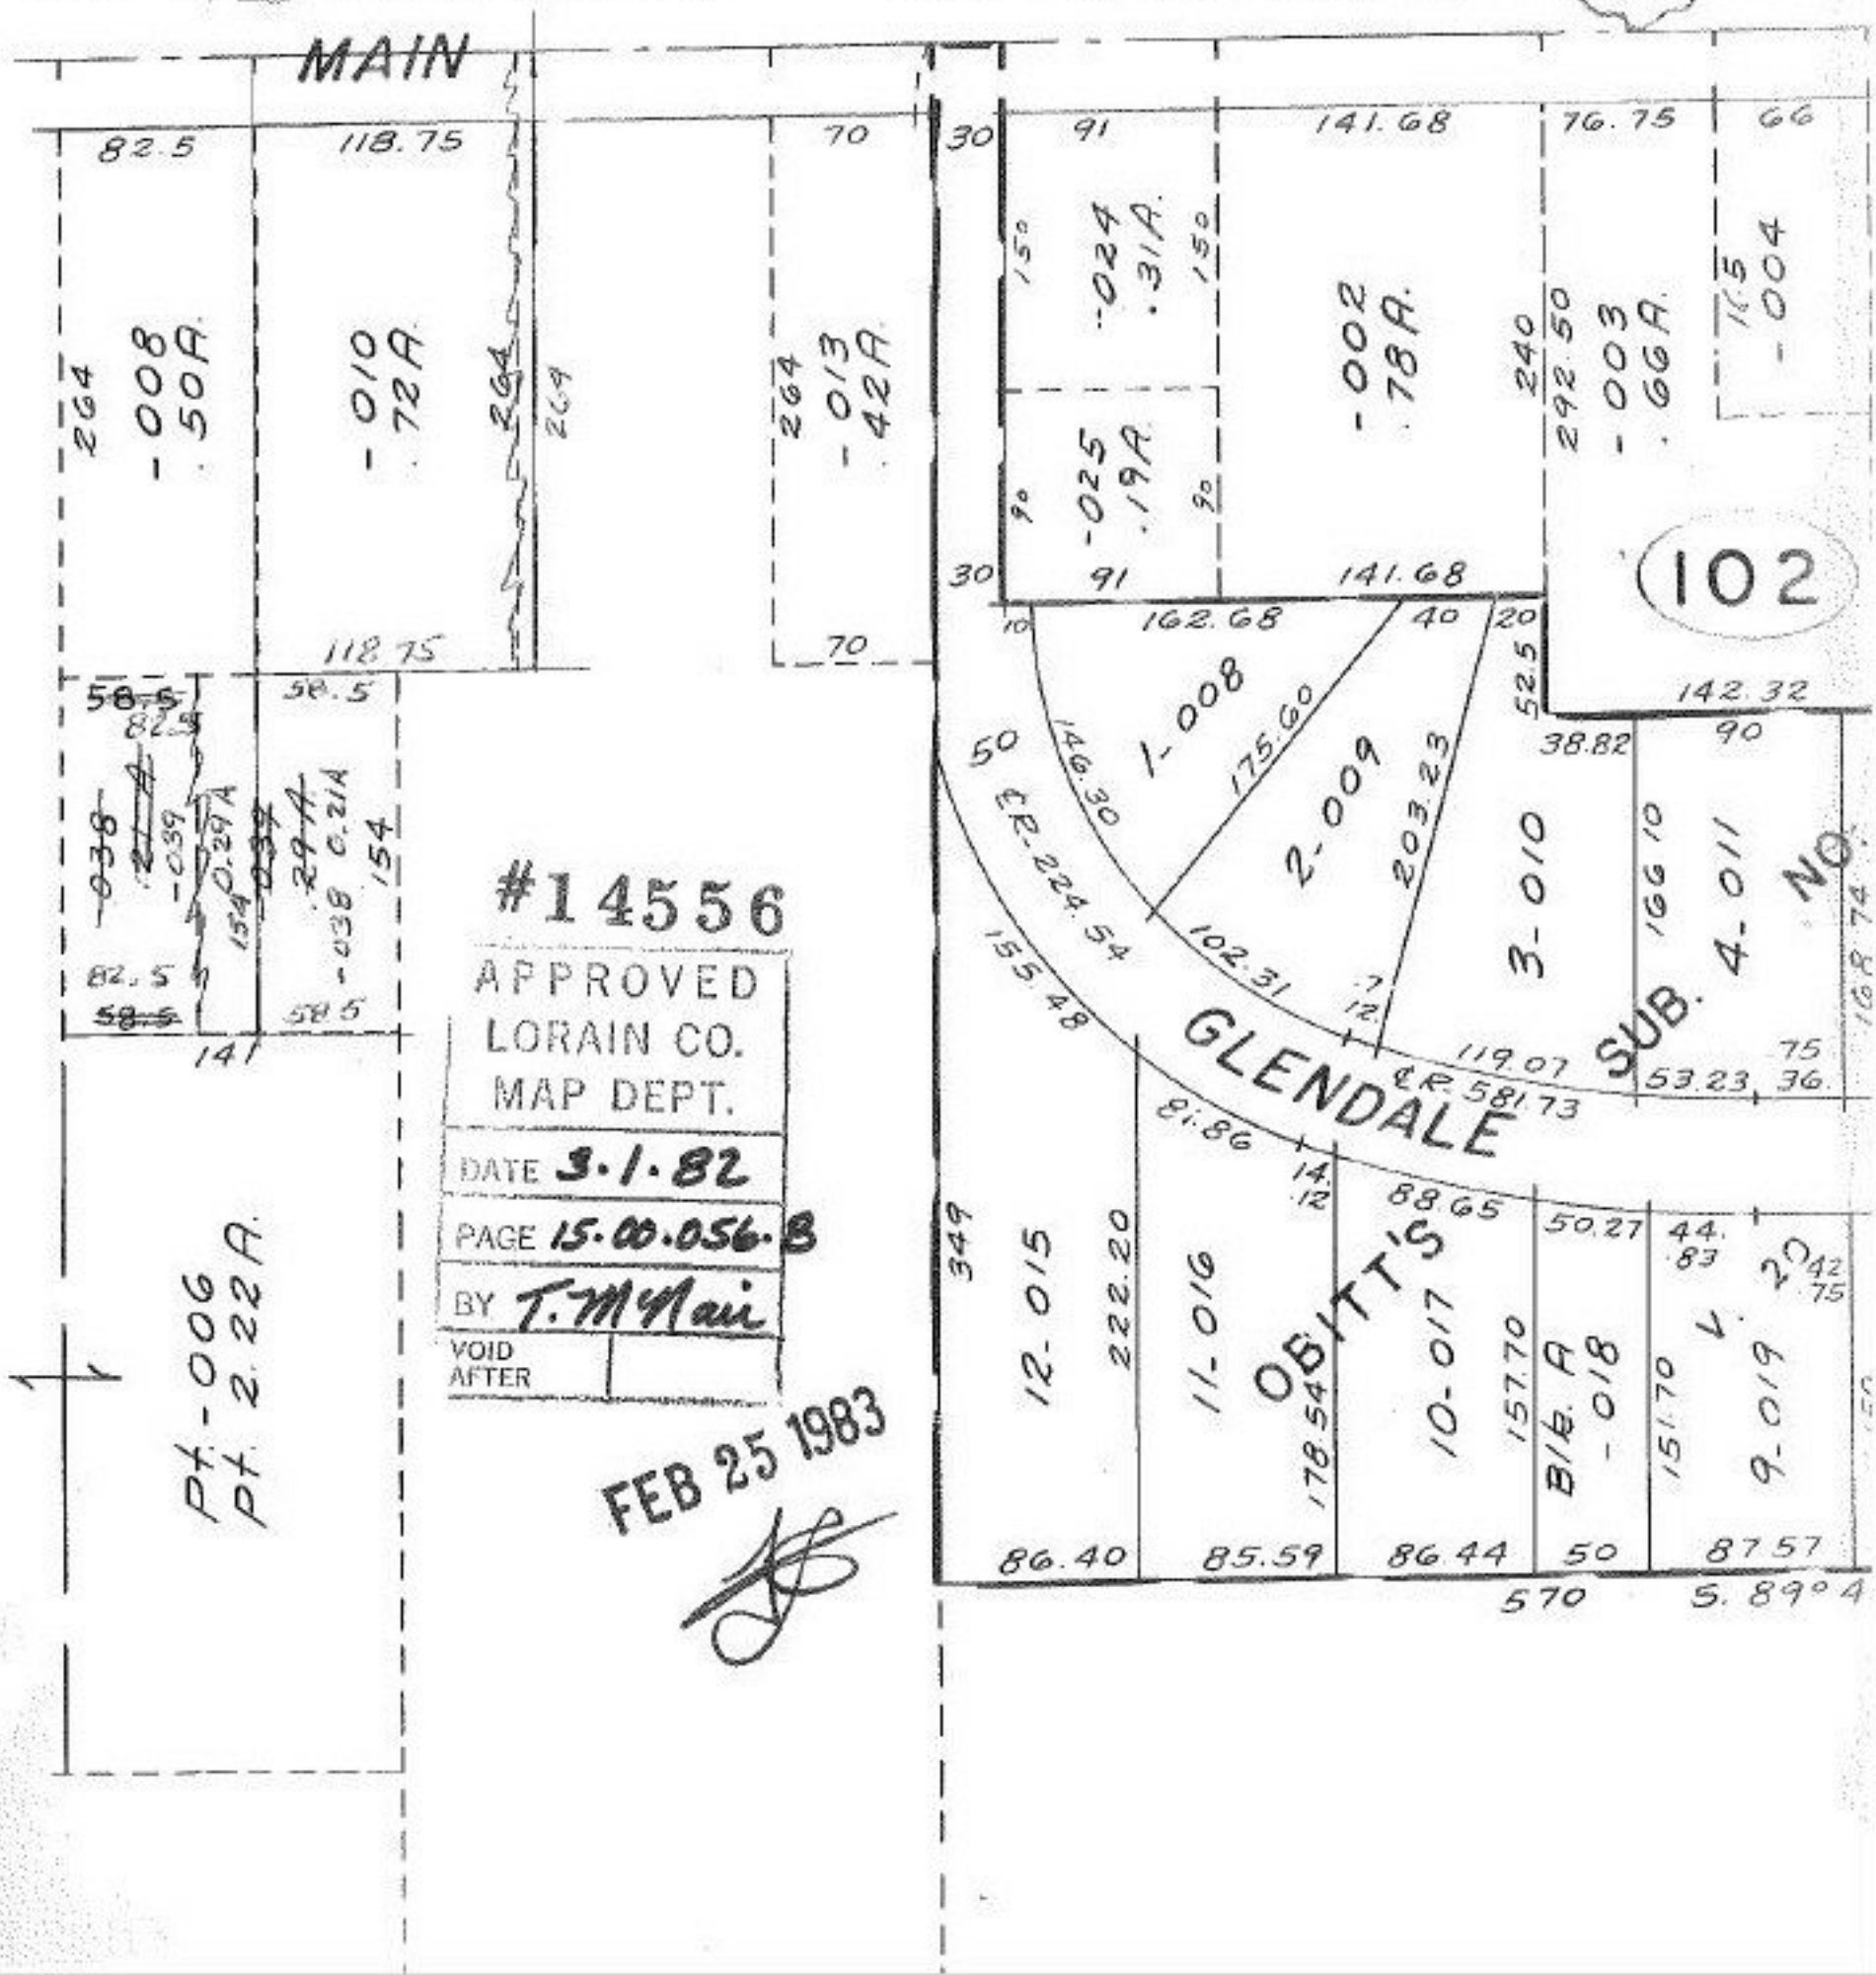

#14556

APPROVED
LORAIN CO.
MAP DEPT.

DATE 3.1.82

PAGE 15.00.056.B

BY T. McNair

VOID AFTER

FEB 25 1983