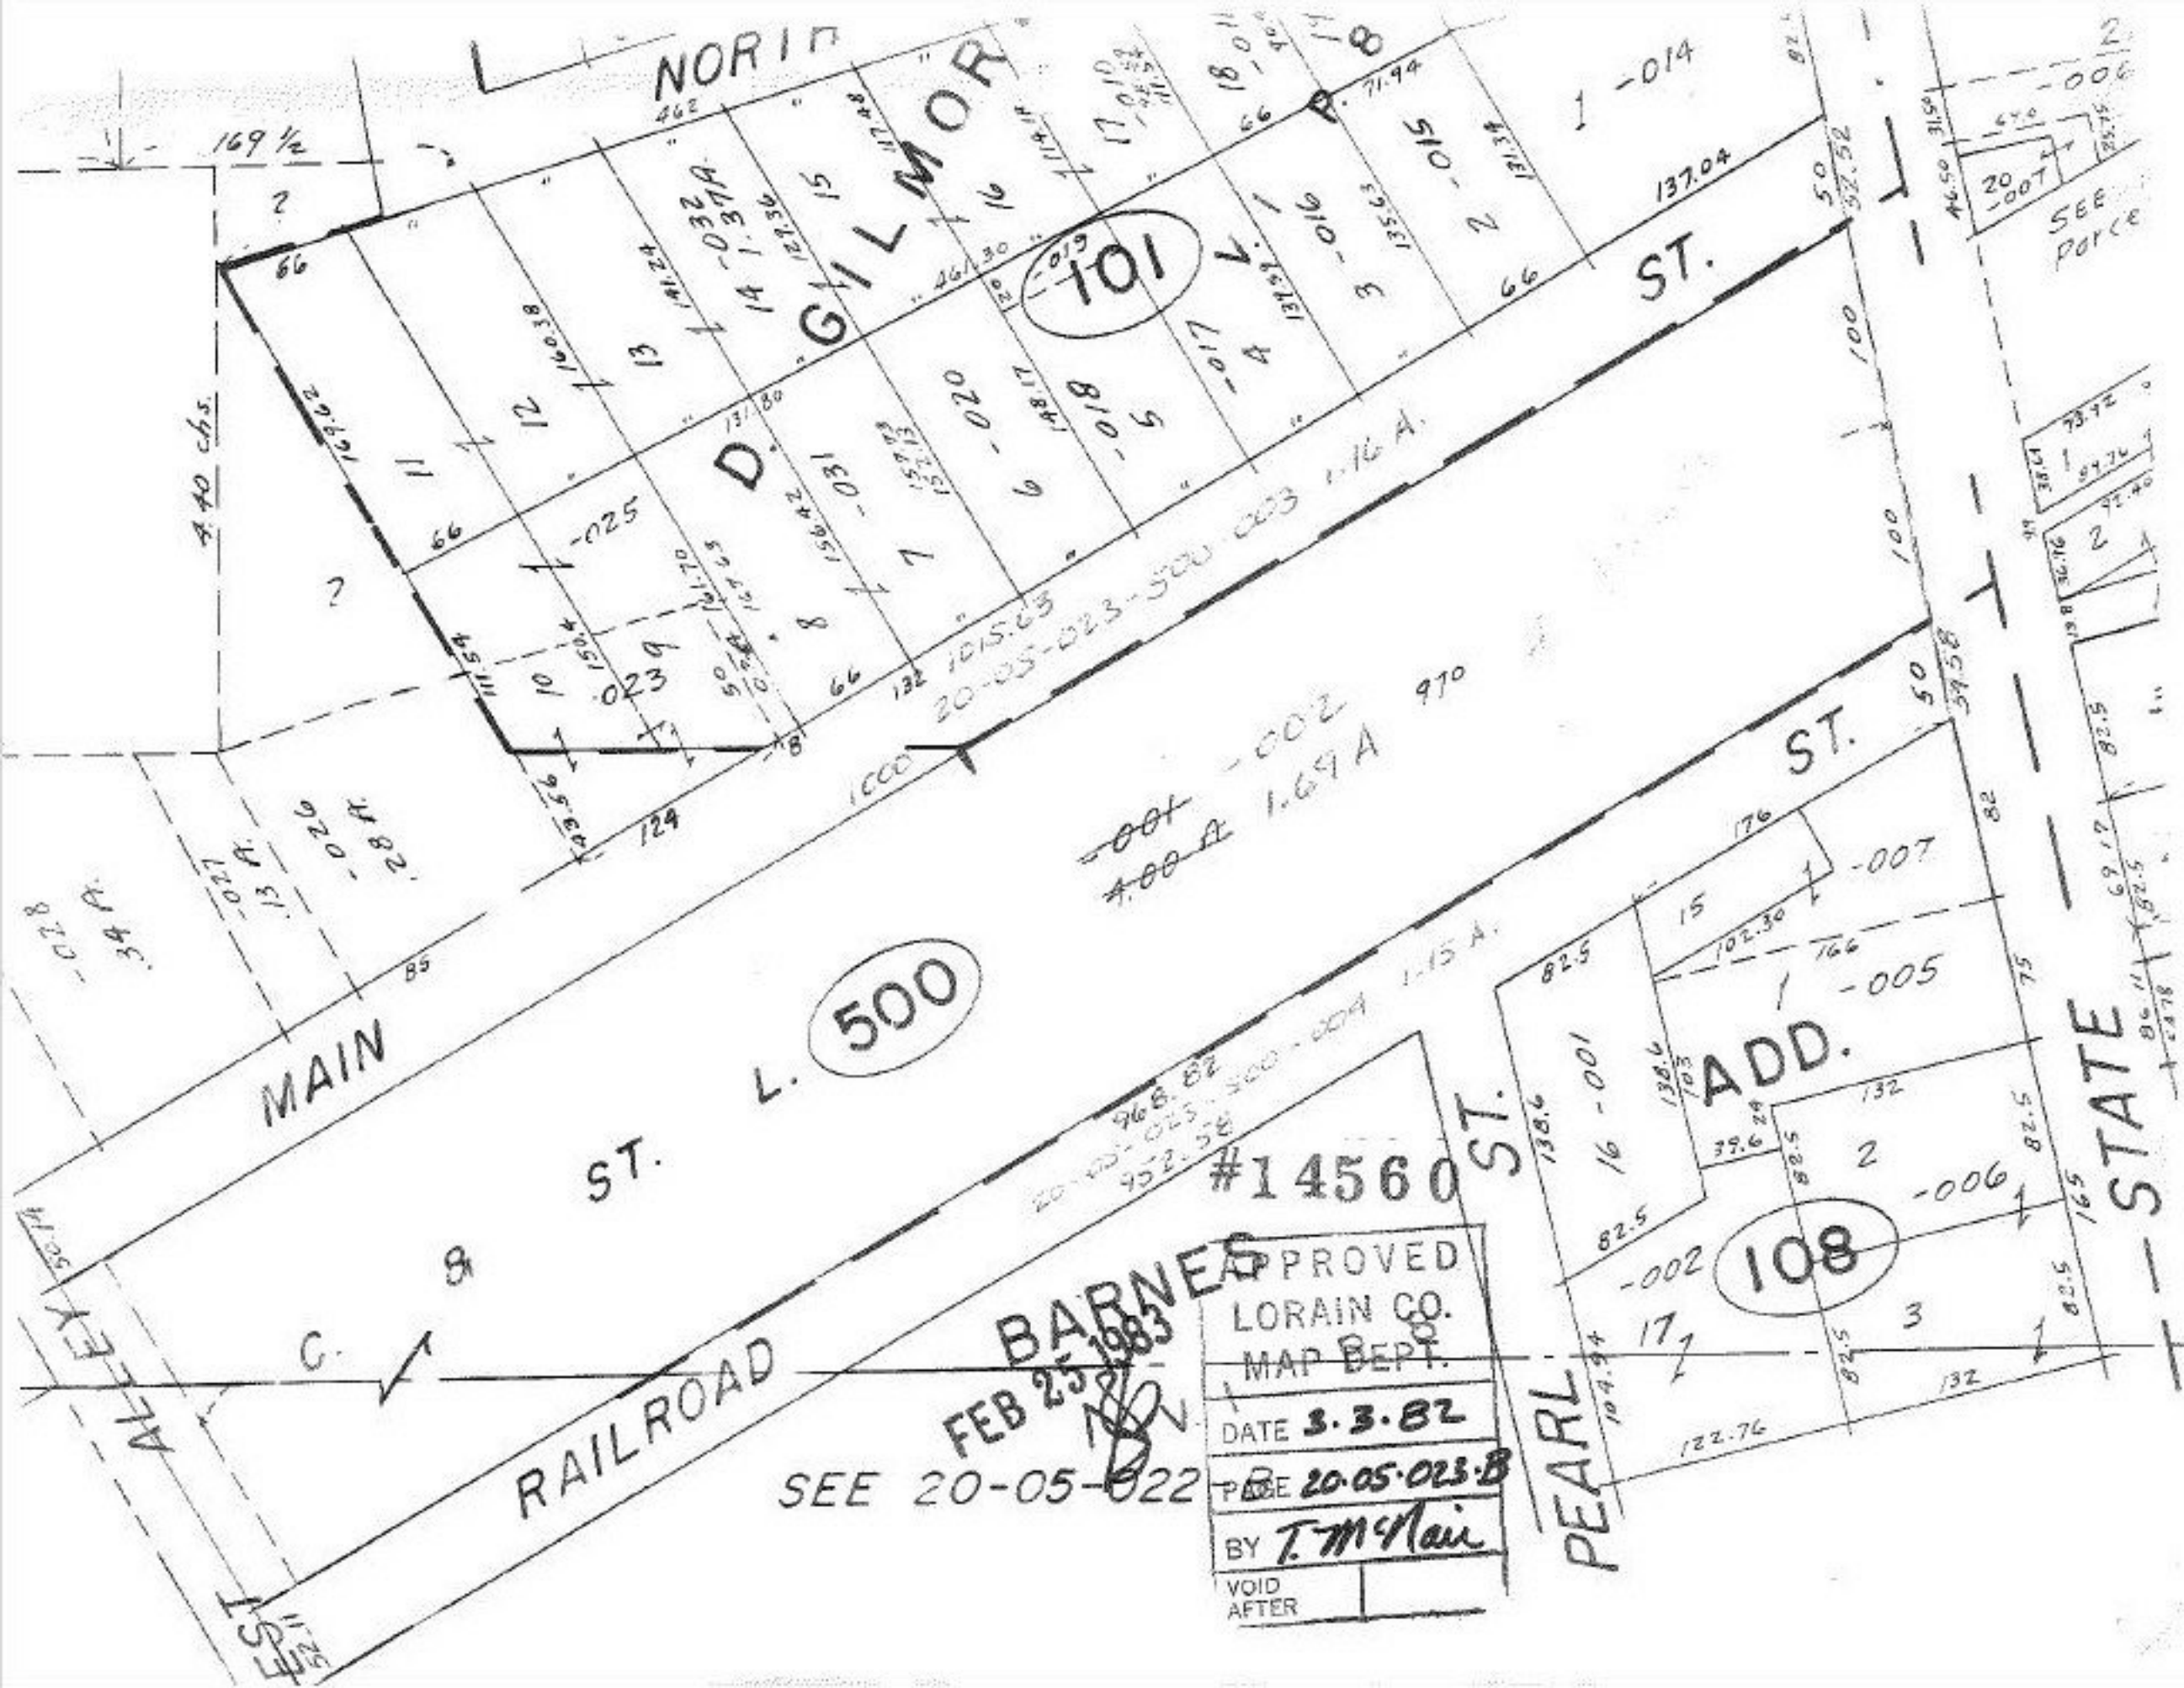
NORTH
GILMOR
D.
101
ST.
MAIN
ST.
L.
500
ST.
RAILROAD
BARNES
ALLEY
EST
PEARL
ST.
ADD.
108
STATE
SEE 20-05-022-B
#14560
APPROVED
LORAIN CO.
MAP DEPT.
DATE 3.3.82
PAGE 20.05.023.B
BY T. McNair
VOID AFTER
FEB 25 1983
20-05-023-500-003 1.16 A.
20-05-023-500-004 1.15 A.
20-05-023-500-002 1.69 A
4.00 A
1015.63
968.82
952.58
137.04
169 1/2
4.40 chs.
SEE Parce