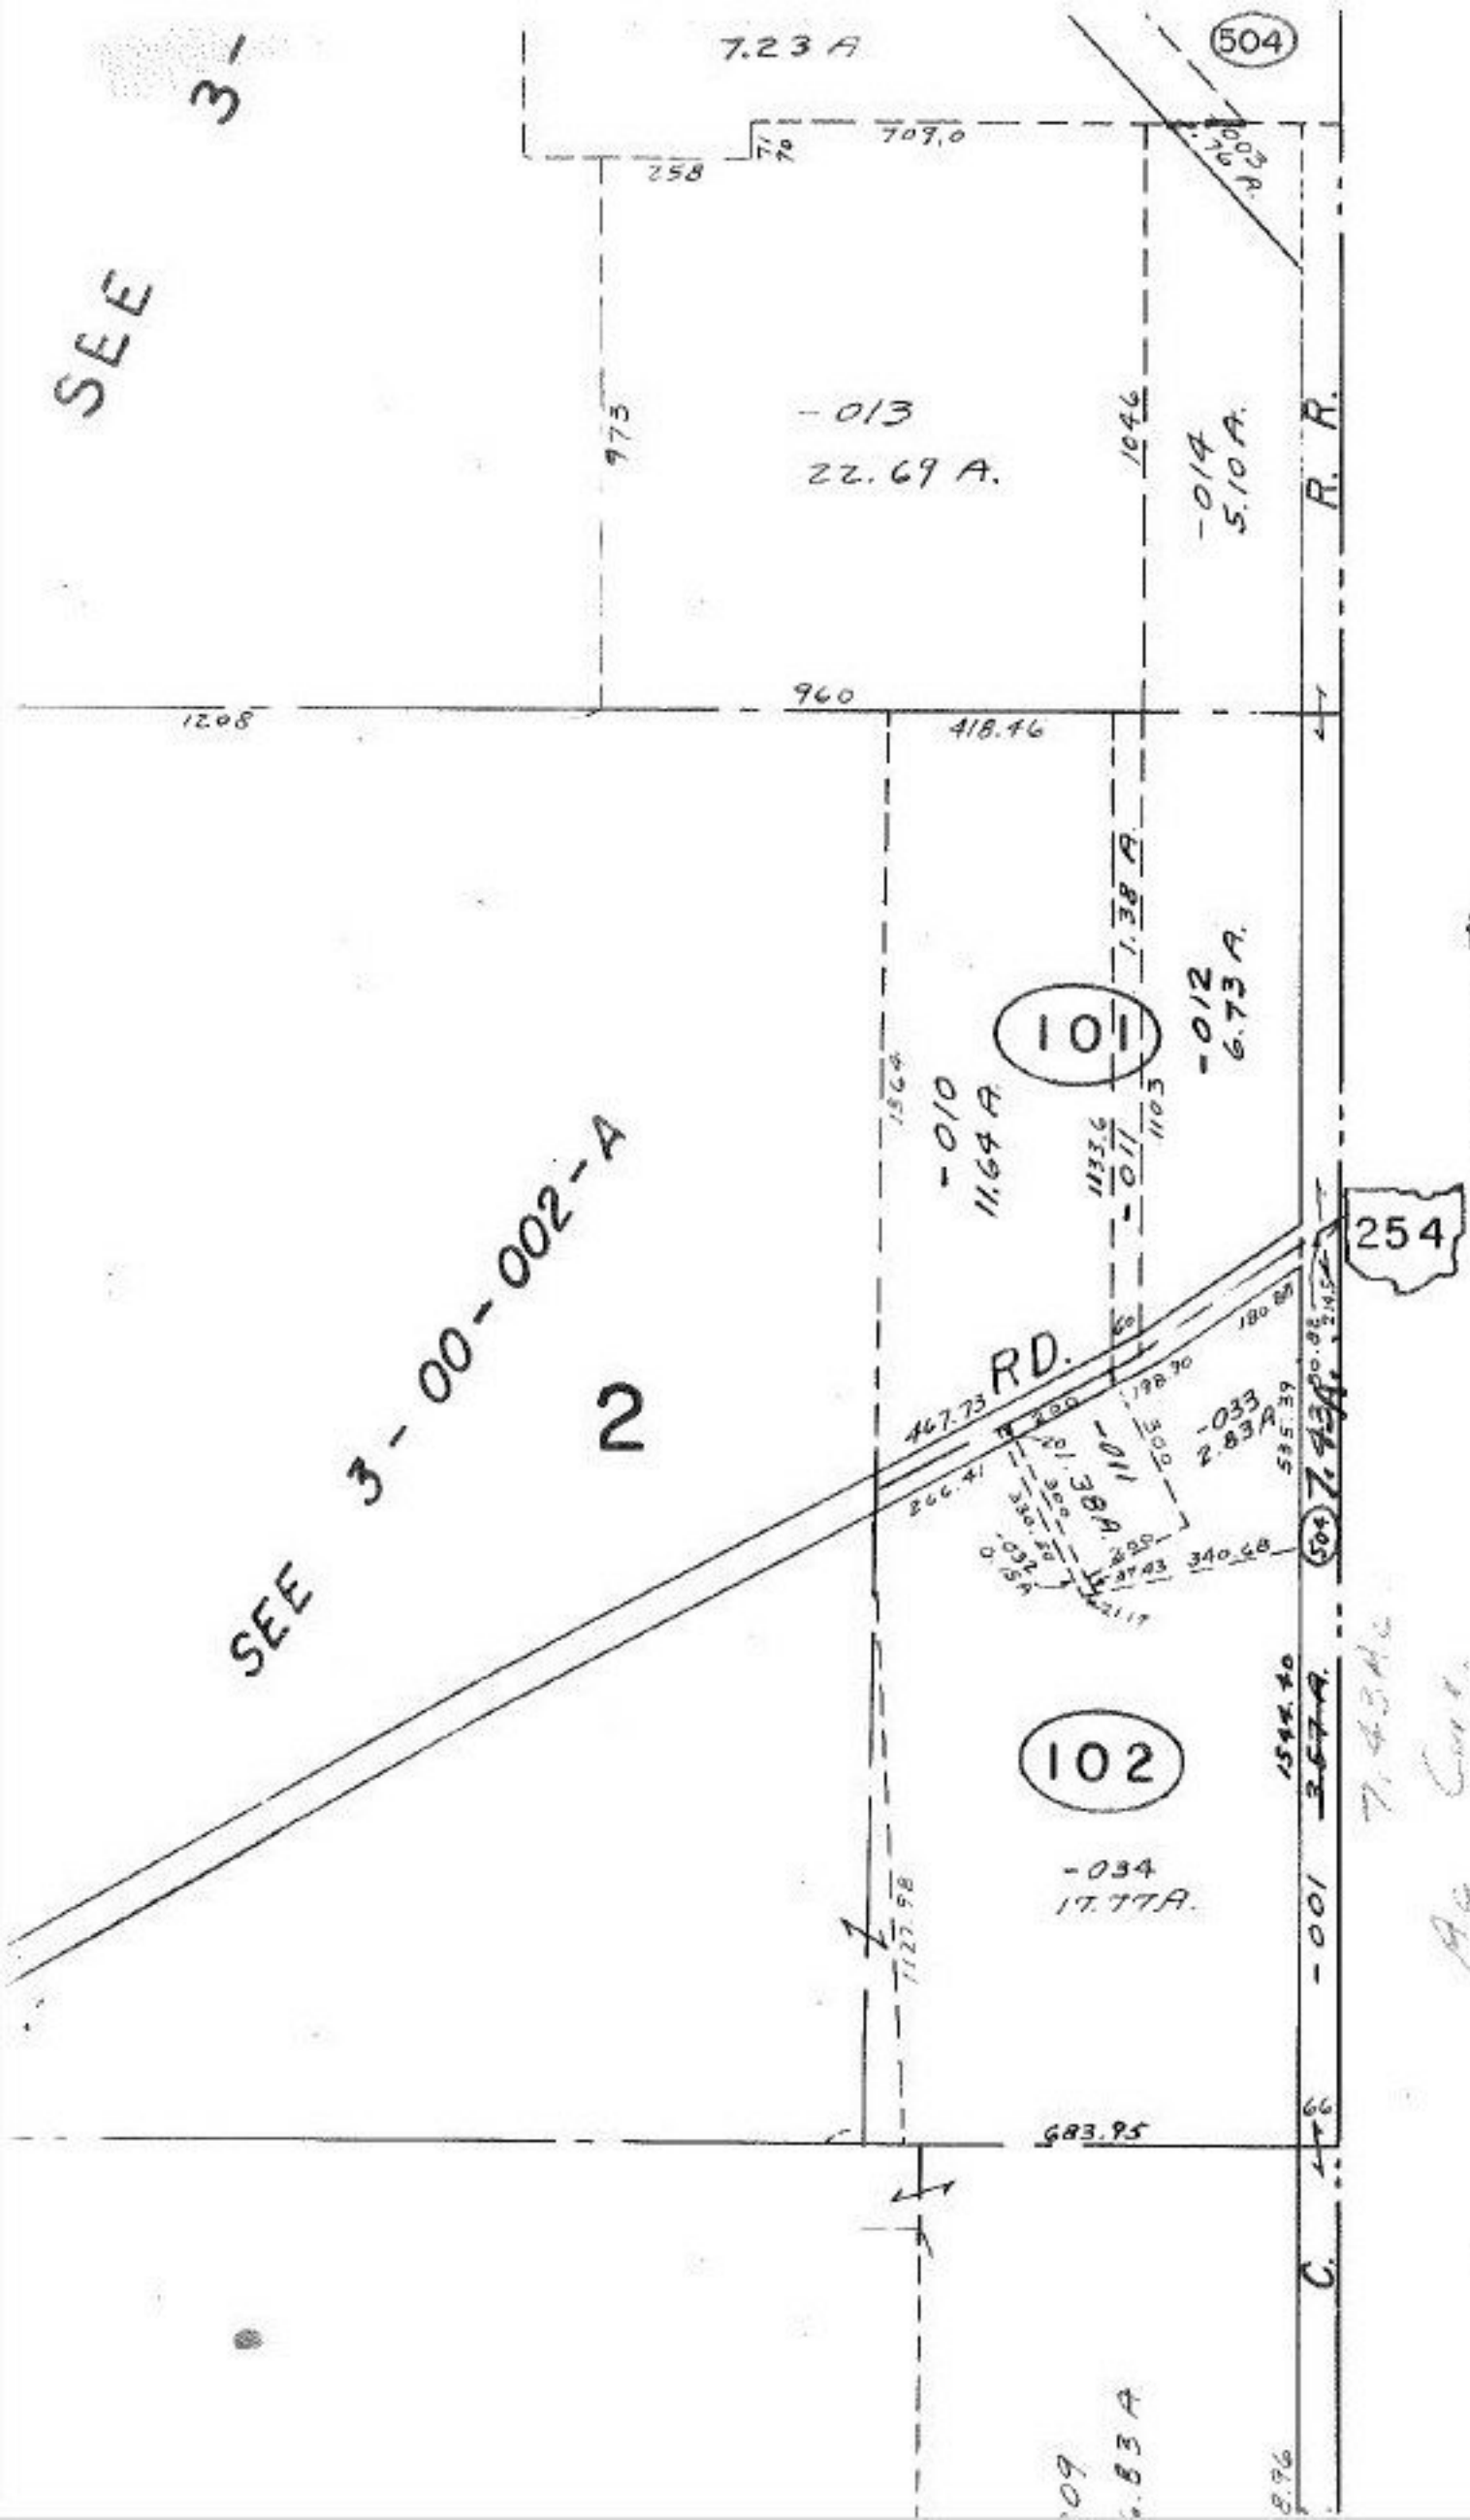

#14566

APPROVED
LORAIN CO.
MAP DEPT.

DATE 3-5-82

PAGE 3-L

BY [signature]

VOID AFTER 14566

1-14-83