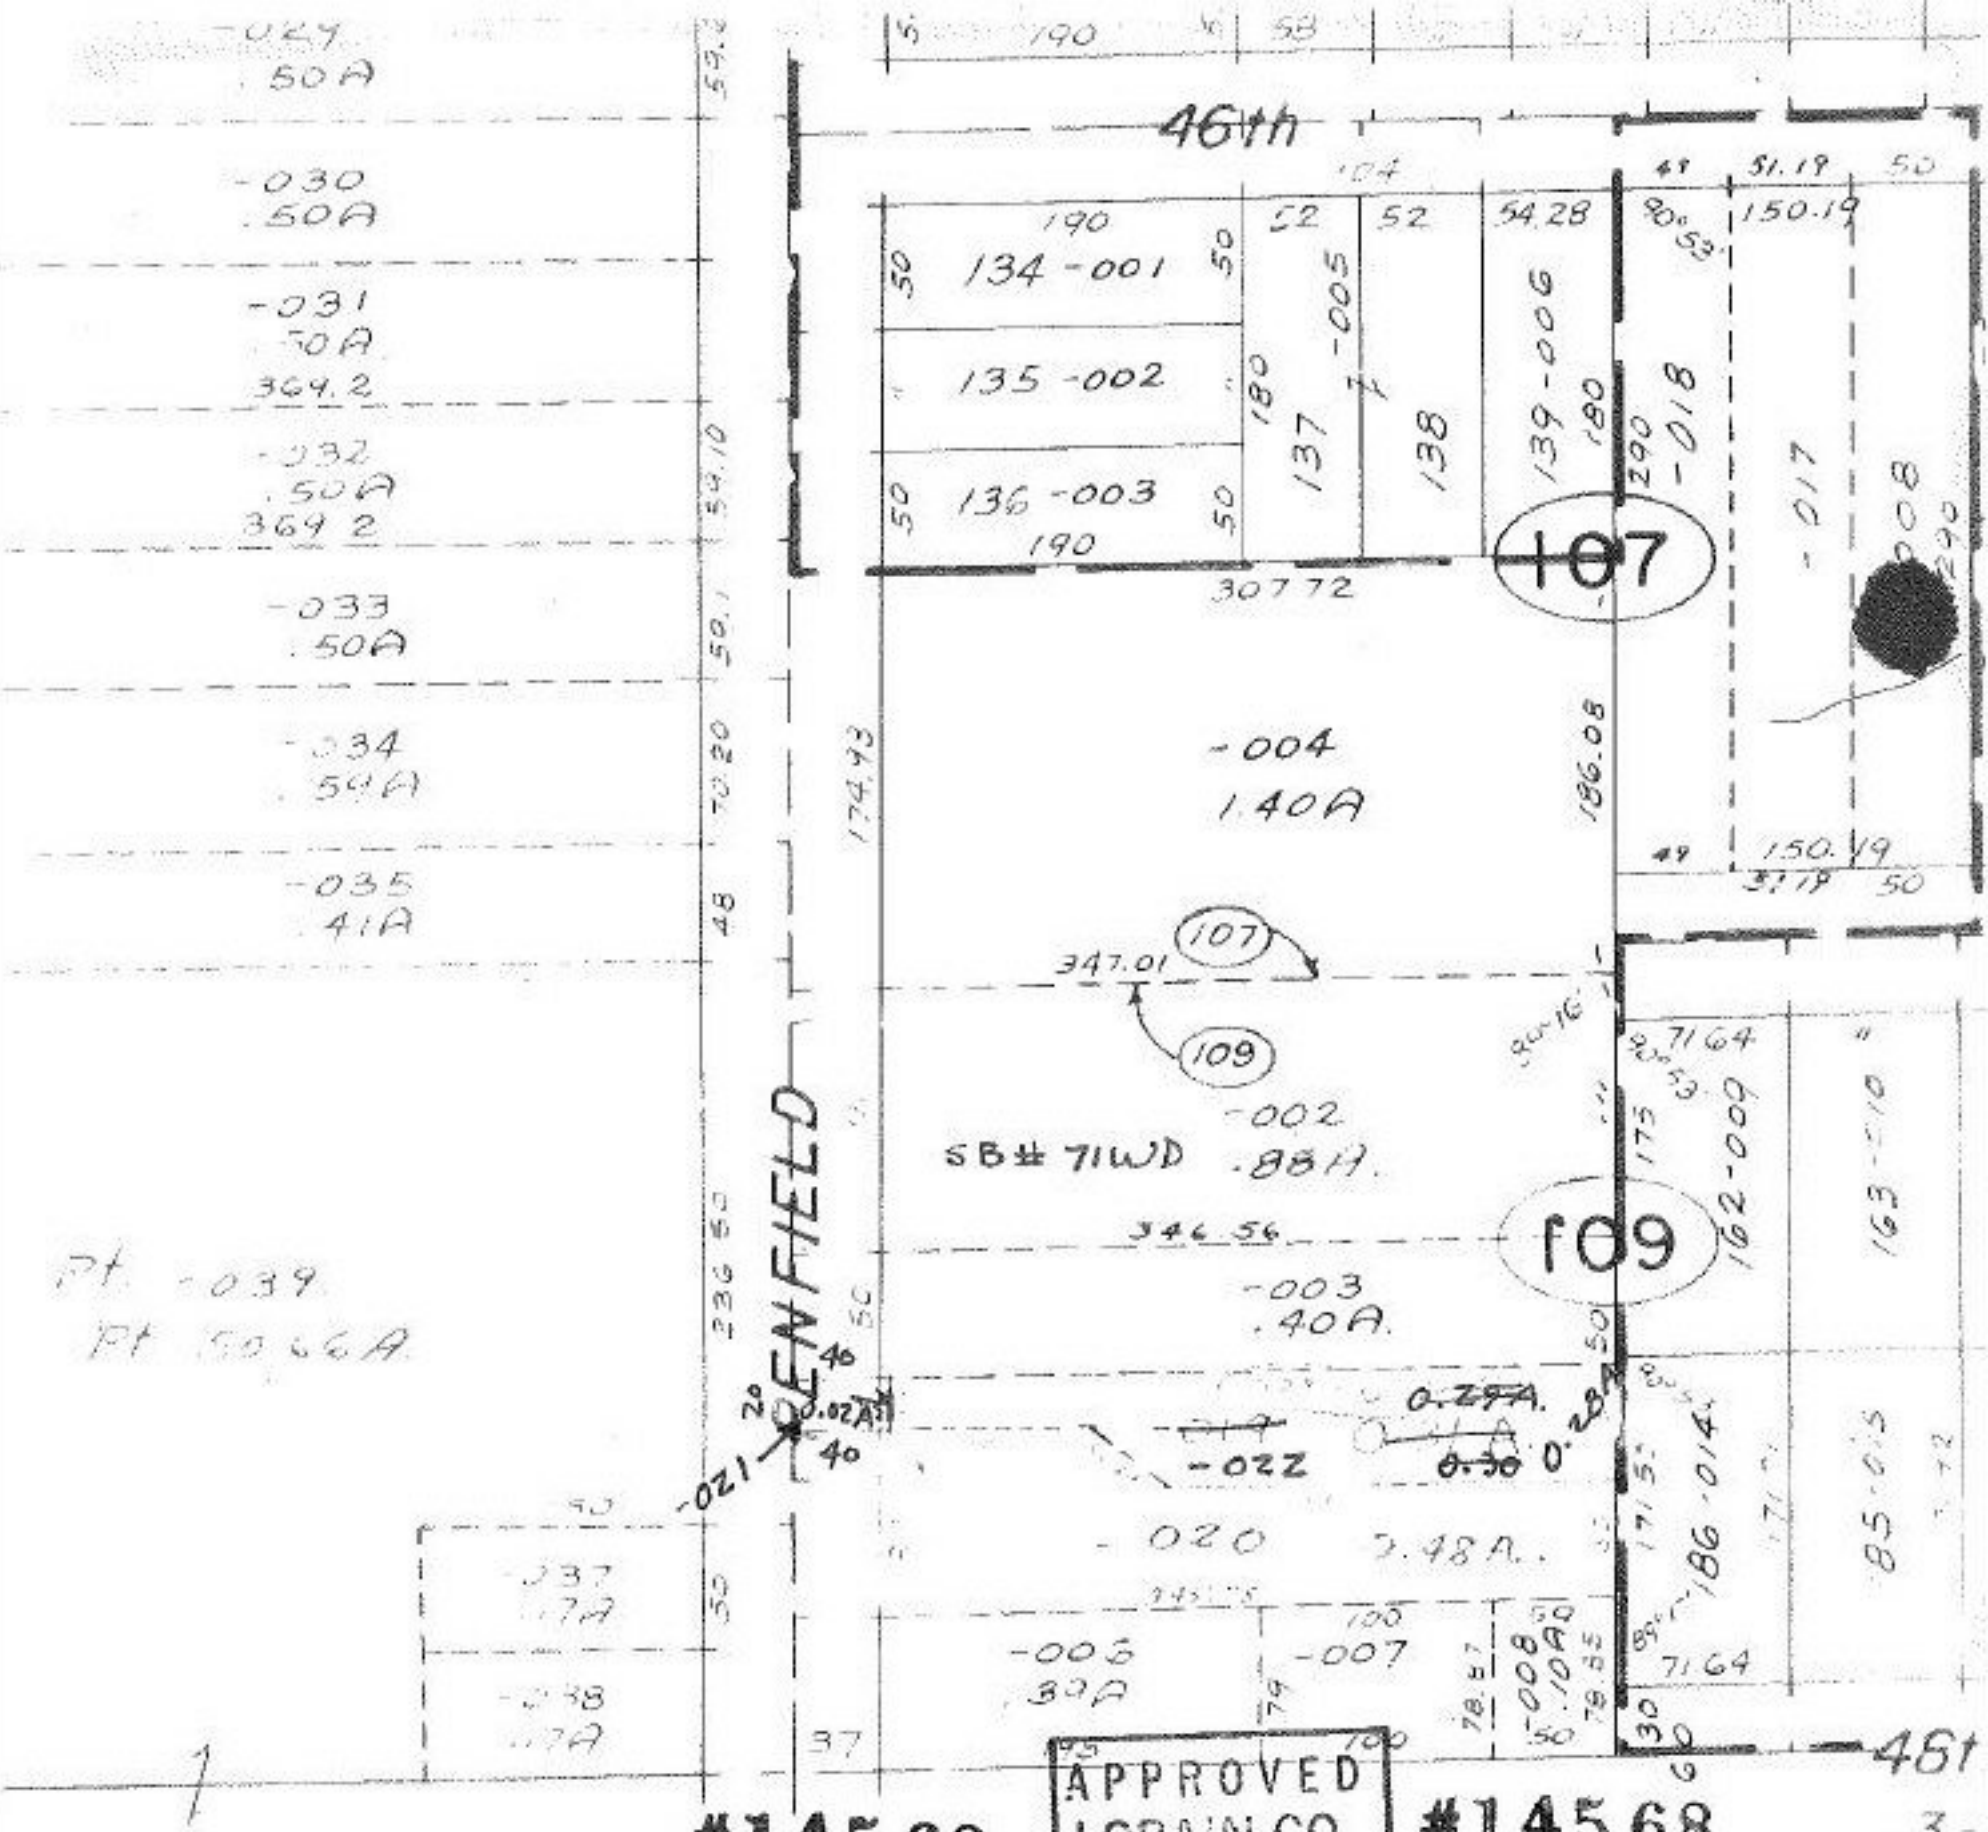

APPROVED
LORAIN CO.
MAP DEPT.
DATE 3-10-82
PAGE 3-00-108-A
BY [signature]
VOID AFTER 14568

SHEFFIELD TWP.

SCALE: 1" = 100'